



**REQUEST FOR
LETTER OF MAP REVISION
FOR
PARADISE VILLAGE**

**CLARK COUNTY, NEVADA
Nevada**

April 24, 2008

Prepared by:
Rome Consulting
3550 W. Cheyenne Avenue, Suite 110
North Las Vegas, Nevada 89032
Office: (702) 791-3900
Fax: (702) 631-3909

Prepared for:
Lapour Partners
5525 S. Decatur Boulevard, Suite 101
Las Vegas, Nevada 89119
Office: (775) 787-1125
Fax: (775) 787-1128



3550 W. Cheyenne Avenue, Suite 110
North Las Vegas • NV 89032
Office: 791-3900 • Fax: 631-3909

April 24, 2008
Job No. 07030-01

FEMA Depot
Attention: LOMR Depot
3601 Eisenhower Avenue
Alexandria, VA 22304-6425

Subject: Request for Letter of Map Revision for Paradise Village

Dear To Whom it May Concern:

Rome Consulting is pleased to provide one copy of the Request for Letter of Map Revision (LOMR) and As-Built information for the above-mentioned study. The project area is within the south half (S ½) of the southwest quarter (SW ¼) of Section 15, Township 21 South, Range 61 East, Mount Diablo Meridian, Clark County, Nevada. The site is located at the southwest corner of the intersection of Palos Verdes Street and Albert Avenue.

Rome Consulting is applying for a Letter of Map Revision from the Federal Emergency Management Agency (FEMA) on behalf of Lapour Partner's to revise FIRM 320003C2557E for Clark County, Nevada along the Flamingo Wash. Lapour Partner's had constructed a portion of the Flamingo Storm Drain Facility to convey the 100-year storm flows under Tony Bennett Way (Public Roadway).

This letter is to inform Clark County of the proposed decrease in the 1% annual chance water-surface elevations.

If you have any questions or comments, please do not hesitate to call this office.

Sincerely,

ROME CONSULTING

A handwritten signature in black ink, appearing to read "James M. Aquino", is written over the printed name and title.

James M. Aquino
Principal

Cc: sfc

**REQUEST FOR
LETTER OF MAP REVISION
FOR
PARADISE VILLAGE**

Job No. 07030-01
April 24, 2008

Prepared by:



3550 W. Cheyenne Avenue, Suite 110
North Las Vegas, Nevada 89032

Prepared for:

Lapour Partners
5525 S. Decatur Boulevard, Suite 101
Las Vegas, Nevada 89119
Office: (702) 222-3022
Fax: (702) 222-0961

2008 APR 30 AM 11:05

RFCD

April 24, 2008
Job No. 07030-01

FEMA
Attention: LOMR Depot
3601 Eisenhower Avenue
Alexandria, VA 22304-6425

Subject: Request for Letter of Map Revision for Paradise Village

Dear To Whom It May Concern:

With this letter, Rome Consulting and behalf of our client, Lapor Partner's, we are requesting that FEMA review the enclosed documents in support of a LOMR for Community Panel Number 320003C 2557E, effective date September 27, 2002 in Clark County, Nevada. Our request is based on the approved Conditional Letter of Map Revision (CLOMR) issued by FEMA on November 10, 2006 (Case Number 06-09-BC85R) in which the 100-year flood is contained in the as-built Flamingo storm drain system designed with the infrastructure of Paradise Village.

This request for a letter of map revision (LOMR) is intended to provide as-built technical information to remove the flood zone and/or a final determination on revising the effective FIRM. The site comprises of approximately 6 acres of a hotel and/or condominium development. This report will identify any existing/proposed drainage facilities that contribute storm water runoff to the site during a 100-year, 6-hour storm event. This study has been conducted in accordance with the criteria set forth by the Clark County Regional Flood Control District's (CCRFCD) *Hydrologic Criteria and Drainage Design Manual* and Clark County Development Services.

LOCATION

The project area is within the south half (S ½) of the southwest quarter (SW ¼) of Section 15, Township 21 South, Range 61 East, Mount Diablo Meridian, Clark County, Nevada. The site is located at the southwest corner of the intersection of Palos Verdes Street and Albert Avenue. See Appendix A, *Vicinity Map*, Figure 1.

FEMA FLOOD PLAIN

The Federal Emergency Management Agency (FEMA) Flood Insurance Rate Map (FIRM) Community-Panel Number 320003C2557E, dated September 27, 2002 (Reference #5), shall be revised per this LOMR request. An annotated FIRM Map is provided in the Appendix to indicate that the site is to be removed within a FEMA Zone 'A'. A Zone 'A' is described by FEMA as areas subject to flooding by the 1% annual chance flood with no base flood elevations determined. If the LOMR is approved, the project site shall be within a Zone 'X' and described

by FEMA areas outside of the 0.2% annual chance floodplain. An annotated map depicting the FEMA flood zones in the vicinity of the site is included in the appendix for this LOMR request. Appendix C, Revised Annotated FIRM Map, (Figure 3- FIRM Map).

EXISTING SITE SURROUNDING DESCRIPTION

The north half of project site currently exists as an apartment complex and the south half is located on a commercial development. The Flamingo Wash traverses across the site in the east-west direction. The site consists of approximately 6 acres of rough graded, future commercial/hotel, and Tony Bennett Way in a moderate hydrologic condition. The general area slopes to the east at approximately 1 percent. The surrounding areas are primarily a patchwork of residential multi-family developments to the north and commercial developments to the south, east, and west. A site description map depicting the site boundaries and the surrounding area is located in the appendix of this report. See Appendix B, *Site Description Map*, Figure 2.

HYDRAULIC MODELS

A WSPG model was completed on the pre-construction of the Flamingo Wash Storm Drain System prepared by Alpha Engineering and for the CLOMR. In order to compare it to the current condition or post-condition, modification to the design plans were implemented after the approval of the CLOMR Case No. 06-09-BC85R. The transition structure downstream (dual 12-ft x 9-ft RCB (Precast system) to a five (5): 12-ft x 8-ft RCB) has changed and elongated from 25-ft to 100-ft per the requested of Clark County Regional Flood Control District review. Therefore, the designs plans and the post-WSPG model have been revised according to the Regional's criteria. The WSPG model (pv-flam9) is the as-built model or post condition for the current built facility along Tony Bennett Way. The as-built plans with structural of the transition are provided in Appendix H, As-Built Civil Improvement Plans. A plan conformity letter signed and sealed by Stephen F. Crevoiserat, P.E. is provided in the appendix for compliance of the structure being built per approved plans.

In addition, the as-built (post condition) WSPG model utilizes the flow from the 2002 *CCRFC Master Plan Update* (3923 cfs). The flows are contained within the constructed channel system; however, the existing culverts at Palos Verdes Street have the capacity of the existing flow as referenced from the *CCRFC Master Plan Update*. The dual 12' x 9' RCBs has been constructed to convey the same flows. The as-built design meets CCRFC criteria. The HGL is contained within the storm drain and will outlet on the east side of Palos Verde Street under pressure. The upstream and downstream cross-sections were compared to the pre (CLOMR) condition and post condition (as-built) cross-sections in order to determine the impact to the upstream and downstream properties. The following Table 1 on the next page is a comparison of the cross-sections:

TABLE 1
PRE-CONSTRUCTION VS POST-CONSTRUCTION STORMDRAIN

PRE SECTIONS	POST SECTION	PRE W.S.E (ft)	POST W.S.E. (ft)	CHANGE IN WSE	PRE VELOCITY (ft/s)	POST VELOCITY (ft/s)
4013.55	4013.55	2060.29	2060.29	0.0	28.29	28.29
3615.6*	3615.6*	2055.76	2055.76	0.0	27.15	27.15
1000	1000	2038.90	2038.90	0.0	4.78	4.78
950	950	2037.19	2037.19	0.0	10.71	10.71
900	900	2036.27	2036.27	0.0	12.32	12.32
850	850	2036.65	2036.65	0.0	9.98	9.98
800	800	2035.29	2035.29	0.0	12.71	12.71
610*	610*	2029.73	2029.73	0.0	17.65	17.65

*FIS Tie-in Sections


CONCLUSIONS

The as-built analysis of the storm drain did not have any differences in elevations or channel velocities. Therefore, the storm flows in the channel is contained below surface and will not impact Paradise Village or its surroundings. Rome Consulting is requesting a final determination on revising the effective FIRM (see Figure 3) map.

I hope this further completes your concerns in your review. If you need any additional information, please do not hesitate to call me at my office.

Sincerely,

ROME CONSULTING

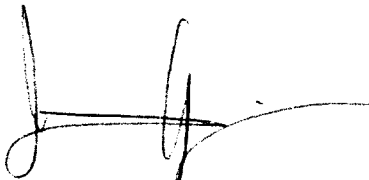

James M. Aquino
Principal


Stephen F. Crevoiserat, P.E.
President

APPENDICES

Appendix A	Vicinity Map
Appendix B	Site Description
Appendix C	Revised Annotated FIRM Map
Appendix D	Pre & Post Construction WSPGW Model
Appendix E	WSPGW Work Maps
Appendix F	FEMA Forms – MT2 Form 1, 2, 3
Appendix G	Approval Letters
Appendix H	As-Built Civil Improvement Plans
Appendix I	Data CD

APPENDIX A

HEC-1 Vicinity Map

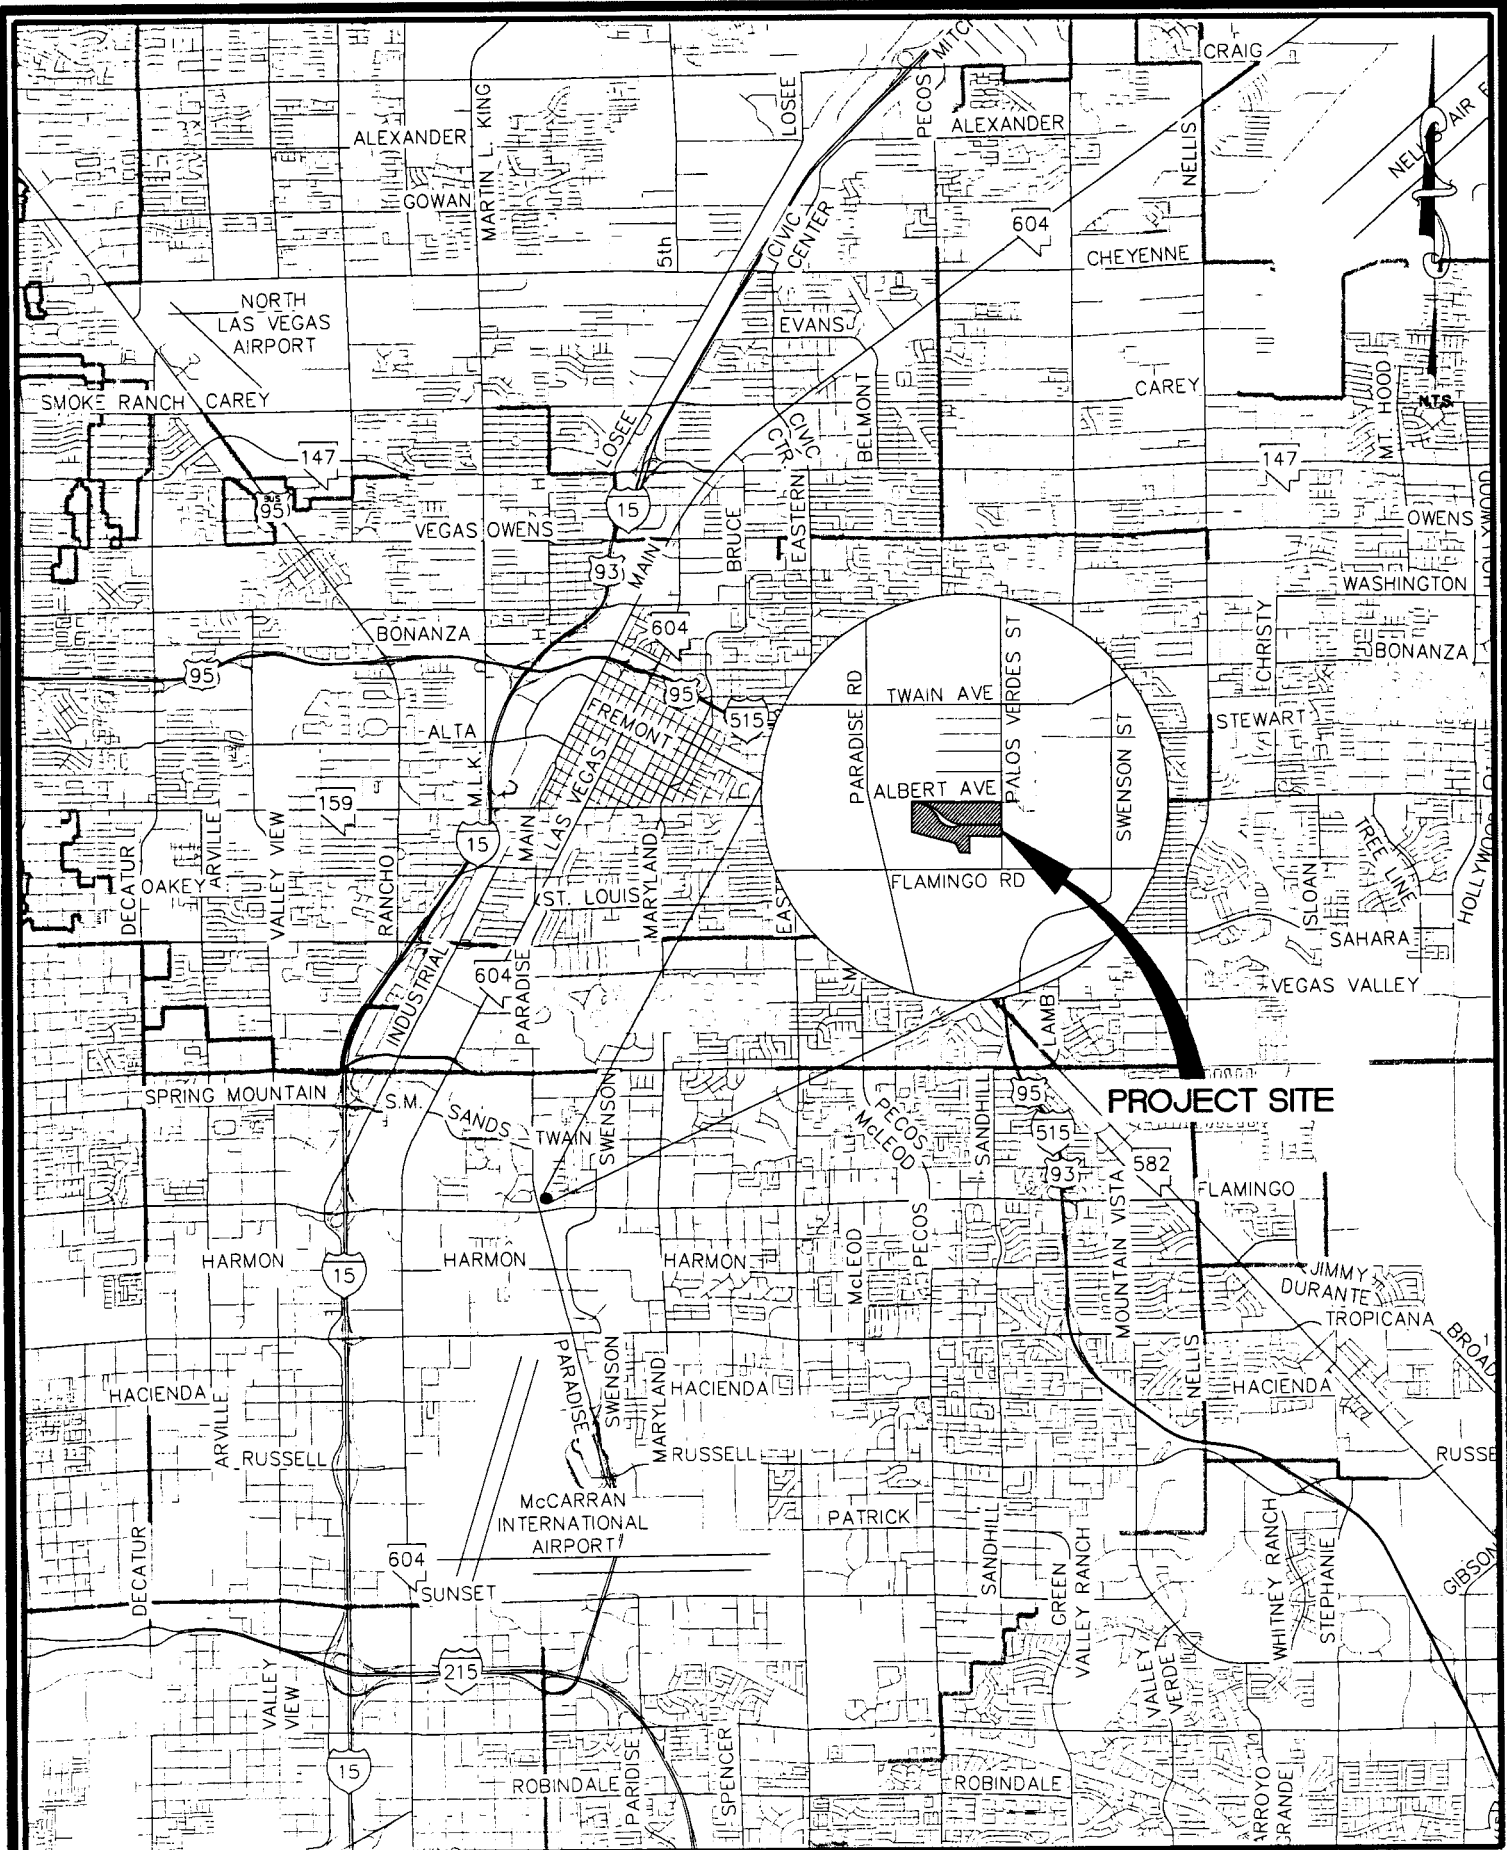

IROMEI
CONSULTING


3550 W. CHEYENNE AVE,
SUITE 110
NORTH LAS VEGAS, NV 89032
OFFICE: (702) 791-3900
FAX: (702) 631-3909

FIGURE 1

VICINITY MAP


APPENDIX B

Site Description

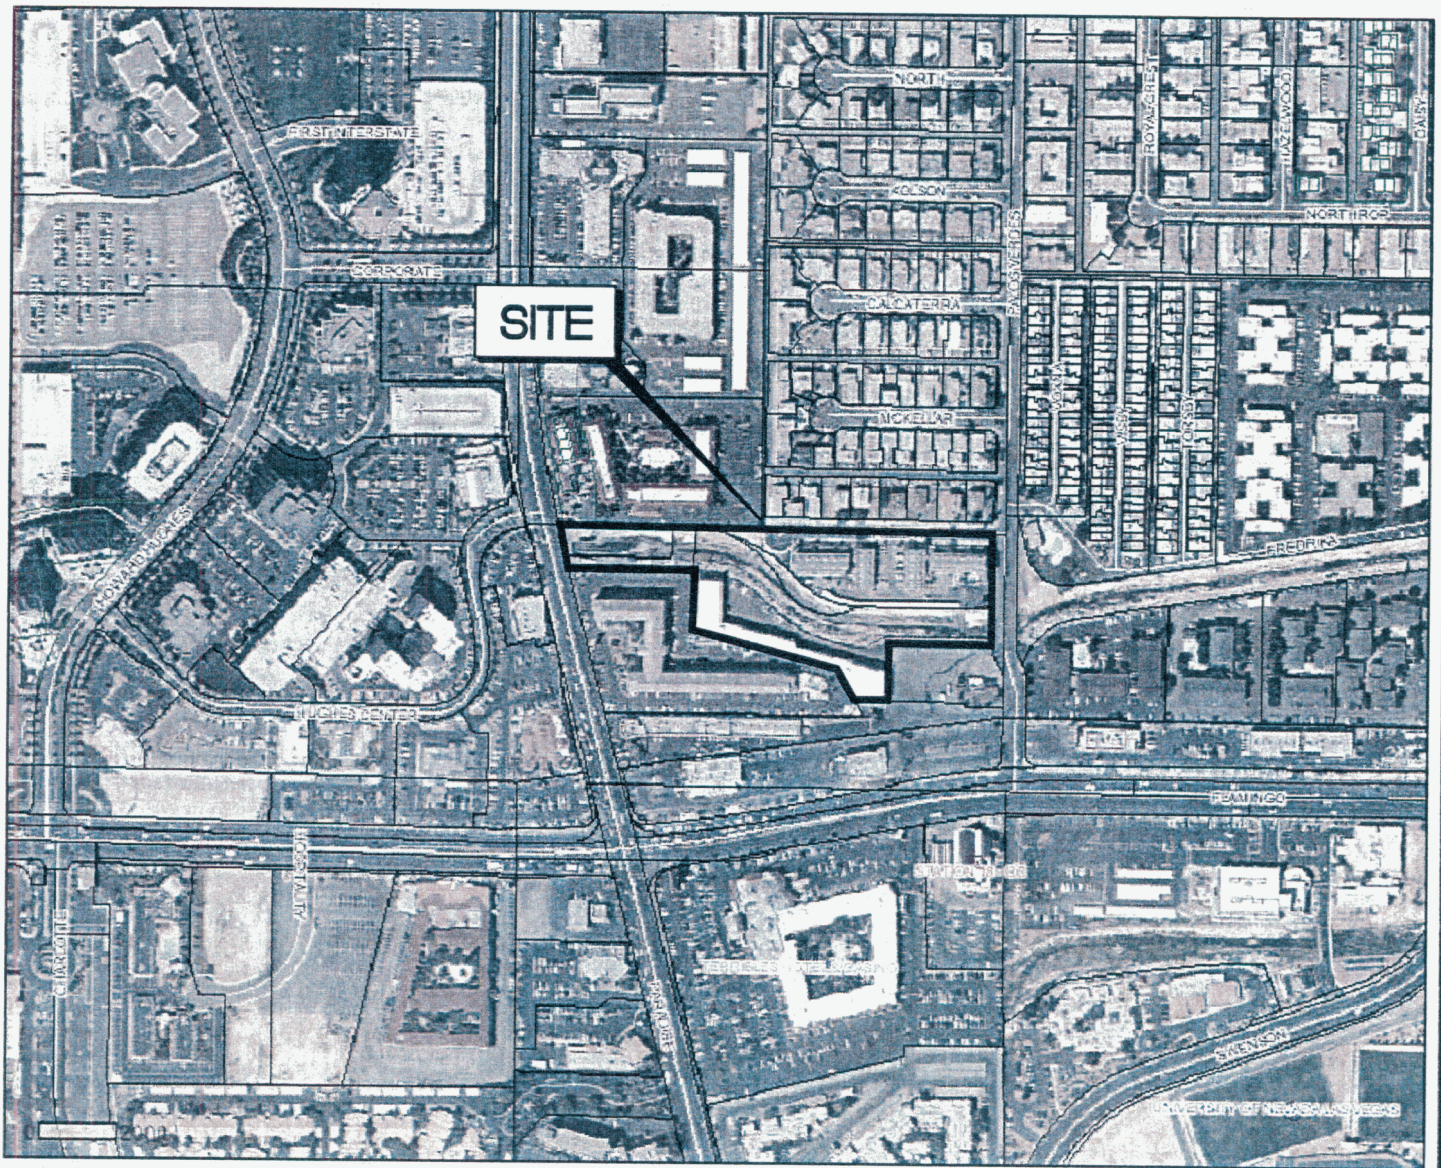

APPENDIX C

Revised Annotated FIRM Map

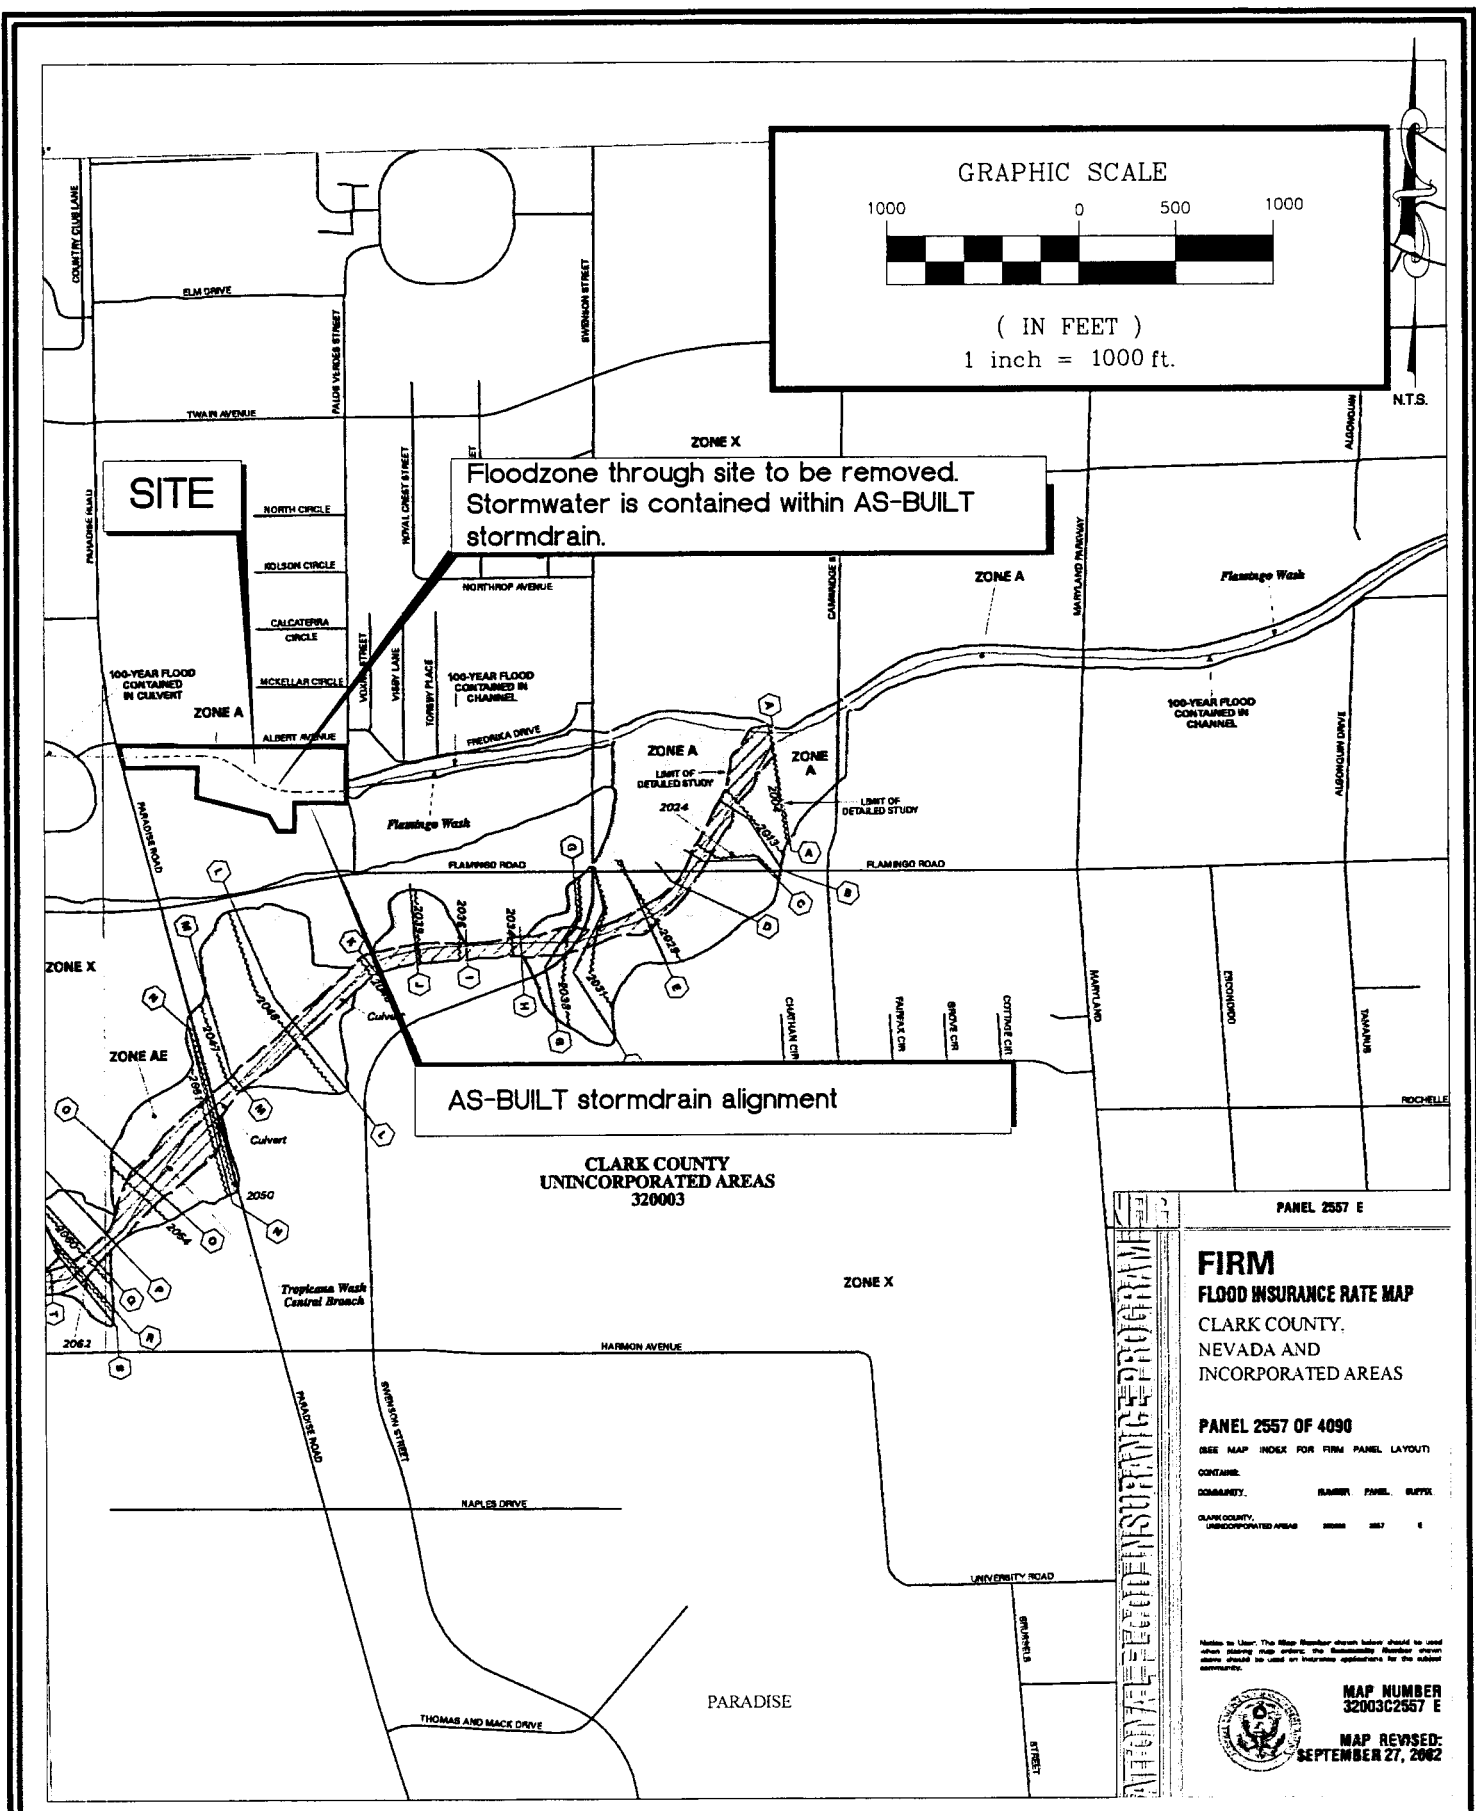

IROMEI CONSULTING

3550 W. CHEYENNE AVE,
SUITE 110
NORTH LAS VEGAS, NV 89032
OFFICE: (702) 791-3900
FAX: (702) 631-3909

FIGURE 3

FIRM MAP

APPENDIX D

PRE & POST CONSTRUCTION WSPGW Model

[illegible]

	U/S DATA	STATION	INVERT	SECT	N	RADIUS	ANGLE	ANG PT	MAN H
ELEMENT NO 21 IS A TRANSITION		3615.600	50.990	3	.013	.000	.000	.000	0
U/S DATA									
U/S DATA		4013.550	54.670	13	.015	.000	.000		
WARNING - ADJACENT SECTIONS ARE NOT IDENTICAL - SEE SECTION NUMBERS AND CHANNEL DEFINITIONS									
ELEMENT NO 22 IS A REACH									
U/S DATA									
U/S DATA		4415.160	59.950	15	.015	.000	.000	.000	0
ELEMENT NO 23 IS A SYSTEM HEADWORKS									
U/S DATA		4415.160	59.950	16					
						W S ELEV			
						65.470			

PRE-CONSTRUCTION WSPG MODEL

FILE: pv-flam7.WSW

W S P G W - CIVILDESIGN Version 14.06
Program Package Serial Number: 1754
WATER SURFACE PROFILE LISTING

PAGE 1

Date: 6-23-2006 Time: 9: 9:20

PARADISE VALLEY
BOX CULVERT ANALYSIS (FLAMINGO WASH.)

Station	Invert Elev	Depth (FT)	Water Elev	Q (CFS)	Vel (FPS)	Vel Head	Energy Grd.El.	Super Elev	Critical Depth	Flow Top Width	Height/Dia.-FT	Base Wt. or I.D.	SL	No Wth Prs/Pip
L/Elem	Ch Slope					SF Ave	HF	SE Dpth	Froude N	Norm Cp	"N"	X-Fall	ZR	Type Ch
195.000	14.220	3.793	23.003	3923.00	14.84	3.42	26.42	.00	9.62	63.38		10		0 .0
TRANS STR	.0245					.0199	7.86	8.79	1.28		.030			IR-OPEN
610.000	24.370	5.362	29.732	3923.00	17.65	4.84	34.57	.00	6.89	60.99		11		0 .0
TRANS STR	.0139					.0158	3.00	5.36	1.63		.030			IR-OPEN
800.000	27.000	8.292	35.292	3923.00	12.71	2.51	37.80	.00	8.29	61.52		14		0 .0
TRANS STR	.0000					.0061	.30	8.29	1.00		.030			IR-OPEN
950.000	27.000	9.653	36.653	3923.00	9.98	1.55	38.20	.00	8.09	64.39		5		0 .0
TRANS STR	.0000					.0053	.26	9.65	.71		.030			IR-OPEN
900.010	27.000	9.271	36.271	3923.00	12.32	2.36	33.63	.00	8.33	55.50		4		0 .0
TRANS STR	.0200					.0057	.29	9.27	.91		.030			IR-OPEN
950.010	28.000	9.189	37.189	3923.00	10.71	1.78	38.97	.00	8.16	63.81		7		0 .0
TRANS STR	.0088					.0027	.14	9.19	.79		.030			IR-OPEN
1000.000	28.440	10.456	38.896	3923.00	4.78	.35	39.25	.00	4.80	91.99		8		0 .0
WALL EXIT														
1000.000	28.440	10.456	38.896	3923.00	8.17	1.04	39.93	.00	5.10	63.00	8.000	63.000	.00	4 .8
293.620	.0031					.0016	.45	10.46	.52	5.21	.013	.00	.00	BOX
1280.620	29.300	10.042	39.342	3923.00	8.17	1.04	40.38	.00	5.10	63.00	8.000	63.000	.00	4 .8
TRANS STR	.0023							10.04	.52		.013	.00	.00	BOX

PARADISE VALLEY
BOX CULVERT ANALYSIS (FLAMINGO WASH)

Station	Invert Elev	Depth	Water Elev	Q CFS	Vel FPS	Vel Head	Energy Grd.El.	Super Elev	Critical Depth	Flow Top Width	Height/Dia.-FT	Base Wt I.D.	ZL	No Wth
L/Elem	Ch Slope				SF Ave	HF	SE Dpth	Froude N	Norm Dp	"N"	X-Fall	ZL	Type Ch	
1310.410	29.370	7.310	36.680	3923.00	22.13	7.60	44.28	.00	9.00	25.00	9.000	25.000	.00	1 .8
23.580	.0081				.0076	.18	7.31	1.46	7.14	.013	.00	.00	BOX	
1333.990	29.560	7.321	36.881	3923.00	22.10	7.58	44.46	1.15	9.00	25.00	9.000	25.000	.00	1 .8
167.000	.0072				.0076	1.29	8.47	1.46	7.44	.013	.00	.00	BOX	
1500.990	30.770	7.261	38.031	3923.00	22.28	7.71	45.74	.00	9.00	25.00	9.000	25.000	.00	1 .8
124.370	.0084				.0076	.94	7.26	1.48	7.02	.013	.00	.00	BOX	
1625.360	31.920	7.360	39.180	3923.00	21.98	7.50	46.68	1.33	9.00	25.00	9.000	25.000	.00	1 .8
71.650	.0084				.0074	.53	8.69	1.45	7.04	.013	.00	.00	BOX	
1697.010	32.420	7.432	39.852	3923.00	21.77	7.36	47.21	.00	9.00	25.00	9.000	25.000	.00	1 .8
146.940	.0085				.0070	1.02	7.43	1.43	6.99	.013	.00	.00	BOX	
1343.950	33.670	7.689	41.359	3923.00	21.04	6.97	48.23	.92	9.00	25.00	9.000	25.000	.00	1 .8
95.350	.0084				.0064	.61	8.60	1.36	7.03	.013	.00	.00	BOX	
1939.200	34.470	7.967	42.437	3923.00	20.31	6.40	48.84	.00	9.00	25.00	9.000	25.000	.00	1 .8
40.724	.0087				.0059	.24	7.97	1.29	6.92	.013	.00	.00	BOX	
1979.924	34.826	8.181	43.007	3923.00	19.77	6.07	49.08	.00	9.00	25.00	9.000	25.000	.00	1 .8
44.963	.0087				.0053	.24	8.18	1.24	6.92	.013	.00	.00	BOX	

WARNING - Flow depth near top of box conduit

PARADISE VALLEY

BOX CULVERT ANALYSIS (FLAMINGO WASH)

Station	Invert Elev	Depth	Water Elev	Q	Vel	Vel	Energy	Super	Critical	Flow Top	Height/	Base Wt.	No Wth
L/Elem	Ch Slope			(CFS)	(FPS)	Head	Grd.El.	Elev	Depth	Width	Dia.-FT or I.D.	ZL	/Prs/Pip
						SF Ave.	HF	SE Dpth	Froude N	Norm Op	"N"	X-Fall	ZR
2024.987	35.219	3.580	43.799	3923.00	13.55	5.52	49.32	.00	9.00	25.00	9.000	25.000	.00
20.713	.0087					.0050	.12	8.53	1.15	6.92	.013	.00	.00
WARNING - Flow depth near top of box conduit													
2045.600	35.400	3.000	44.400	3923.00	17.97	5.02	49.42	.00	9.00	25.00	9.000	25.000	.00
TRANS STR	.0085					.0030	.06	9.00	1.07		.013	.00	.00
2065.600	35.570	11.751	47.321	3923.00	12.97	2.61	49.93	.00	8.05	31.00	10.000	31.000	.00
132.202	.0082					.0030	.39	11.75	.73	5.71	.013	.00	.00
2197.802	36.654	11.052	47.706	3923.00	12.97	2.61	50.32	.00	8.05	31.00	10.000	31.000	.00
HYDRAULIC JUMP													
2197.802	36.654	5.293	41.937	3923.00	24.55	9.36	51.29	.00	8.05	31.00	10.000	31.000	.00
17.798	.0082					.0122	.18	5.28	1.91	5.71	.013	.00	.00
2215.600	36.800	5.271	42.071	3923.00	24.60	9.40	51.47	.00	8.05	31.00	10.000	31.000	.00
315.028	.0101					.0103	3.23	5.27	1.91	5.29	.013	.00	.00
2530.628	39.991	5.254	45.245	3923.00	24.68	9.46	54.71	.00	8.05	31.00	10.000	31.000	.00
761.907	.0101					.0110	8.42	5.25	1.92	5.29	.013	.00	.00
3292.535	47.708	5.019	52.717	3923.00	25.89	10.41	63.12	.00	8.05	31.00	10.000	31.000	.00
323.065	.0101					.0126	4.08	5.01	2.06	5.29	.013	.00	.00

PARADISE VALLEY
BOX CULVERT ANALYSIS (FLAMINGO WASH)

Station	Invert Elev	Depth (FT)	Water Elev	Q (CFS)	Vel (FPS)	Vel Head	Energy Grd.El.	Super Elev	Critical Depth	Flow Top	Height	Base Wt	No Wth
L/Elem	Ch Slope				SF Ave	HF	SS Dpth	Froude N	Norm Dp	"N"	X-Fall	ZR	Type Ch
3615.600	50.990	4.776	55.756	3923.00	27.15	11.45	67.20	.00	8.05	31.00	13.000	31.000	.00 1 .9
TRANS STR	.0093				.0167	6.63	4.78	2.22		.015	.00	.00	BOX
4013.550	54.670	5.619	60.289	3923.00	28.29	12.43	72.72	.00	9.26	29.14		16	0 .0
401.610	.0129				.0129	5.18	5.62	2.29	5.619	.015			IR-OPEN
4415.160	59.850	5.520	65.470	3923.00	28.29	12.43	77.90	.00	9.26	29.15		16	0 .0

PARADISE VALLEY

BOX CULVERT ANALYSIS (FLAMINGO WASH)

[illegible]

NOTES
1. GLOSSARY:
I = INVERT ELEVATION
C = CRITICAL DEPTH
W = WATER SURFACE ELEVATION
S = SUPER-ELEVATION
H = HEIGHT OF CHANNEL
E = ENERGY GRADE LINE
X = CURVES CROSSING OVER
B = BRIDGE ENTRANCE OR EXIT
Y = WALL ENTRANCE OR EXIT
2. STATIONS FOR POINTS AT A JUMP MAY NOT BE PLOTTED EXACTLY

POST-CONSTRUCTION WSPG MODEL

W S P G W - EDIT LISTING - Version 14.06

Date: 4-13-2007 Time:10:50:57

WATER SURFACE PROFILE - CHANNEL DEFINITION LISTING

PAGE 1

WARD CODE	SECT NO	CHN TYPE	NO OF PIER/PIP	AVE WIDTH	PIER DIAMETER	HEIGHT 1 WIDTH	BASE WIDTH	ZL	ZR	INV DROP	Y(1)	Y(2)	Y(3)	Y(4)	Y(5)	Y(6)	Y(7)	Y(8)	Y(9)	Y(10)
CD	1	3	4	.830	8.300	63.000	.000	.000	.00											
CD	2	3	1	.830	9.000	25.000	.000	.000	.00											
CD	3	3	1	.750	10.000	31.000	.000	.000	.00											
CD	6	3	3	.830	8.500	37.500	.000	.000	.00											
CD	9	3	3	.830	9.000	57.750	.000	.000	.00											
CD	12	3	0	.000	8.000	57.750	.000	.000	.00											
CD	17	2	0	.000	8.000	63.000			.00											
CD	18	3	2	.830	8.500	36.670	.000	.000	.00											
CD	4	5	0	.000																
CD	5	5	0	.000																
CD	7	5	0	.000																
CD	8	5	0	.000																
CD	10	5	0	.000																
CD	11	5	0	.000																
CD	13	5	0	.000																
CD	14	5	0	.000																
CD	16	5	0	.000																
CD	19	6	2	.830							29.26	29.26								
CD	20	6	2	.830							29.26	29.26								
CD	21	6	2	.830							29.11	29.11								
CD	22	6	0	.000																
CD	23	6	4	.830							29.07	29.07	29.07	29.07						

W S P G W - EDIT LISTING - Version 14.06

Date: 4-13-2007 Time: 10:50:57

WATER SURFACE PROFILE - CROSS SECTION POINT LISTING

PAGE 2

[illegible]

W S P G W

PAGE NO 1

WATER SURFACE PROFILE - TITLE CARD LISTING

HEADING LINE NO 1 IS -

PARADISE VALLEY

HEADING LINE NC 2 IS -

BOX CULVERT ANALYSIS (FLAMINGO WASH)

HEADING LINE NO 3 IS -

ADDED SECTIONS FOR CCRFCD REQUEST (ABBY:

PAGE NO 2

WATER SURFACE PROFILE - ELEMENT CARD LISTING

ELEMENT NO	1	IS A	SYSTEM OUTLET	U/S DATA	STATION	195.000	INVERT	SECT	10	N	5 ELEV	14.220	RADIUS	ANGLE
ELEMENT NO	2	IS A	TRANSITION	U/S DATA	STATION	610.000	INVERT	SECT	11	N	.030		RADIUS	ANGLE
ELEMENT NO	3	IS A	TRANSITION	U/S DATA	STATION	900.000	INVERT	SECT	14	N	.030		RADIUS	ANGLE
ELEMENT NO	4	IS A	TRANSITION	U/S DATA	STATION	350.300	INVERT	SECT	5	N	.030		RADIUS	ANGLE
THE ABOVE ELEMENT CONTAINED AN INVERT ELEV WHICH WAS NOT GREATER THAN THE PREVIOUS INVERT ELEV -WARNING														
ELEMENT NO	5	IS A	TRANSITION	U/S DATA	STATION	900.913	INVERT	SECT	4	N	.030		RADIUS	ANGLE
THE ABOVE ELEMENT CONTAINED AN INVERT ELEV WHICH WAS NOT GREATER THAN THE PREVIOUS INVERT ELEV -WARNING														
ELEMENT NO	6	IS A	TRANSITION	U/S DATA	STATION	950.310	INVERT	SECT	7	N	.030		RADIUS	ANGLE
ELEMENT NO	7	IS A	TRANSITION	U/S DATA	STATION	999.398	INVERT	SECT	8	N	.030		RADIUS	ANGLE
WARNING - ADJACENT SECTIONS ARE NOT IDENTICAL - SEE SECTION NUMBERS AND CHANNEL DEFINITIONS														
ELEMENT NO	8	IS A	REACH	U/S DATA	STATION	1000.000	INVERT	SECT	17	N	.030		RADIUS	ANGLE
ELEMENT NO	9	IS A	BRIDGE EXIT	U/S DATA	STATION	1000.000	INVERT	SECT	1	N	.030		RADIUS	ANGLE
ELEMENT NO	10	IS A	REACH	U/S DATA	STATION	1210.410	INVERT	SECT	1	N	.013		RADIUS	ANGLE
ELEMENT NO	11	IS A	TRANSITION	U/S DATA	STATION	1223.160	INVERT	SECT	9	N	.013		RADIUS	ANGLE
ELEMENT NO	12	IS A	TRANSITION	U/S DATA	STATION	1224.160	INVERT	SECT	12	N	.013		RADIUS	ANGLE
THE ABOVE ELEMENT CONTAINED AN INVERT ELEV WHICH WAS NOT GREATER THAN THE PREVIOUS INVERT ELEV -WARNING														

THE ABOVE ELEMENT CONTAINED AN INVERT ELEV WHICH WAS NOT GREATER THAN THE PREVIOUS INVERT ELEV -WARNING

ELEMENT NO 13 IS A BRIDGE EXIT
 U/S DATA STATION INVERT SECT
 1224.160 29.110 9

W S P G W

PAGE NO 3

WATER SURFACE PROFILE - ELEMENT CARD LISTING

ELEMENT NO	IS A	U/S DATA	STATION	INVERT	SECT		RADIUS	ANGLE	ANG PT	MAN H
ELEMENT NO 14	IS A TRANSITION	U/S DATA	1274.240	29.260	6	N .013	.000	.000		
ELEMENT NO 15	IS A BRIDGE ENTRANCE	U/S DATA	1274.240	29.260	6	FP 1.000				
ELEMENT NO 16	IS A TRANSITION	U/S DATA	1310.410	29.370	2	N .013	.000	.000		
ELEMENT NO 17	IS A REACH	U/S DATA	1333.990	29.560	2	N .013	.000	.000	.000	0
ELEMENT NO 18	IS A REACH	U/S DATA	1500.990	30.770	2	N .013	318.947	30.000	.000	0
ELEMENT NO 19	IS A REACH	U/S DATA	1641.110	32.090	2	N .013	.000	.000	.000	0
ELEMENT NO 20	IS A REACH	U/S DATA	1716.130	32.700	2	N .013	286.555	15.000	.000	0
ELEMENT NO 21	IS A REACH	U/S DATA	1829.530	33.690	2	N .013	.000	.000	.000	0
ELEMENT NO 22	IS A REACH	U/S DATA	1929.360	34.540	2	N .013	381.322	15.000	.000	0
ELEMENT NO 23	IS A REACH	U/S DATA	2046.040	35.400	2	N .013	.000	.000	.000	0
ELEMENT NO 24	IS A TRANSITION	U/S DATA	2066.040	35.570	3	N .013	.000	.000		
ELEMENT NO 25	IS A REACH	U/S DATA	2215.800	36.800	3	N .013	.000	.000	.000	0
ELEMENT NO 26	IS A REACH	U/S DATA	3615.600	50.980	3	N .013	.000	.000	.000	0
ELEMENT NO 27	IS A TRANSITION	U/S DATA	4013.550	54.670	13	N .015	.000	.000		

W S P G W

PAGE NO 4

WATER SURFACE PROFILE - ELEMENT CARD LISTING

WARNING - ADJACENT SECTIONS ARE NOT IDENTICAL - SEE SECTION NUMBERS AND CHANNEL DEFINITIONS

ELEMENT NO	IS A	U/S DATA	STATION	INVERT	SECT		RADIUS	ANGLE	ANG PT	MAN H
ELEMENT NO 28	IS A REACH	U/S DATA	4415.160	59.850	16	N .015	.000	.000	.000	0
ELEMENT NO 29	IS A SYSTEM HEADWORKS	U/S DATA	4415.160	59.850	16		W S ELEV 55.470			

POST-CONSTRUCTION WSPG MODEL

FILE: pvflam11.WSW

W S P G W - CIVILDDESIGN Version 14.06
Program Package Serial Number: 1754
WATER SURFACE PROFILE LISTING

PAGE 1

Date: 4-13-2007 Time:10:51: 0

PARADISE VALLEY
BOX CULVERT ANALYSIS (FLAMINGO WASH)
ADDED SECTIONS FOR CORFCD REQUEST (ABBY)

Station	Invert Elev	Depth	Water Elev	Q	Vel	Vel Head	Energy	Super	Critical	Flow Top	Height	Base Wt	No Wth
L/Elem	Ch Slope			(CFS)	(FPS)		Grd.El.	Elev	Depth	Width	Dia.-FT	I.D.	ZL
						SE Ave	HF	SE Dpth	Frude N	Norm Dp	"N"	X-Fall	2R
													Type Ch
195.000	14.220	8.783	23.003	3923.00	14.94	3.42	28.42	.00	9.62	63.38		10	0 .0
TRANS STR	.0245					.0189	7.86	8.79	1.28		.030		IR-OPEN
610.000	24.370	5.362	29.732	3923.00	17.65	4.84	34.57	.00	6.89	60.99		11	0 .0
TRANS STR	.0138					.0158	3.00	5.36	1.63		.030		IR-OPEN
800.000	27.000	8.292	35.292	3923.00	12.71	2.51	37.80	.00	8.29	61.52		14	0 .0
TRANS STR	.0000					.0061	.30	8.29	1.00		.030		IR-OPEN
850.000	27.000	9.653	36.653	3923.00	9.98	1.55	38.20	.00	9.09	64.39		5	0 .0
TRANS STR	.0000					.0053	.26	9.65	.71		.030		IR-OPEN
900.010	27.000	9.271	36.271	3923.00	12.32	2.36	38.63	.00	8.83	55.50		4	0 .0
TRANS STR	.0200					.0057	.29	9.27	.91		.030		IR-OPEN
950.010	28.000	9.189	37.189	3923.00	10.71	1.78	38.97	.00	9.16	63.81		7	0 .0
TRANS STR	.0086					.0027	.14	9.19	.79		.030		IR-OPEN
1000.000	28.440	10.456	38.896	3923.00	5.96	.55	39.45	.00	4.94	63.00	8.000	63.000	.00 0 .0
BRIDGE EXIT													
1000.000	28.440	10.456	38.896	3923.00	8.22	1.05	39.94	.00	5.12	63.00	8.000	63.000	.00 4 .8
110.410	.0030					.0016	.34	10.46	.53	5.29	.013	.00	BOX
1210.410	29.070	10.166	39.236	3923.00	8.22	1.05	40.28	.00	5.12	63.00	8.000	63.000	.00 4 .8
TRANS STR	.0031					.0016	.02	10.17	.53		.013	.00	BOX

PARADISE VALLEY
BOX CULVERT ANALYSIS -FLAMINGO WASH:
ADDED SECTIONS FOR GCRFCD REQUEST (ABBY)

Station	Invert Elev	Depth (FT)	Water Elev	Q (CFS)	Vel (FPS)	Vel Head	Energy Grd.El.	Super Elev	Critical Flow Depth	Flow Top Width	Height/ Dia.-FT or I.D.	Base Wt. Lb	No Wth Pres/Pip
U/Elem	Ch Slope				SF Ave	HF	SE Dpth	Froude N	Norm Dp	"N"	X-Fall	ZR	Type Ch
1223.160	29.110	10.060	39.170	3923.00	8.97	1.22	40.39	.00	5.39	57.75	8.000	57.750	.00 3 .8
TRANS STR	.0009				.0010	.00	10.06	.57		.013	.00	.00	BOX
1224.160	29.110	10.175	39.285	3923.00	9.49	1.12	40.40	.00	5.23	57.75	8.000	57.750	.00 3 .0
BRIDGE EXIT													
1224.160	29.110	10.175	39.295	3923.00	8.87	1.22	40.51	.00	5.39	57.75	8.000	57.750	.00 3 .8
TRANS STR	.0030						10.17	.57		.013	.00	.00	BOX
1274.240	29.260	4.903	34.163	3923.00	22.85	8.11	42.27	.00	7.31	37.50	8.500	37.500	.00 3 .9
BRIDGE ENTRANCE													
1274.240	29.260	4.085	33.345	3923.00	25.61	10.18	43.53	.00	6.98	37.50	8.500	37.500	.00 0 .0
TRANS STR	.0030				.0089	.32	4.39	2.23		.013	.00	.00	BOX
1310.410	29.370	7.287	36.657	3923.00	22.27	7.70	44.36	.00	9.00	25.00	9.000	25.000	.00 1 .8
23.580	.0081				.0077	.18	7.29	1.48	7.17	.013	.00	.00	BOX
1333.990	29.560	7.295	36.855	3923.00	22.25	7.69	44.54	1.17	9.00	25.00	9.000	25.000	.00 1 .8
167.000	.0072				.0073	1.30	8.46	1.48	7.47	.013	.00	.00	BOX
1500.950	30.770	7.212	37.982	3923.00	22.51	7.87	45.85	.00	9.00	25.00	9.000	25.000	.00 1 .8
140.120	.0094				.0076	1.07	7.21	1.50	6.75	.013	.00	.00	BOX
1641.110	32.090	7.446	39.536	3923.00	21.80	7.38	46.91	1.24	9.00	25.00	9.000	25.000	.00 1 .8
75.320	.0081				.0072	.54	9.69	1.43	7.14	.013	.00	.00	BOX

PARADISE VALLEY
BOX CULVERT ANALYSIS (FLAMINGO WASH)
ADDED SECTIONS FOR CORFCD REQUEST (ABBY)

Date: 4-13-2007 Time:10:51: 0

Station	Invert Elev	Depth FT	Water Elev	Q CFS	Vel FPS	Vel Head	Energy Grd.El.	Super Elev	Critical Depth	Flow Top Width	Height/Base Dia.-FT. or I.D.	Wt. I.D.	No Wth Pres/Pip	
L/Elem	Ch Slope					SP Ave	HF	SE Dpth	Froude N	Norm Dp	"N"	X-Fall	ZR	Type Ch
1716.130	32.700	7.519	40.219	3923.00	21.59	7.24	47.45	.00	9.00	25.00	9.000	25.000	.00	1 .8
113.400	.0087					.0068	.77	7.52	1.41	6.95	.013	.00	.00	BOX
1829.530	33.690	7.781	41.471	3923.00	20.86	6.76	48.23	.86	9.00	25.00	9.000	25.000	.00	1 .8
2.349	.0085					.0065	.02	8.64	1.34	7.02	.013	.00	.00	BOX
1831.879	33.710	7.797	41.497	3923.00	20.84	6.75	48.24	.86	9.00	25.00	9.000	25.000	.00	1 .8
97.481	.0085					.0061	.60	8.64	1.34	7.02	.013	.00	.00	BOX
1929.360	34.540	8.167	42.707	3923.00	19.87	6.13	48.84	.00	9.00	25.00	9.000	25.000	.00	1 .8
4.297	.0074					.0057	.02	8.17	1.25	7.42	.013	.00	.00	BOX
														----- WARNING - Flow depth near top of box conduit -----
1933.657	34.572	8.181	42.753	3923.00	19.84	6.11	48.86	.00	9.00	25.00	9.000	25.000	.00	1 .8
79.098	.0074					.0054	.43	8.18	1.24	7.42	.013	.00	.00	BOX
														----- WARNING - Flow depth near top of box conduit -----
2012.755	35.155	8.580	43.735	3923.00	18.92	5.56	49.29	.00	9.00	25.00	9.000	25.000	.00	1 .8
33.285	.0074					.0048	.16	8.58	1.16	7.42	.013	.00	.00	BOX
														----- WARNING - Flow depth near top of box conduit -----

PARADISE VALLEY

BOX CULVERT ANALYSIS (FLAMINGO WASH)

ADDED SECTIONS FOR CORFCD REQUEST (ABBY)

Station	Invert Elev	Depth (FT)	Water Elev	Q (CFS)	Vel (FPS)	Vel Head	Energy Grd.El.	Super Elev	Critical Depth	Flow Top Width	Height Dia.-FT	Base Wt I.D.	ZL	No Wth Pts/Pip
L/Elem	Ch Slope				SF Ave	HF	SE Dpth	Froude N	Norm Dp	"N"	X-Fail	ZR	Type Ch	
2046.040	35.100	9.000	44.400	3923.00	13.03	5.05	49.45	.00	9.00	25.00	9.000	25.000	.00	1 .3
TRANS STR	.0085				.0030	.06	9.00	1.08	.013	.00	.00	.00	BOX	
----- WARNING - Flow depth near top of box conduit -----														
2066.040	35.570	11.765	47.335	3923.00	12.97	2.61	49.95	.00	8.05	31.00	10.000	31.000	.00	1 .3
134.125	.0082				.0030	.40	11.76	.73	5.70	.013	.00	.00	BOX	
2200.166	36.672	11.058	47.729	3923.00	12.97	2.61	50.34	.00	8.05	31.00	10.000	31.000	.00	1 .9
HYDRAULIC JUMP														
2200.166	36.672	5.282	41.953	3923.00	24.55	9.36	51.31	.00	8.05	31.00	10.000	31.000	.00	1 .9
15.635	.0082				.0102	.16	5.28	1.91	5.70	.013	.00	.00	BOX	
2215.900	36.900	5.271	42.071	3923.00	24.60	9.40	51.47	.00	8.05	31.00	10.000	31.000	.00	1 .9
313.443	.0101				.0133	3.22	5.27	1.91	5.29	.013	.00	.00	BOX	
2529.243	39.975	5.254	45.229	3923.00	24.68	9.46	54.69	.00	8.05	31.00	10.000	31.000	.00	1 .8
763.106	.0101				.0110	8.43	5.25	1.92	5.29	.013	.00	.00	BOX	
3292.348	47.705	5.010	52.715	3923.00	25.99	10.41	63.12	.00	8.05	31.00	10.000	31.000	.00	1 .8
323.252	.0101				.0126	4.08	5.01	2.06	5.29	.013	.00	.00	BOX	
3615.600	50.980	4.776	55.756	3923.00	27.15	11.45	67.20	.00	8.05	31.00	10.000	31.000	.00	1 .8
TRANS STR	.0093				.0167	6.62	4.78	2.22	.015	.00	.00	.00	BOX	

PARADISE VALLEY

BOX CULVERT ANALYSIS (FLAMINGO WASH)

ADDED SECTIONS FOR CORFCD REQUEST (ABBY)

Station	Invert Elev	Depth	Water Elev	Q	Vel	Vel	Energy	Super	Critical	Flow Top	Height	Base Wt	No Wch
		FT		CFS	FPS	Head	Grd.El.	Elev	Depth	Width	Dia.-FT	or I.D.	PS/Pip
L/Elem	Ch Slope				SF Ave	HF	SE Dpth	Froude N	Norm Dp	"N"	X-Fall	2R	Type Ch
4013.550	54.670	5.619	60.289	3923.00	29.29	12.43	72.72	.00	9.26	29.14		16	0 .0
401.610	.0129					.0129	5.18	5.62	2.29	5.619	.015		IR-OPEN
4415.160	59.850	5.620	65.470	3923.00	28.29	12.43	77.90	.00	9.26	29.13		16	0 .0

PARADISE VALLEY

BOX CULVERT ANALYSIS (FLAMINGO WASH)

ADDED SECTIONS FOR CORFOO REQUEST (ABBY)

195.00	.I	W C E H	.	TX
257.99	.		.	
320.97	.		.	
383.96	.		.	
446.95	.		.	
509.94	.		.	
572.92	.		.	
635.91	.	I W C EH	.	TX
699.90	.		.	
761.89	.		.	
824.87	.	I WH E	.	TX
887.86	.	I C W H	.	TX
950.85	.	I CW HE	.	TX
1013.84	.	I C WHE	.	TX
1076.82	.	ISBBBBBSCBBH WE	.	BZ
1139.81	.	I C H W E	.	R
1202.80	.		.	
1265.79	.	I C H WE	.	TX
1328.77	.	I C H W E	.	TX
1391.76	.	ISBBBBBSCBBH W E	.	BX
1454.75	.	I C H W E	.	TX
1517.74	.	ISBBBBBWBBCCH E	.	BE
1580.72	.	I W C H E	.	TX
1643.71	.	I W H E	.	P
1706.70	.	I W SH E	.	R
1769.69	.	I W H E	.	R
1832.67	.	I W SH E	.	P
1895.66	.	I W H E	.	P
1958.65	.	I W H E	.	P
2021.64	.	I W H E	.	R
2084.63	.	I W H E	.	P
2147.61	.	I W H E	.	R
2210.60	.	I WH E	.	R
2273.59	.	I H E	.	TX


2336.57	.	I		C	H	W	E		.	R
2399.56	.	I		C	H	W	E		.	R
2462.55	.	I		W	C	H		E	.	R
2525.54	.	I		W	C	H		E	.	R
2588.52			I		W	C	H		E	R
2651.51	.								.	
2714.50	.								.	
2777.49	.								.	
2840.47	.								.	
2903.46	.								.	
2966.45	.								.	
3029.44	.								.	
3092.42									.	
3155.41	.								.	
3218.40	.								.	
3281.39	.								.	
3344.37	.			I		W	C	H		E
3407.36	.								.	
3470.35	.								.	
3533.34	.								.	
3596.32	.								.	
3659.31	.			I		W	C	H		E
3722.30	.								.	TX
3785.29									.	
3848.27	.								.	
3911.26	.								.	
3974.25	.								.	
4037.24						I		W	C	H
4100.22									.	
4163.21	.								.	
4226.20	.								.	
4289.19									.	
4352.17									.	
4415.16	.					I		W	C	H
									E	R
44.120		20.583	26.966	33.303	39.691	46.059	52.427	58.795	65.162	71.530
										77.893

I I O T E S
 1. GLOSSARY
 I = INVERT ELEVATION
 C = CRITICAL DEPTH
 W = WATER SURFACE ELEVATION
 S = SUPER-ELEVATION

NEW CARD
BE

NEW STA
CARDS
BX ÷ TS

NEW CARD

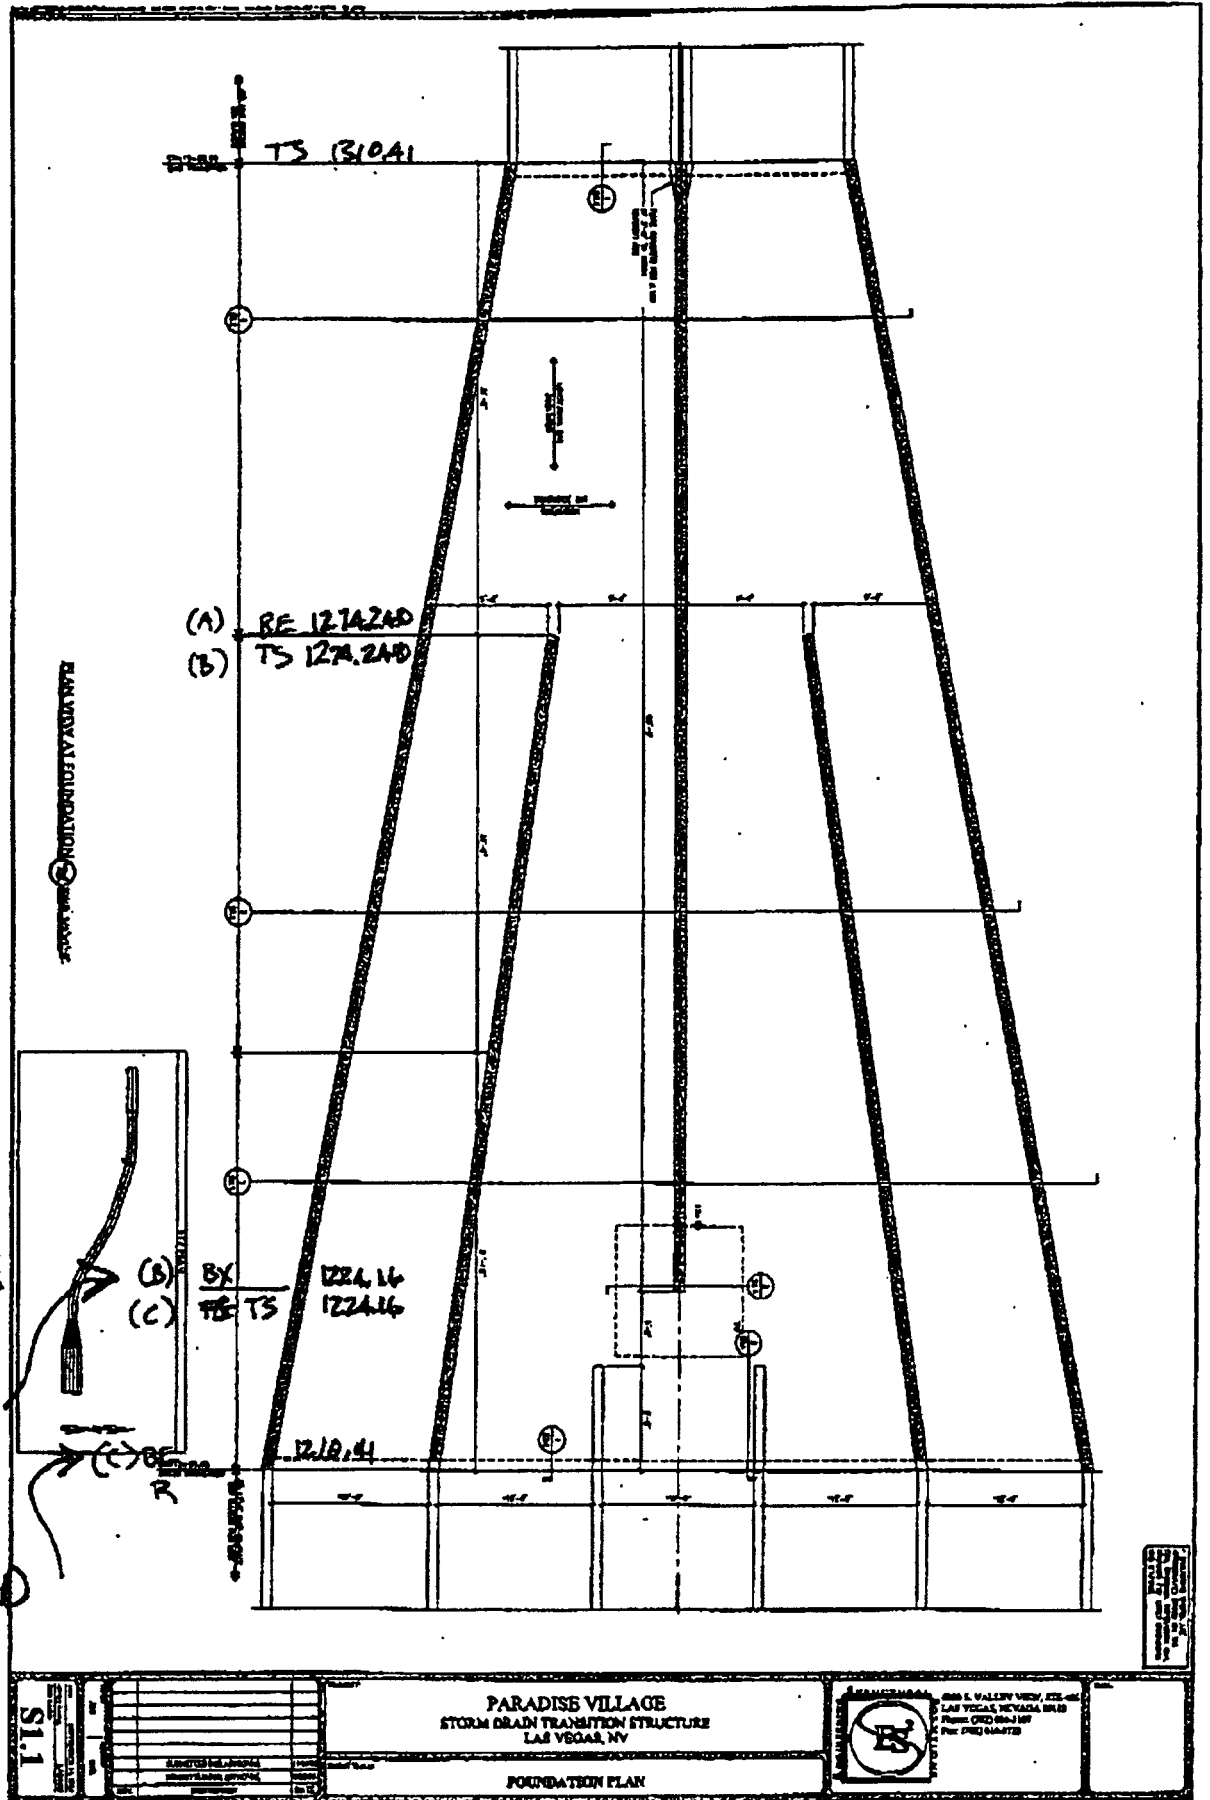

H = HEIGHT OF CHANNEL
E = ENERGY GRADE LINE
X = CURVES CROSSING OVER
B = BRIDGE ENTRANCE OR EXIT
Y = WALL ENTRANCE OR EXIT
2. STATIONS FOR POINTS AT A JUMP MAY NOT BE PLOTTED EXACTLY

APPENDIX E

WSPGW Work Maps

APPENDIX F

FEMA Forms – MT2 Form 1, 2, 3

FEDERAL EMERGENCY MANAGEMENT AGENCY
OVERVIEW & CONCURRENCE FORM

*O.M.B No. 3067-0148
Expires September 30, 2005*

PAPERWORK BURDEN DISCLOSURE NOTICE

Public reporting burden for this form is estimated to average 1 hour per response. The burden estimate includes the time for reviewing instructions, searching existing data sources, gathering and maintaining the needed data, and completing, reviewing, and submitting the form. You are not required to respond to this collection of information unless a valid OMB control number appears in the upper right corner of this form. Send comments regarding the accuracy of the burden estimate and any suggestions for reducing this burden to: Information Collections Management, Federal Emergency Management Agency, 500 C Street, SW, Washington DC 20472, Paperwork Reduction Project (3067-0148). Submission of the form is required to obtain or retain benefits under the National Flood Insurance Program. **Please do not send your completed survey to the above address.**

A. REQUESTED RESPONSE FROM FEMA

This request is for a (check one):

- ☐ CLOMR: A letter from FEMA commenting on whether a proposed project, if built as proposed, would justify a map revision, or proposed hydrology changes (See 44 CFR Ch. 1, Parts 60, 65 & 72).
- ☒ LOMR: A letter from FEMA officially revising the current NFIP map to show the changes to floodplains, regulatory floodway or flood elevations. (See Parts 60 & 65 of the NFIP Regulations.)

B. OVERVIEW

1. The NFIP map panel(s) affected for all impacted communities is (are):

Community No.	Community Name	State	Map No.	Panel No.	Effective Date
Ex: 480301 480287	City of Katy Harris County	TX TX	480301 48201C	0005D 0220G	02/08/83 09/28/90
320003	Clark County, Unincorporated Areas	NV	32003	2557E	9/27/02

2. Flooding Source: Flamingo Wash

3. Project Name/Identifier: Paradise Village

4. FEMA zone designations affected: A (choices: A, AH, AO, A1-A30, A99, AE, AR, V, V1-V30, VE, B, C, D, X)

5. Basis for Request and Type of Revision:

a. The basis for this revision request is (check all that apply)

- ☐ Physical Change ☐ Improved Methodology/Data
- ☒ Regulatory Floodway Revision ☐ Other (Attach Description)

Note: A photograph and narrative description of the area of concern is not required, but is very helpful during review.

b. The area of revision encompasses the following types of flooding and structures (check all that apply)

- Types of Flooding: ☒ Riverine ☐ Coastal ☐ Shallow Flooding (e.g., Zones AO and AH)
- ☐ Alluvial fan ☐ Lakes ☐ Other (Attach Description)
- Structures: ☒ Channelization ☐ Levee/Floodwall ☐ Bridge/Culvert
- ☐ Dam ☐ Fill ☐ Other, Attach Description

C. REVIEW FEE

Has the review fee for the appropriate request category been included?

☒ Yes

Fee amount: \$4800

☐ No, Attach ExplanationPlease see the FEMA Web site at http://www.fema.gov/plan/prevent/fhm/fm_fees.shtm for Fee Amounts and Exemptions.**D. SIGNATURE**

All documents submitted in support of this request are correct to the best of my knowledge. I understand that any false statement may be punishable by fine or imprisonment under Title 18 of the United States Code, Section 1001.

Name: James Coleman

Company: Lapour Partners, Inc.

Mailing Address:

5525 S. Decatur Blvd, Suite 10

Las Vegas

Daytime Telephone No.:
(702) 222-3022Fax No.:
(702) 631-3909

E-Mail Address: jcoleman@lapour.com

Signature of Requester (required):

Date: 4/21/08

As the community official responsible for floodplain management, I hereby acknowledge that we have received and reviewed this Letter of Map Revision (LOMR) or conditional LOMR request. Based upon the community's review, we find the completed or proposed project meets or is designed to meet all of the community floodplain management requirements, including the requirement that no fill be placed in the regulatory floodway, and that all necessary Federal, State, and local permits have been, or in the case of a conditional LOMR, will be obtained. In addition, we have determined that the land and any existing or proposed structures to be removed from the SFHA are or will be reasonably safe from flooding as defined in 44CFR 65.2(c), and that we have available upon request by FEMA, all analyses and documentation used to make this determination.

Community Official's Name and Title:

Telephone No.:

Community Name: Clark County

Community Official's Signature (required):

Date:

CERTIFICATION BY REGISTERED PROFESSIONAL ENGINEER AND/OR LAND SURVEYOR

This certification is to be signed and sealed by a licensed land surveyor, registered professional engineer, or architect authorized by law to certify elevation information. All documents submitted in support of this request are correct to the best of my knowledge. I understand that any false statement may be punishable by fine or imprisonment under Title 18 of the United States Code, Section 1001.

Certifier's Name: Stephen F. Crevoiserat, P.E.

License No.: Nevada License 13689

Expiration Date:
12-31-08

Company Name: Rome Consulting

Telephone No.: (702) 791-3900

Fax No.:
(702) 631-3909

Signature:

Date: 4/21/08

Ensure the forms that are appropriate to your revision request are included in your submittal.

Form Name and (Number)**Required if ...**☒ Riverine Hydrology and Hydraulics Form (Form 2)

New or revised discharges or water-surface elevations

☒ Riverine Structures Form (Form 3)Channel is modified, addition/revision of bridge/culverts,
addition/revision of levee/floodwall, addition/revision of dam☐ Coastal Analysis Form (Form 4)

New or revised coastal elevations

☐ Coastal Structures Form (Form 5)

Addition/revision of coastal structure

☐ Alluvial Fan Flooding Form (Form 6)

Flood control measures on alluvial fans

Seal (Optional)

FEDERAL EMERGENCY MANAGEMENT AGENCY
RIVERINE HYDROLOGY & HYDRAULICS FORM

O.M.B No. 3067-0148
Expires September 30, 2005

PAPERWORK REDUCTION ACT

Public reporting burden for this form is estimated to average 3 hours per response. The burden estimate includes the time for reviewing instructions, searching existing data sources, gathering and maintaining the needed data, and completing, reviewing, and submitting the form. You are not required to respond to this collection of information unless a valid OMB control number appears in the upper right corner of this form. Send comments regarding the accuracy of the burden estimate and any suggestions for reducing this burden to: Information Collections Management, Federal Emergency Management Agency, 500 C Street, SW, Washington DC 20472, Paperwork Reduction Project (3067-0148). Submission of the form is required to obtain or retain benefits under the National Flood Insurance Program. **Please do not send your completed survey to the above address.**

Flooding Source: Flamingo Wash

Note: Fill out one form for each flooding source studied

A. HYDROLOGY

1. Reason for New Hydrologic Analysis (check all that apply)

- ☒ Not revised (skip to section 2) ☐ No existing analysis ☐ Improved data
☐ Alternative methodology ☐ Proposed Conditions (CLOMR) ☐ Changed physical condition of watershed

2. Comparison of Representative 1%-Annual-Chance Discharges

Location	Drainage Area (Sq. Mi.)	FIS (cfs)	Revised (cfs)
----------	-------------------------	-----------	---------------

3. Methodology for New Hydrologic Analysis (check all that apply)

- ☐ Statistical Analysis of Gage Records ☐ Precipitation/Runoff Model [TR-20, HEC-1, HEC-HMS etc.]
☐ Regional Regression Equations ☐ Other (please attach description)

Please enclose all relevant models in digital format, maps, computations (including computation of parameters) and documentation to support the new analysis. The document, "Numerical Models Accepted by FEMA for NFIP Usage" lists the models accepted by FEMA. This document can be found at: http://www.fema.gov/plan/prevent/fhm/en_modl.shtml.

4. Review/Approval of Analysis

If your community requires a regional, state, or federal agency to review the hydrologic analysis, please attach evidence of approval/review.

5. Impacts of Sediment Transport on Hydrology

Was sediment transport considered? ☐ Yes ☒ No If yes, then fill out Section F (Sediment Transport) of Form 3. If No, then attach your explanation for why sediment transport was not considered.

B. HYDRAULICS

1. Reach to be Revised

	Description	Cross Section	Water-Surface Elevations (ft.)	
			Effective	Proposed/Revised
Downstream Limit	WSPG Section 610	FIS 340	2029.23	2029.73
Upstream Limit	WSPG Section 3615.6	FIS 440	2055.67	2055.76

2. Hydraulic Method Used

Hydraulic Analysis WSPG [HEC-2 , HEC-RAS, Other (Attach description)]

Explanations for MT-2 Form 2

Section A.4

Approval letters from Clark County Development Services and Clark County Regional Flood Control District is provided and attached in the Appendix G, Approval Letters.

Section A.5

Sediment Transport is generally not a factor in hydrological analysis and is generally the practice here in the Las Vegas Valley.

B. HYDRAULICS (CONTINUED)

3. Pre-Submittal Review of Hydraulic Models

FEMA has developed two review programs, CHECK-2 and CHECK-RAS, to aid in the review of HEC-2 and HEC-RAS hydraulic models, respectively. These review programs verify that the hydraulic estimates and assumptions in the model data are in accordance with NFIP requirements, and that the data are comparable with the assumptions and limitations of HEC-2/HEC-RAS. CHECK-2 and CHECK-RAS identify areas of potential error or concern. These tools do not replace engineering judgment. CHECK-2 and CHECK-RAS can be downloaded from http://www.fema.gov/plan/prevent/fhm/fhm_soft.shtm. We recommend that you review your HEC-2 and HEC-RAS models with CHECK-2 and CHECK-RAS. If you disagree with a message, please attach an explanation of why the message is not valid in this case. Review of your submittal and resolution of valid modeling discrepancies will result in reduced review time.

HEC-2/HEC-RAS models reviewed with CHECK-2/CHECK-RAS?

☐ Yes ☒ No

4. Models Submitted

Duplicate Effective Model*

Natural File Name:

Floodway File Name:

Corrected Effective Model*

Natural File Name:

Floodway File Name:

Existing or Pre-Project Conditions Model

Natural File Name: pv-flam7

Floodway File Name: Flamingo Wash

Revised or Post-Project Conditions Model

Natural File Name: pv-flam11

Floodway File Name: Flamingo Wash

Other - (attach description)

Natural File Name:

Floodway File Name:

*Not required for revisions to approximate 1%-annual-chance floodplains (Zone A) – for details, refer to the corresponding section of the instructions.

The document "Numerical Models Accepted by FEMA for NFIP Usage" lists the models accepted by FEMA. This document can be found at: http://www.fema.gov/plan/prevent/fhm/en_modl.shtm.

C. MAPPING REQUIREMENTS

A **certified topographic map** must be submitted showing the following information (where applicable): the boundaries of the effective, existing, and proposed conditions 1%-annual-chance floodplain (for approximate Zone A revisions) or the boundaries of the 1%- and 0.2%-annual-chance floodplains and regulatory floodway (for detailed Zone AE, AO, and AH revisions); location and alignment of all cross sections with stationing control indicated; stream, road, and other alignments (e.g., dams, levees, etc.); current community easements and boundaries; boundaries of the requester's property; certification of a registered professional engineer registered in the subject State; location and description of reference marks; and the referenced vertical datum (NGVD, NAVD, etc.).

Note that the boundaries of the existing or proposed conditions floodplains and regulatory floodway to be shown on the revised FIRM and/or FBFM must tie-in with the effective floodplain and regulatory floodway boundaries. Please attach a **copy of the effective FIRM and/or FBFM**, annotated to show the boundaries of the revised 1%- and 0.2%-annual-chance floodplains and regulatory floodway that tie-in with the boundaries of the effective 1%- and 0.2%-annual-chance floodplain and regulatory floodway at the upstream and downstream limits of the area of revision.

D. COMMON REGULATORY REQUIREMENTS

1. For CLOMR requests, do Base Flood Elevations (BFEs) increase?

☐ Yes ☐ No

For CLOMR requests, if either of the following is true, please submit evidence of compliance with Section 65.12 of the NFIP regulations:

- The proposed project encroaches upon a regulatory floodway and would result in increases above 0.00 foot.
- The proposed project encroaches upon a SFHA with BFEs established and would result in increases above 1.00 foot.

2. Does the request involve the placement or proposed placement of fill?

☐ Yes ☐ No

If Yes, the community must be able to certify that the area to be removed from the special flood hazard area, to include any structures or proposed structures, meets all of the standards of the local floodplain ordinances, and is reasonably safe from flooding in accordance with the NFIP regulations set forth at 44 CFR 60.3(a)(3), 65.5(a)(4), and 65.6(a)(14). Please see the MT-2 instructions for more information.

3. For LOMR requests, is the regulatory floodway being revised?

☐ Yes ☒ No

If Yes, attach evidence of regulatory floodway revision notification. As per Paragraph 65.7(b)(1) of the NFIP Regulations, notification is required for requests involving revisions to the regulatory floodway. (Not required for revisions to approximate 1%-annual-chance floodplains [studied Zone A designation] unless a regulatory floodway is being added. Elements and examples of regulatory floodway revision notification can be found in the MT-2 Form 2 Instructions.)

4. For LOMR requests, does this request require property owner notification and acceptance of BFE increases?

☐ Yes ☒ No

If Yes, please attach proof of property owner notification and acceptance (if available). Elements of and examples of property owner notification can be found in the MT-2 Form 2 Instructions.

FEDERAL EMERGENCY MANAGEMENT AGENCY
RIVERINE STRUCTURES FORM

*O.M.B. No. 3067-0148
Expires September 30, 2005*

PAPERWORK REDUCTION ACT

Public reporting burden for this form is estimated to average 7 hours per response. The burden estimate includes the time for reviewing instructions, searching existing data sources, gathering and maintaining the needed data, and completing, reviewing, and submitting the form. You are not required to respond to this collection of information unless a valid OMB control number appears in the upper right corner of this form. Send comments regarding the accuracy of the burden estimate and any suggestions for reducing this burden to: Information Collections Management, Federal Emergency Management Agency, 500 C Street, SW, Washington DC 20472, Paperwork Reduction Project (3067-0148). Submission of the form is required to obtain or retain benefits under the National Flood Insurance Program. **Please do not send your completed survey to the above address.**

Flooding Source: Flamingo Wash

Note: Fill out one form for each flooding source studied

A. GENERAL

Complete the appropriate section(s) for each Structure listed below:

Channelization..... complete Section B
Bridge/Culvert..... complete Section C
Dam..... complete Section D
Levee/Floodwall..... complete Section E
Sediment Transport..... complete Section F (if required)

Description Of Structure

1. Name of Structure: Flamingo Wash Storm Drain

Type (check one): ☒ Channelization ☐ Bridge/Culvert ☐ Levee/Floodwall ☐ Dam

Location of Structure: Extending approximately 1200 east of Paradise Road

Downstream Limit/Cross Section: WSPG Section 1000

Upstream Limit/Cross Section: WSPG Section 2215.60

2. Name of Structure:

Type (check one): ☐ Channelization ☐ Bridge/Culvert ☐ Levee/Floodwall ☐ Dam

Location of Structure:

Downstream Limit/Cross Section:

Upstream Limit/Cross Section:

3. Name of Structure:

Type (check one) ☐ Channelization ☐ Bridge/Culvert ☐ Levee/Floodwall ☐ Dam

Location of Structure:

Downstream Limit/Cross Section:

Upstream Limit/Cross Section:

NOTE: For more structures, attach additional pages as needed.

B. CHANNELIZATION

Flooding Source: Flamingo Wash

Name of Structure: Flamingo Wash Storm Drain

1. Accessory Structures

The channelization includes (check one):

- ☐ Levees [Attach Section E (Levee/Floodwall)]
☐ Superelevated sections
☐ Debris basin/detention basin
☐ Other (Describe):

- ☐ Drop structures
☒ Transitions in cross sectional geometry
☐ Energy dissipator

2. Drawing Checklist

Attach the plans of the channelization certified by a registered professional engineer, as described in the instructions.

3. Hydraulic Considerations

The channel was designed to carry 3923 (cfs) and/or the 100-year flood.

The design elevation in the channel is based on (check one):

- ☒ Subcritical flow ☐ Critical flow ☒ Supercritical flow ☐ Energy grade line

If there is the potential for a hydraulic jump at the following locations, check all that apply and attach an explanation of how the hydraulic jump is controlled without affecting the stability of the channel.

- ☐ Inlet to channel ☐ Outlet of channel ☐ At Drop Structures ☒ At Transitions
☐ Other locations (specify):

4. Sediment Transport Considerations

Was sediment transport considered? ☐ Yes ☒ No If Yes, then fill out Section F (Sediment Transport).
If No, then attach your explanation for why sediment transport was not considered.

C. BRIDGE/CULVERT

Flooding Source:

Name of Structure:

1. This revision reflects (check one):

- ☐ New bridge/culvert not modeled in the FIS
☐ Modified bridge/culvert previously modeled in the FIS
☐ New analysis of bridge/culvert previously modeled in the FIS

2. Hydraulic model used to analyze the structure (e.g., HEC-2 with special bridge routine, WSPRO, HY8):

If different than hydraulic analysis for the flooding source, justify why the hydraulic analysis used for the flooding source could not analyze the structures. Attach justification.

3. Attach plans of the structures certified by a registered professional engineer. The plan detail and information should include the following (check the information that has been provided):

- | | |
|---|--|
| ☐ Dimensions (height, width, span, radius, length) | ☐ Erosion Protection |
| ☐ Shape (culverts only) | ☐ Low Chord Elevations – Upstream and Downstream |
| ☐ Material | ☐ Top of Road Elevations – Upstream and Downstream |
| ☐ Beveling or Rounding | ☐ Structure Invert Elevations – Upstream and Downstream |
| ☐ Wing Wall Angle | ☐ Stream Invert Elevations – Upstream and Downstream |
| ☒ Skew Angle | ☐ Cross-Section Locations |
| ☐ Distances Between Cross Sections | |

4. Sediment Transport Considerations

Was sediment transport considered? ☐ Yes ☒ No If yes, then fill out Section F (Sediment Transport).
If No, then attach your explanation for why sediment transport was not considered.

Explanations for MT-2 Form 3

Section B.3

The hydraulic jump will occur upstream of the transition structures

Secion B.4


Sediment Transport is generally not a factor in hydrological analysis and is generally the practice here in the Las Vegas Valley.

APPENDIX G

Approval Letters

05-54297
LTR

**REGIONAL FLOOD
CONTROL DISTRICT**

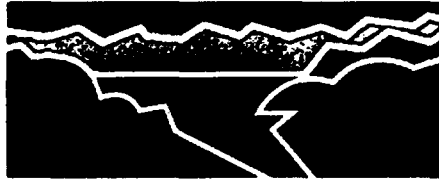

RECEIVED

MAY 18 2007

**DEVELOPMENT SERVICES
CIVIL ENGINEERING**

Gale Wm. Fraser, II, P.E.
General Manager/Chief
Engineer

BOARD OF DIRECTORS

Larry Brown
Chairman
City of Las Vegas

Chip Maxfield
Vice-Chairman
Clark County

Robert L. Ellison
City of North Las Vegas

Mayor Oscar Goodman
City of Las Vegas

Andy Hafen
City of Henderson

Mayor Bill Nicholes
City of Mesquite

Roger Tobler
City of Boulder City

Bruce L. Woodbury
Clark County

May 17, 2007

Mr. Layne Weber, P.E.
Department of Development Services
500 S. Grand Central Parkway
Las Vegas, NV 89155

**DISTRICT CONCURRENCE: PARADISE VILLAGE
(HTE #05-54297) (RFCD No. 06-6967)**

Dear Mr. Weber:

Clark County Regional Flood Control District (District) reviewed Technical Drainage Study dated December 12, 2005, Addendum No. 1 dated May 2, 2006, Addendum No. 2 dated June 29, 2006, Addendum No. 3 dated April 17, 2007, Supplement No. 1 dated July 12, 2006, Supplement No. 2 dated July 28, 2006, Supplement No. 3 dated November 14, 2006, Supplement No. 4 dated December 21, 2006 for above-mentioned project as submitted by ALPHA ENGINEERING CO. In addition, District is in receipt of the Conditional Letter of Acceptance from Department of Development Services dated May 4, 2007.

District concurs with acceptance of this Technical Drainage Study by Department of Development Services subject to the following condition:

Per Regional Flood Control District Policies and Procedures Manual, Section VIII. D. 13. Uniform Regulations for the Control of Drainage, the Lead Entity shall provide As-Built plans or record drawings to the District after completion and final inspection of such privately installed flood control facilities that have a regional flood control significance.

District's review of this project was limited to issues of Regional Flood Control Significance as defined in *Uniform Regulations for the Control of Drainage*. As noted in study, site resides in a Special Flood Hazard Area (SFHA) designated as "Zone A" per the effective Flood Insurance Rate Map (FIRM). Therefore, consultant should be advised that this acceptance does not serve to amend the FIRM or remove the SFHA.

Please be aware that as additional information becomes available and/or restudies of Flood Insurance Studies are performed, information submitted by ALPHA ENGINEERING CO may be superseded. Compliance with regulatory elements and design standards specified in *Uniform Regulations for the Control of Drainage* does not imply a guarantee that properties will be free from flooding or flood damage.

REGIONAL FLOOD CONTROL DISTRICT

Mr. Layne Weber


May 17, 2007


Page 2 of 2

The District, its officials, or employees assume no liability for information, data, or conclusions presented by consulting engineers. We, therefore, make no warranties, either expressed or implied, in conducting this review.

GALE WM. FRASER, II, P.E.
General Manager/Chief Engineer

BY:

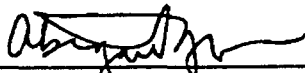
Abigail Mayrena, P.E.
Associate Engineer

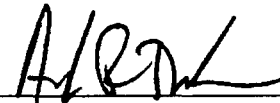
Andrew R. Trelease, P.E., CFM
Principal Civil Engineer

AM:ART:ph

c: Philip D. Wakefield, P.E., ALPHA ENGINEERING CO

P:\Letters and Memos\Local Drainage\Land Development & Drainage\Concurrence Letters\2007\May07\21-61-15.ALP.doc



Department of Development Services

Civil Engineering Division

500 S Grand Central Pky 1st Fl • Box 551799 • Las Vegas NV 89155-1799
(702) 455-4600 • Fax (702) 388-2550

Phil Rosenquist, Director

January 11, 2007

Alpha Engineering
50 South Jones Blvd., Suite 202
Las Vegas, NV 89107

05-54297
RETURN DRAINAGE STUDY
REDLINES WITH ALL FUTURE
SUBMITTALS FOR THIS PROJECT

SUBJECT: WILLDAN/Clark County Development Services Dept. Plan Review Contract
Technical Drainage Study for Paradise Village (5096)

Study Dated: December 12, 2005

Addendum Dated: May 2, 2006

Second Addendum Dated: June 29, 2006

Supplemental Dated: July 12, 2006

Second Supplemental Dated: July 28, 2006

Third Supplemental Dated: November 29, 2006

Fourth Supplemental Dated: December 21, 2006

Location: North of Flamingo Road between Paradise Road and Palos
Verdes Street

(Sec. 15, T. 21 S., R. 61 E.)

HTE# 05-54297

The Referenced **Technical Drainage Study** has been reviewed and is accepted as complying with the minimum improvement standards. As set forth in the subject drainage study, the following measures will be taken to mitigate flood hazards.

1. The site shall be graded with respect to drainage as shown on "Paradise Village Grading Plan," sheets G1, G2, G3, G4 D1, D2, PP1, PP2, PP3 and PP4, signed and sealed by Stephen F. Crevoiserat, P.E., on November 15, 2006.

The storm drain transition structures and maintenance manholes shall be constructed as shown on "Paradise Village Structural Plans", sheets S0.1, S1.1, S1.2, S1.3, S2.2, S2.4 and S2.5, signed and sealed by Jason P. South, P.E., on November 14, 2006 and sheets S2.1 and S2.3, signed and sealed by Greg A. Meyer, P.E., on December 20, 2006;

2. The following drainage facilities shall be constructed:

- a. Three (3) areas of **public underground drainage easement together with access thereto** as listed below:
 - i. **Drainage easement** of varied width located on the south side of A Street between station 16+50 and station 18+50
 - ii. 15-foot wide **drainage easement** located on the north side of A Street between station 12+75 and the westerly right-of-way of Palos Verde Street
 - iii. 10-foot wide **drainage easement** located on the south side of A Street between station 12+75 and the westerly right-of-way of Palos Verde Street
- b. A storm drain system within an **existing drainage easement / right-of-way** of various width to be publicly maintained, connecting to two (2) existing 15-foot x 10-foot RCB's under Paradise extending east and connecting to five (5) existing 12-foot x 8-foot RCB's under Palos Verde, consisting of approximately 150 lf of two (2) 15-foot x 10-foot RCB's, a 20-foot transition structure, 738 lf of two (2) 12-foot x 9-foot RCB's, a 100-foot transition structure, and 250 lf of five (5) 12-foot x 8-foot RCB's, with fourteen (14) 48-inch Type 1 manholes, and two (2) 10-foot x 10-foot maintenance box manholes, as shown on the above-mentioned grading plans
- c. Approximately 5 lf of 24-inch RCP extending south from a 48-inch Type I manhole at station 21+99.47 as shown on sheets G1 and PP1
- d. Approximately 7 lf of 24-inch RCP extending south from an existing 24-inch RCP at station 21+64.11 as shown on sheets G1 and PP1
- e. Approximately 19 lf of 24-inch RCP extending northeast from an existing 24-inch storm drain connecting into the above-mentioned 12-foot x 9-foot RCB as shown on sheets G1 and PP4
- f. An 8-foot wide concrete valley gutter on the east side of Paradise Road crossing the driveway entrance as shown on sheet G1
- g. An 8-foot wide concrete valley gutter on the west side of Palos Verde crossing the driveway entrance
- h. An onsite 2-foot wide concrete flume extending north from the northeast corner of APN#162-15-401-012, within a 5-foot wide drainage easement to be privately maintained, with a wrought iron fence and bollards at the inlet and sidewalk underdrain at the outlet as shown on sheet G1

- i. A 30-foot long wrought iron fence and bollards on the south side of the site west of the above-mentioned 2-foot flume as shown on sheet G1
 - j. Onsite graded swales as shown on details D/D1, F/D1 and H/D1
3. A bond estimate must be submitted to Clark County Civil Engineering Division for the above-mentioned stormwater management facilities, except items 2(a) and 2(j);
4. Please provide the following statement on each sheet of the grading plan set near the lower right corner: Section 2 or Section 3 of the Clark County Building Office Operations Division Drainage Compliance Report must be completed by the engineer.
5. It is required for this project to enter into a License and Maintenance Agreement with the County for the maintenance of landscape within the drainage easement. Approval of this license and maintenance agreement must be complete before permits will be issued;
6. Vacate any excess public right-of-way / drainage easement before permits will be issued;
7. The subject site is located within Zone X and Zone A, as shown on FIRM Community Panel Number 32003C2557E, revised September 27, 2002, revised to reflect a LOMR dated September 1, 2005. Zone X is determined to be outside the 0.2% annual chance flood plain. Zone A is a special flood hazard area subject to inundation by the 1% annual chance flood event. No base flood elevations have been determined by FEMA;
8. Clark County Regional Flood Control District (CCRFCD) concurrence is required since the project impacts a Master Planned Facility and is within a FEMA designated special flood hazard area. As a condition of final approval, the applicant must submit a copy of the drainage study and any addenda to the CCRFCD. Permits will not be issued until concurrence is obtained from the CCRFCD;
9. Since the project proposes construction within a SFHA Zone A, the Engineer will need to notify FEMA of the proposed changes to the flood zone and obtain a CLOMR prior to the issuance of permits;
10. As a condition of approval, the bond for the proposed drainage improvements will not be released until the LOMR for the site is obtained;

11. Any improvements not depicted on the above mentioned grading plans will require an Update to this Technical Drainage Study. It should be noted that no building permits shall be issued until the LOMR for the site is obtained;
12. A legal description of the drainage easement to be publicly maintained, a copy of this drainage study approval letter must be submitted to the Clark County Department of Development Services, Civil Engineering Division, Right-of-Way/Mapping counter for review and approval. Upon approval of the legal description and submittal package, Civil Engineering will prepare the easement document for owner's signature. Upon receipt of the fully executed easement document, Civil Engineering will record this easement. **Note, this easement must be recorded prior to permit issuance;**
13. Mylars of the grading plan must be submitted to the Clark County Civil Engineering Division Plan Check for approval signatures prior to permit issuance;
14. Right-of-way dedication must be verified;
15. **As a condition of final approval, the drainage/grading plans submitted for this project require the following modifications prior to Civil Engineering Plan Check submittal:**
 - a. The 5-foot drainage easement to be privately maintained, with the 2-foot wide concrete valley gutter must be labeled on sheet G1
 - b. Revise the grading plans to reflect the 100-foot transition section
 - c. Revise the structural plans to reflect the 100-foot transition section
 - d. All the RCB's must be consistently labeled as 150 LF (2) 15' x 10' RCB, in lieu of 2: 150 LF 15' x 10' RCB
 - e. The length of the 24-inch lateral pipe at station 21+99.47 on the plan view on sheet PP1 must be revised to 4.88-feet
 - f. A detail of the 24-inch lateral at station 21+99.47 must be provided
 - g. On sheet PP4, the size of the dual 12-foot x 9-foot RCB is incorrectly written on the profile
 - h. Show the 48-inch Type I SDMH at station 11+95.00 on the plan view on sheet PP3

- i. Increase the width of the drainage easement located on the south side of A Street between station 12+75 and the westerly right-of-way of Palos Verde Street to 10 feet
- j. The grading plans must refer to a specific structural plan sheet
- k. Detailed sections must show and label the proposed culverts and drainage easement where applicable

The County's review is solely based on the information submitted by the Engineer of Record. The County's review is strictly limited to compliance with minimum County Codes and Standards. The Engineer of Record is responsible for researching and addressing situations that may require designs above and beyond the minimum codes for issues of public safety and impacts to upstream, downstream and adjacent properties. The County assumes no liability for information data, designs or conclusions of the Engineer of Record;

DEPARTMENT OF DEVELOPMENT SERVICES

BY: _____

Jeffery J. Jensen, P.E
Senior Engineer
Civil Engineering Division

JJJ/pts /

cc: Lapour Partners
Development File



Department of Development Services

Civil Engineering Division

500 S Grand Central Pky 1st Fl • PO Box 551799 • Las Vegas NV 89155-1799
(702) 455-4600 • Fax (702) 388-2550

Phil Rosenquist, Director

August 2, 2006

RECEIVED

05-54297
RETURN DRAINAGE STUDY
REDLINES WITH ALL FUTURE
SUBMITTALS FOR THIS PROJECT

Alpha Engineering Company
3321 N. buffalo Drive, Suite 200
Las Vegas, NV 89148

SUBJECT: WILLDAN/Clark County Development Services Dept. Plan Review Contract
Technical Drainage Study for Paradise Village (5096)
Study Dated: December 12, 2005
Addendum Dated: May 2, 2006
Second Addendum Dated: June 29, 2006
Supplemental Dated: July 12, 2006 and July 28, 2006
Location: North of Flamingo Road between Paradise Road and Palos Verde Street
(Sec. 15, T. 21 S., R. 61 E.)
HTE #05-54297

The referenced **Technical Drainage Study** has been reviewed and is accepted as complying with minimum improvement standards. As set forth in the subject drainage study, the following measures will be taken to mitigate flood hazards.

1. The site shall be graded with respect to drainage as shown on "Paradise Village Grading Plan," sheets G1, G2, G3, G4 D1, D2, PP1, PP2, PP3 and PP4, signed and sealed by Stephen F. Crevoiserat, P.E., on June 28, 2006.

The storm drain transition structures and maintenance manholes shall be constructed as shown on "Paradise Village Structural Plans", sheets S0.1, S1.1, S1.2, S1.3, S2.1, and S2.4, signed and sealed by Greg A. Meyer, P.E., on June 28, 2006 and sheets S2.2 and S2.3, signed and sealed by Greg A. Meyer, P.E., on May 1, 2006;

2. The following drainage facilities shall be constructed:
 - a. Three (3) areas of public underground drainage easement together with access thereto as listed below:

- i. Drainage easement of varied width located on the south side of A Street between station 16+50 and station 18+50
- ii. 15-foot wide drainage easement located on the north side of A Street between station 12+75 and the westerly right-of-way of Palos Verde Street
- iii. 10-foot wide drainage easement located on the south side of A Street between station 12+75 and the westerly right-of-way of Palos Verde Street
- b. A storm drain system within an existing drainage easement / right-of-way of various width to be publicly maintained, connecting to two (2) existing 15-foot x 10-foot RCB's under Paradise Road extending east and connecting to five (5) existing 12-foot x 8-foot RCB's under Palos Verde, consisting of approximately 150 lf of two (2) 15-foot x 10-foot RCB's, a 20-foot transition structure, 738 lf of two (2) 12-foot x 9-foot RCB's, a 25-foot transition structure, and 250 lf of five (5) 12-foot x 8-foot RCB's, with fourteen (14) 48-inch Type 1 manholes, and two (2) 8-foot x 8-foot maintenance box manholes, as shown on the above-mentioned grading plans
- c. Approximately 5 lf of 24-inch RCP and a 48-inch Type I manhole extending south from an existing 24-inch RCP at station 21+99.47 as shown on sheets G1 and PP1
- d. Approximately 7 lf of 24-inch RCP extending south from an existing 24-inch RCP at station 21+64.11 as shown on sheets G1 and PP1
- e. Approximately 19 lf of 24-inch RCP extending northeast from an existing 24-inch storm drain connecting into the above-mentioned 12-foot x 9-foot RCB at station 18+48.74 as shown on sheets G1 and PP1
- f. An 8-foot wide concrete valley gutter on the east side of Paradise Road crossing the driveway entrance as shown on sheet G1
- g. An 8-foot wide concrete valley gutter on the west side of Palos Verde crossing the driveway entrance
- h. An onsite 2-foot wide concrete flume extending north from the northeast corner of APN#162-15-401-012, within a 5-foot wide drainage easement to be privately maintained, with a wrought iron fence and bollards at the inlet and sidewalk underdrain at the outlet as shown on sheet G1

- i. A 30-foot long wrought iron fence and bollards on the south side of the site west of the above-mentioned 2-foot flume as shown on sheet G1
 - j. Onsite graded swales as shown on details D/D1, F/D1 and H/D1
3. A bond estimate must be submitted to Clark County Civil Engineering Division for the above-mentioned stormwater management facilities, except items 2(a), 2(i) and 2(j);
4. Section 2 of the Clark County Building Office Operations Division Drainage Compliance Report must be completed by the engineer for the non-bonded facilities listed in Item 2 above;
5. It is required for this project to enter into a License and Maintenance Agreement with the County for the maintenance of landscape within the drainage easement. Approval of this license and maintenance agreement must be completed before permits will be issued;
6. Vacate any excess public right-of-way / drainage easement before permits will be issued;
7. The subject site is located within Zone X and Zone A, as shown on FIRM Community Panel Number 32003C2557E, revised September 27, 2002, revised to reflect a LOMR dated September 1, 2005. Zone X is determined to be outside the 0.2% annual chance flood plain. Zone A is a special flood hazard area subject to inundation by the 1% annual chance flood event. No base flood elevations have been determined by FEMA;
8. Clark County Regional Flood Control District (CCRFCD) concurrence is required since the project impacts a Master Planned Facility and is within a FEMA designated special flood hazard area. As a condition of final approval, the applicant must submit a copy of the drainage study and any addenda to the CCRFCD. Permits will not be issued until concurrence is obtained from the CCRFCD;
9. Since the project proposes construction within a SFHA Zone A, the Engineer will need to notify FEMA of the proposed changes to the flood zone and obtain a CLOMR prior to the issuance of permits;
10. As a condition of approval, the bond for the proposed drainage improvements will not be released until the LOMR for the site is obtained;


11. Any improvements not depicted on the above mentioned grading plans will require an Update to this Technical Drainage Study. It should be noted that no building permits shall be issued until the LOMR for the site is obtained
12. A legal description of the drainage easement to be publicly maintained, a copy of this drainage study approval letter must be submitted to the Clark County Department of Development Services, Civil Engineering Division, Right-of-Way/Mapping counter for review and approval. Upon approval of the legal description and submittal package, Civil Engineering will prepare the easement document for owner's signature. Upon receipt of the fully executed easement document, Civil Engineering will record this easement. **Note, this easement must be recorded prior to permit issuance;**
13. Mylars of the grading plan must be submitted to the Clark County Civil Engineering Division Plan Check for approval signatures prior to permit issuance;
14. Right-of-way dedication must be verified;
15. **As a condition of final approval, the drainage/grading plans submitted for this project require the following modifications prior to Civil Engineering Plan Check submittal:**
 - a. The 5-foot drainage easement to be privately maintained, with the 2-foot wide concrete valley gutter must be labeled on sheet G1
 - b. The length of the 24-inch lateral pipe at station 21+99.47 on the plan view must be revised to 4.88-feet to match sheet G1
 - c. A detail of the 24-inch lateral at station 21+99.47 must be provided
 - d. On sheet PP4, the size of the dual 12-foot x 9-foot RCB is incorrectly written on the profile
 - e. Show the 48-inch Type I SDMH at station 11+95.00 on the plan view, or remove the manhole from the profile
 - f. Increase the width of the drainage easement located on the south side of A Street between station 12+75 and the westerly right-of-way of Palos Verde Street to 10 feet
 - g. All the RCB's must be consistently labeled with width x height
 - h. The grading plans must refer to a specific structural plan sheet

- i. Detailed sections must show and label the proposed culverts and drainage easement where applicable
- j. Other red lined revisions

The County's review is solely based on the information submitted by the Engineer of Record. The County's review is strictly limited to compliance with minimum County Codes and Standards. The Engineer of Record is responsible for researching and addressing situations that may require designs above and beyond the minimum codes for issues of public safety and impacts to upstream, downstream and adjacent properties. The County assumes no liability for information data, designs or conclusions of the Engineer of Record;

DEPARTMENT OF DEVELOPMENT SERVICES

BY:

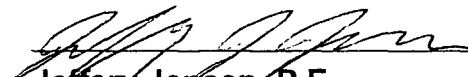
Jeffery Jensen, P.E.
Senior Engineer
Civil Engineering Division

JJJ/pts

cc: Lavour Partners
Development File



Federal Emergency Management Agency

Washington, D.C. 20472

NOV 10 2006

CERTIFIED MAIL
RETURN RECEIPT REQUESTED

IN REPLY REFER TO:
Case No.: 06-09-BC85R

The Honorable Rory Reid
Chair, Clark County Board
of Commissioners
500 South Grand Central Parkway
Las Vegas, NV 89155

Community: Clark County, NV
Community No.: 320003

104

Dear Mr. Reid:

This responds to a request that the Department of Homeland Security's Federal Emergency Management Agency (FEMA) comment on the effects that a proposed project would have on the effective Flood Insurance Rate Map (FIRM) for Clark County, Nevada and Incorporated Areas, in accordance with Part 65 of the National Flood Insurance Program (NFIP) regulations. In a letter dated July 17, 2006, Mr. Philip D. Wakefield, P.E., Alpha Engineering, requested that FEMA evaluate the effects that the proposed construction of a storm drain along Flamingo Wash from just upstream of Palos Verdes Street to approximately 50 feet downstream of Paradise Road would have on the flood hazard information shown on the effective FIRM.

All data required to complete our review of this request for a Conditional Letter of Map Revision (CLOMR) were submitted with letters from Mr. Wakefield

We reviewed the submitted data and the data used to prepare the effective FIRM for your community and determined that the proposed project meets the minimum floodplain management criteria of the NFIP. The submitted existing conditions HEC-RAS hydraulic computer model, dated June 21, 2006, based on updated topographic information, was used as the base conditions model in our review of the proposed conditions model for this CLOMR request. We believe that, if the proposed project is constructed as shown on the plans entitled "Paradise Village," and as described in the submitted report entitled "Conditional Letter of Map Revision for Paradise Village," all prepared by Alpha Engineering, dated July 17, 2006, and the data listed below are received, a revision to the FIRM would be warranted.

As a result of the proposed storm drain, the width of the Special Flood Hazard Area (SFHA), the area that would be inundated by the flood having a 1-percent chance of being equaled or exceeded (base flood), will decrease and be removed along Flamingo Wash from just upstream of Palos Verdes Street to approximately 50 feet downstream of Paradise Road. The maximum decrease in SFHA width, approximately 100 feet, will occur approximately 200 feet downstream of Paradise Road. The entire base flood will be contained in the proposed storm drain along Flamingo Wash from just upstream of Palos Verdes Street to approximately 50 feet downstream of Paradise Road.

Upon completion of the project, your community may submit the data listed below and request that we make a final determination on revising the effective FIRM.

- Detailed application and certification forms must be used for requesting final revisions to the maps. Therefore, when the map revision request for the area covered by this letter is submitted, Form 1, entitled "Overview & Concurrence Form," must be included. (A copy of this form is enclosed.)
- The detailed application and certification forms listed below may be required if as-built conditions differ from the preliminary plans. If required, please submit new forms (copies of which are enclosed) or annotated copies of the previously submitted forms showing the revised information.

Form 2, entitled "Riverine Hydrology & Hydraulics Form"

Form 3, entitled "Riverine Structures Form"

Hydraulic analyses, for as-built conditions, of the base flood, together with a work map showing the revised floodplain boundaries, must be submitted with Form 2.

- Effective October 30, 2005, FEMA revised the fee schedule for reviewing and processing requests for conditional and final modifications to published flood information and maps. In accordance with this schedule, the current fee for this map revision request is \$4,000 and must be received before we can begin processing the request. Please note, however, that the fee schedule is subject to change, and requesters are required to submit the fee in effect at the time of the submittal. Payment of this fee shall be made in the form of a check or money order, made payable in U.S. funds to the National Flood Insurance Program, or by credit card. The payment must be forwarded to the following address:

Federal Emergency Management Agency
Fee-Charge System Administrator
P.O. Box 22787
Alexandria, VA 22304

- As-built plans, certified by a registered professional engineer, of all proposed project elements
- Community acknowledgment of the map revision request

The basis of this CLOMR is, in whole or in part, a storm drain project. NFIP regulations, as cited in Paragraph 60.3(b)(7), require that communities assure that the flood-carrying capacity within the altered or relocated portion of any watercourse is maintained. This provision is incorporated into your community's existing floodplain management regulations. Consequently, the ultimate responsibility for maintenance of the storm drain rests with your community.

This CLOMR is based on minimum floodplain management criteria established under the NFIP. Your community is responsible for approving all floodplain development and for ensuring all necessary permits required by Federal or State law have been received. State, county, and community officials, based on

knowledge of local conditions and in the interest of safety, may set higher standards for construction in the SFHA. If the State, county, or community has adopted more restrictive or comprehensive floodplain management criteria, these criteria take precedence over the minimum NFIP criteria.

If you have any questions regarding floodplain management regulations for your community or the NFIP in general, please contact the Consultation Coordination Officer (CCO) for your community. Information on the CCO for your community may be obtained by calling the Director, Federal Insurance and Mitigation Division of FEMA in Oakland, California, at (510) 627-7175. If you have any questions regarding this CLOMR, please call our Map Assistance Center, toll free, at 1-877-FEMA MAP (1-877-336-2627).

Sincerely,



Kevin C. Long, CFM, Project Engineer
Engineering Management Section
Mitigation Division

For: William R. Blanton Jr., CFM, Chief
Engineering Management Section
Mitigation Division

Enclosures

cc: Mr. Robert Thompson, P.E.
Principal Engineer
Civil Engineering Division
Clark County Department of Development Services

Mr. Dave Betley, P.E.
Senior Civil Engineer
Civil Engineering Division
Clark County Department of Development Services

Mr. Kevin Eubanks, P.E., CFM
Assistant General Manager
Clark County Regional Flood Control District

Mr. Philip D. Wakefield, P.E.
Alpha Engineering


APPENDIX H

As-Built Civil Improvement Plans


**A MIX USE SUBDIVISION
CLARK COUNTY, NEVADA
APN 162-15-401-005, 006, 007, 008
AND 009**

SHEET
C1
1 OF 29 SHEETS
DRAWING NO.
HTE# 07-15692


1. (1) #4 BAR IN ADDITION TO VERTS
AND HORIZ BARS TO MATCH SLOPE
2. (4) #5 BARS, SPACED EVENLY.
HOOK AT TOP AND BOTTOM, MIN LAP
3. PLACE (3) #3 TIES AT TOP AND
BOTTOM W/ IN 9", THEN SPACE
AT 10" O.C. THROUGHOUT.
4. #4 AT 12" O.C. EA WAY
5. TOP SLAB AT TRANSITION STRUCTURE
6. BOTTOM SLAB OF TRANSITION
STRUCTURE

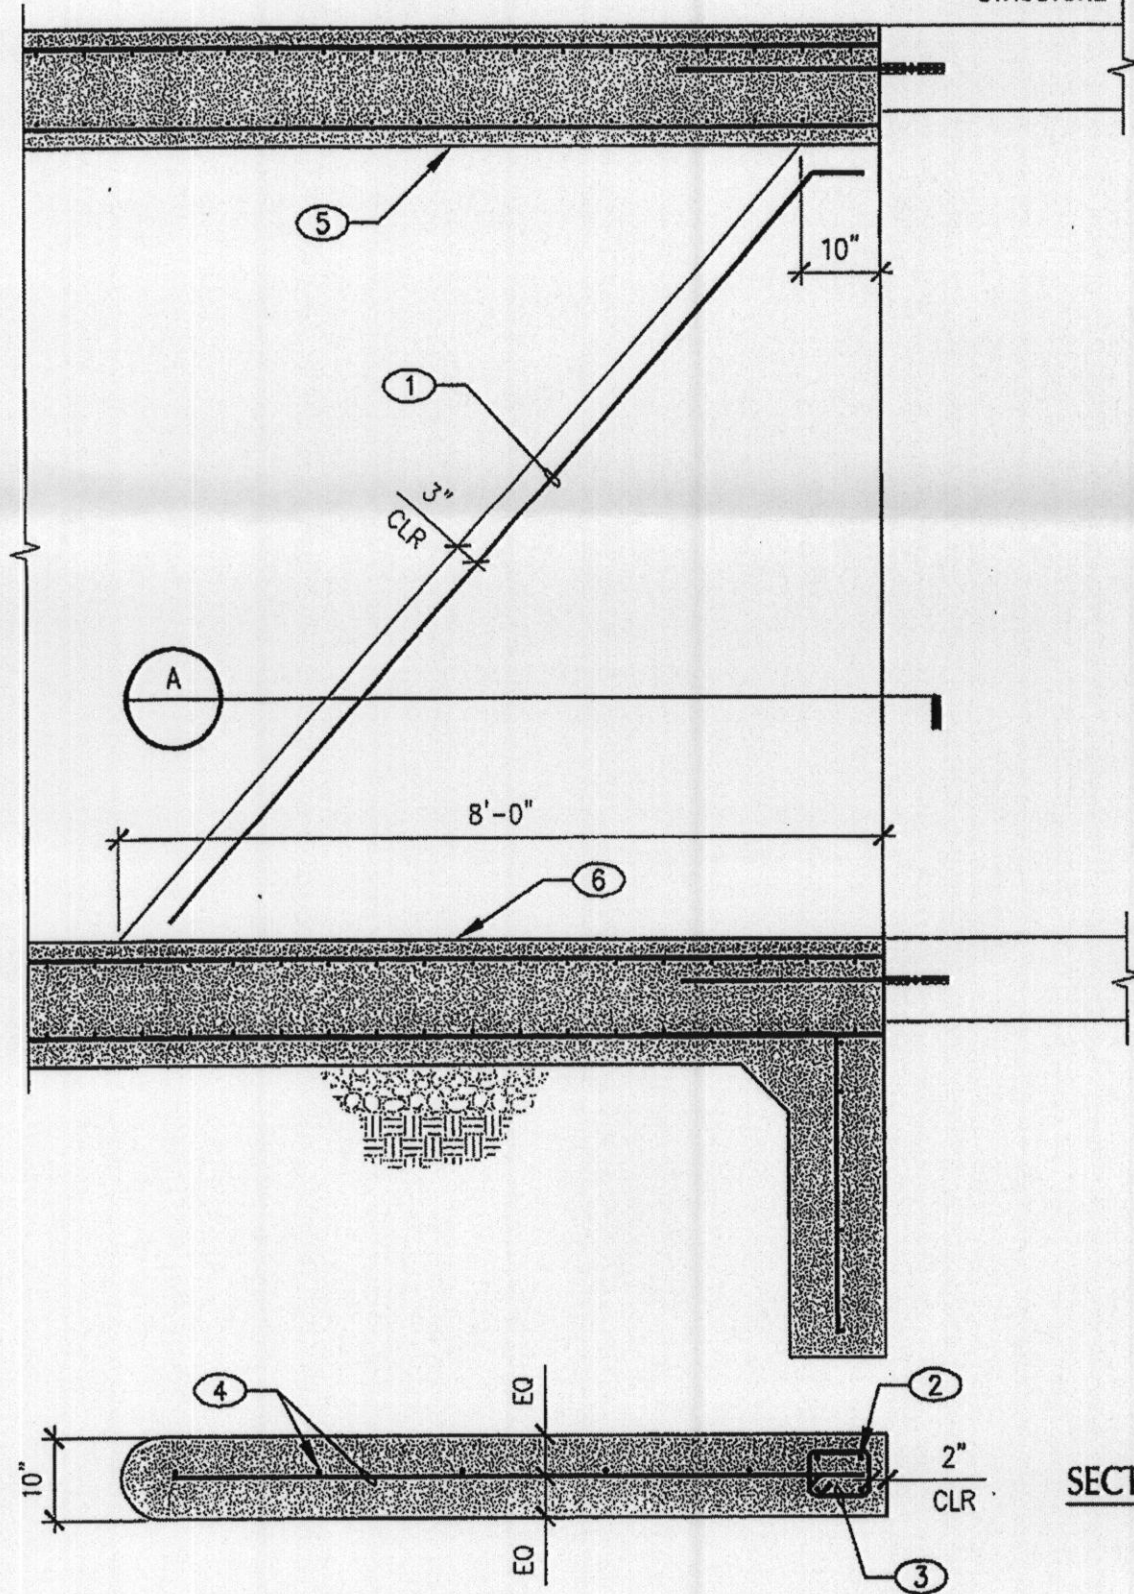

SECTION A

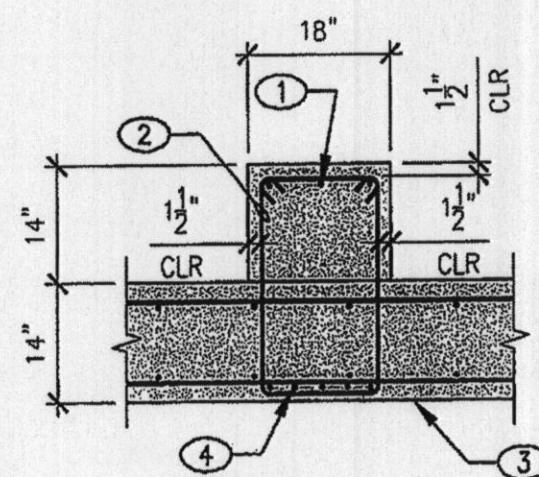

3 TURNED UP BEAM SECTION AT TOP SLAB
NO SCALE


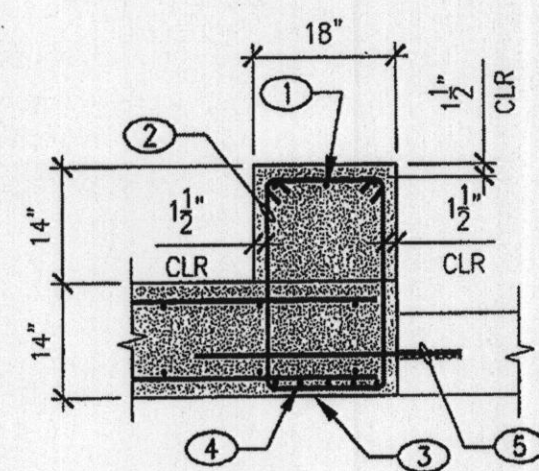


4 BEAM SECTION OVER RCB OPENING
NO SCALE


1. (3) #6 HORIZ, EVENLY SPACED
2. #4 TIES AT 4" O.C.
3. FOR REINF, SEE APPROPRIATE DETAIL
4. (5) #10 HORIZ, EVENLY SPACED

1. (3) #6 HORIZ, EVENLY SPACED
2. #4 TIES AT 11" O.C.
3. FOR REINF, SEE APPROPRIATE DETAIL
4. (5) #10 HORIZ, EVENLY SPACED
5. #4x36" LONG DOWEL AT 12" O.C.
DRILL AND EPOXY W/ HILTY-HIT
HY150 6" MIN EMBED

1. FLARE CONCRETE LONGITUDINALLY
3'-0" TO MATCH ADJACENT RCB'S
FILLET
2. RCB PER INDOT

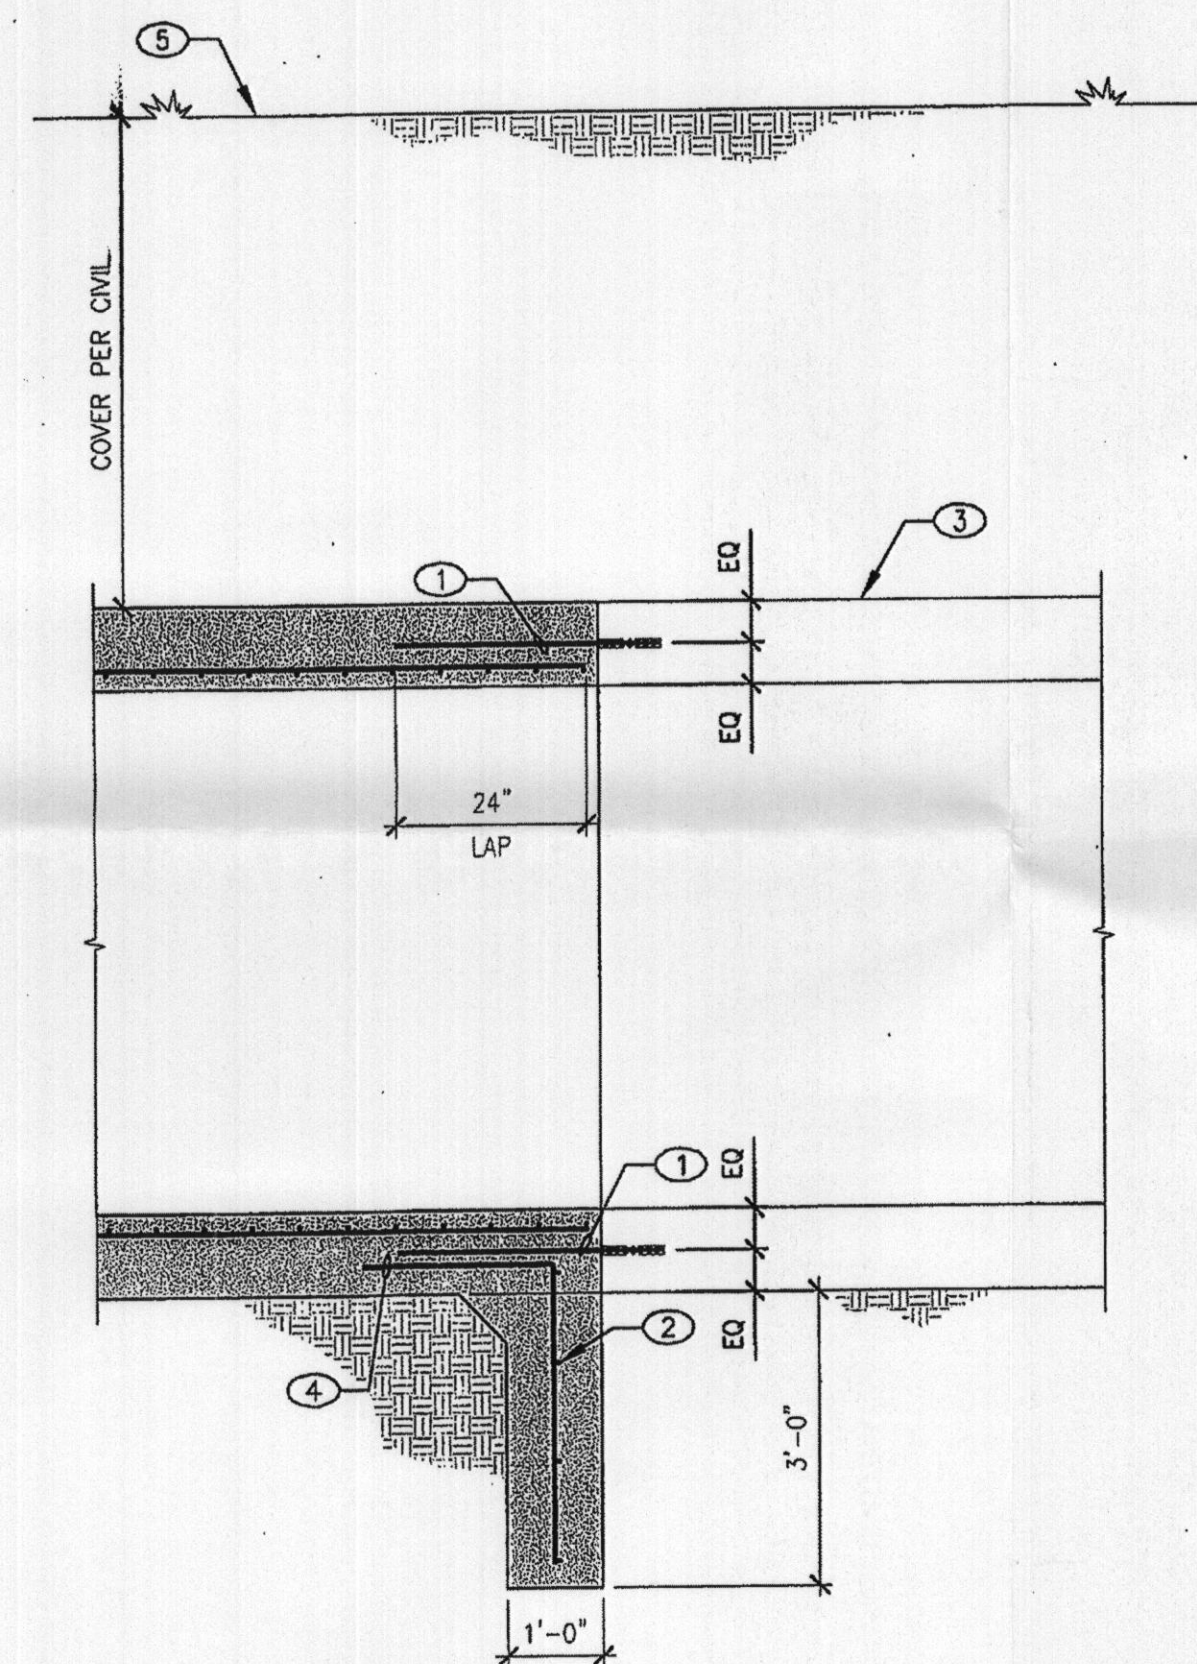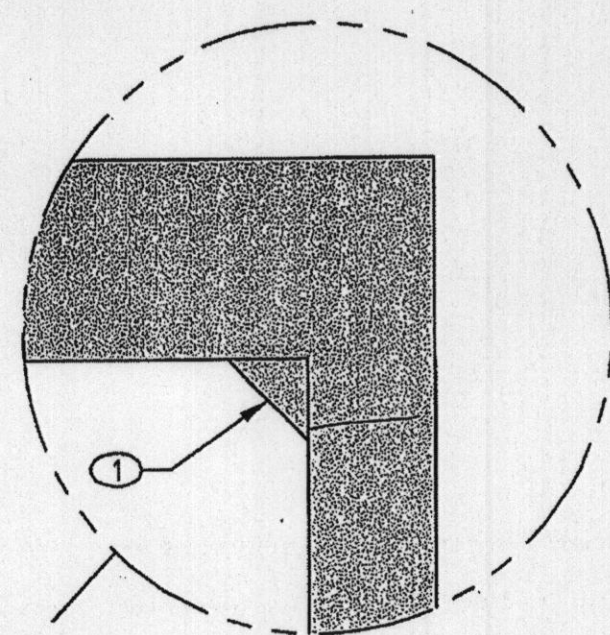


1 CONNECTION AT EXISTING RCB
NO SCALE

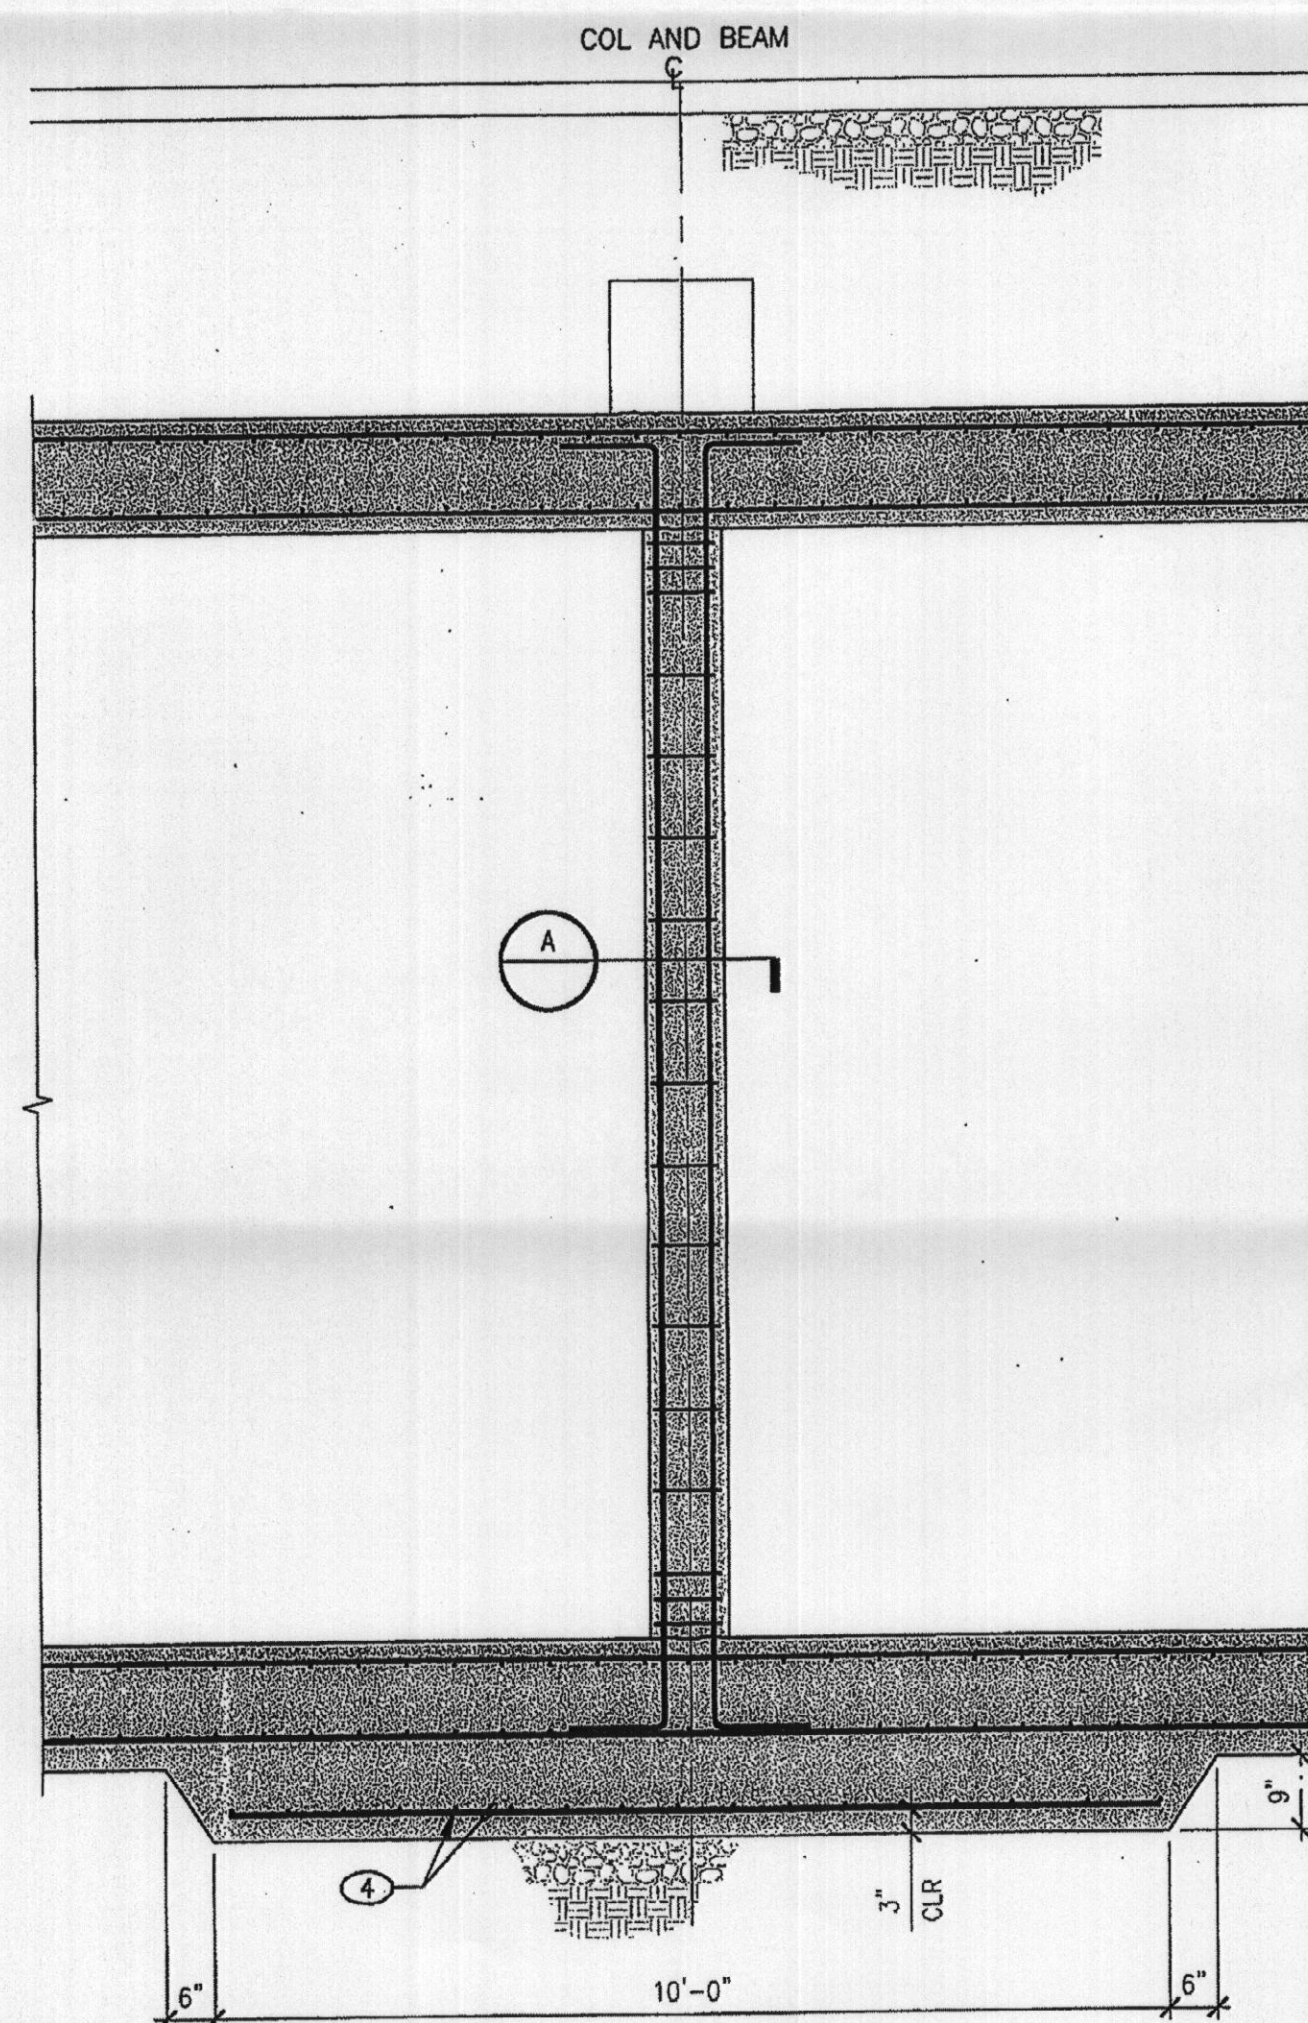

SECTION A

1. #4x36" LONG DOWEL AT 12" O.C.
DRILL AND EPOXY W/ HILTY-HIT
HY150 6" MIN EMBED
2. #4 AT 12" O.C.
3. EXISTING RCB, SEE CIVIL
4. #4 AT 12" O.C.

1. FOR REINF, SEE APPROPRIATE
DETAIL
2. (4) #5 BARS EVENLY SPACED, W/
HOOK AT TOP AND BOTTOM
3. #3 TIES. PLACE (3) TIES IN TOP
AND BOTTOM W/ IN 9", THEN AT
10" O.C.
4. #5 BARS AT 7" O.C. EA WAY
THROUGH OUT

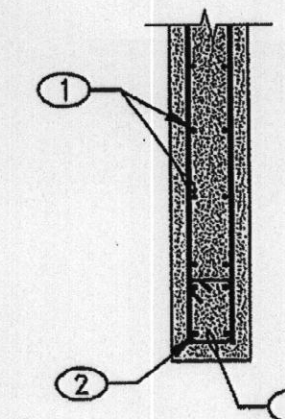

SECTION AT END OF WALL
NO SCALE

PARADISE VILLAGE
STORM DRAIN TRANSITION STRUCTURE
LAS VEGAS, NV

SECTIONS

[illegible]

\$2.4

- KEYNOTES:
1. (3) #6 BOTTOM BARS
 2. (2) #5 TOP BARS
 3. #4 STIRRUPS SPACE 6" FRC-1
FACE OF SUPPORT, REMAINING
12" O.C.
 4. #4 AT 12" O.C. VERT AND
HORIZ. BARS. LAP VERT BARS
BELOW 24"
 5. SUPPORT BEAM PER PLAN
 6. RCB REINFORCING BARS. REFER TO
DETAIL 2/52.1
 7. FINAL GRADE
 8. BACKFILL MATERIAL AND
PROCEDURES PER GSN
 9. GRATING PER DETAIL 2
THIS SHEET.
 10. #5 AT 8" O.C. HORIZ BARS
 11. INTENTIONALLY ROUGHENED
CONSTRUCTION JOINT AT
CONTRACTOR'S OPTION
 12. PROVIDE (3) #5 HORIZ E.F.
AT 6" O.C. AT TOP OF 10"
THICK WALL. EXTEND BARS
3'-6" MIN PAST EDGE OF
MANHOLE OPENING.
 13. ACCESS STEPS PER CLARK
COUNTY UNIFORM STANDARD
DRAWING NO. 410
- NOTE:
- A. FOR INFO SHOWN BUT NOT
NOTED SEE DETAIL 2 THIS
SHEET


- KEYNOTES:
1. #5 AT 18" O.C. EA WAY
 2. #6 AT 6" O.C. TRANSVERSE
 3. #5 AT 6" O.C. VERT AND #4 AT 18" O.C. HORIZ EA FACE, W/ STANDARD HOOK ON VERT BARS
 4. #6 AT 11" O.C. LONGITUDINAL LAP LONGITUDINAL BARS 24"
 5. FINAL GRADE
 6. CONCRETE BOX BEDDING PER GSN
 7. WEEP HOLE AND ROCK POCKET SEE PLAN FOR SPACING AND TYPICAL DETAIL 2/SO.1
 8. BACKFILL MATERIAL AND PROCEDURE PER GSN
 9. ROUGHENED CONSTRUCTION JOINT

3 SECTION AT MANHOLE
NO SCALE

- KEYNOTES:
1. SEE APPLICABLE SECTION 1/S2.2 FOR REINF REQUIREMENTS
 2. #4x24" LONG DOWEL AT 12" O.C. DRILL AND EPOXY USE HILTI HY150 OR EQUAL, PROVIDE 6" MIN OF EMBEDMENT
 3. CONCRETE BOX BEDDING PER CSN
 4. RCB, BY OTHERS
 5. FINAL GRADE

4 CAST-IN-PLACE TO PRECAST CONNECTION
NO SCALE

- KEYNOTES:
1. GRATING BY OTHERS
 2. REMOVABLE BEAM PER PLAN
 3. 1/4" STIFFENER EA SIDE
 4. 1/2" BEARING PLATE W/ (2) 1/2"Ø
x4" HEADED STUDS
 5. 1/4" END AND SIDE PLATES W/
1/2"Ø HEADED STUDS

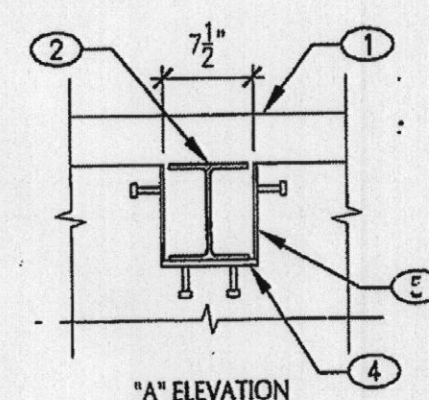

5 GRATING SUPPORT BEAM DETAIL
NO SCALE


1 SECTION AT 12'-0"x9'-0" RCB
NO SCALE

- KEYNOTES:**
1. (5) 20"-0" LONG #6 BOTTOM BARS, ED SPACED TO REPLACE TYP REINF
 2. (3) #5 TOP BARS
 3. #4 STIRRUPS SPACE 6" FROM FACE OF SUPPORT, REMAINING AT 12" O.C.
 4. #4 AT 12" O.C. VERT AND HORIZ BARS, PROVIDE STANDARD HOOK INTO BEAM BELOW ON VERTS
 5. L4x4x1/4" PERIMETER ANGLE W/ 3/4"x4"x4" HEADED STUDS AT 12" O.C.
 6. RCB REINFORCING BARS. REFER TO DETAIL 1/S2.2
 7. FINAL GRADE
 8. BACKFILL MATERIAL AND PROCEDURES PER GSN
 9. INSTALL (2) SECTIONS OF BAR GRATING W/ 2 1/2" DEEP BARS AND 1 3/16" BARS. DESIGN FOR 2000 PSF LIVE LOAD. CONTACT WWW.MCMCHOLDS.COM
 10. #5 AT 8" O.C. HORIZ BARS
 11. INTENTIONALLY ROUGHENED CONSTRUCTION JOINT AT CONTRACTOR'S OPTION
 12. SUPPORT BEAM BEYOND

2 SECTION AT ACCESS MANHOLE OPENING

Copyright © 2007 by E.S. Engineering Solutions, Inc. All rights reserved. No part of this publication may be reproduced, stored in a retrieval system, or transmitted, in any form or by any means, electronic, mechanical, photocopying, recording, or by any information storage and retrieval system, without prior written permission from E.S. Engineering Solutions, Inc.


1 TAPERED RCB TRANSITION SECTION
NO SCALE

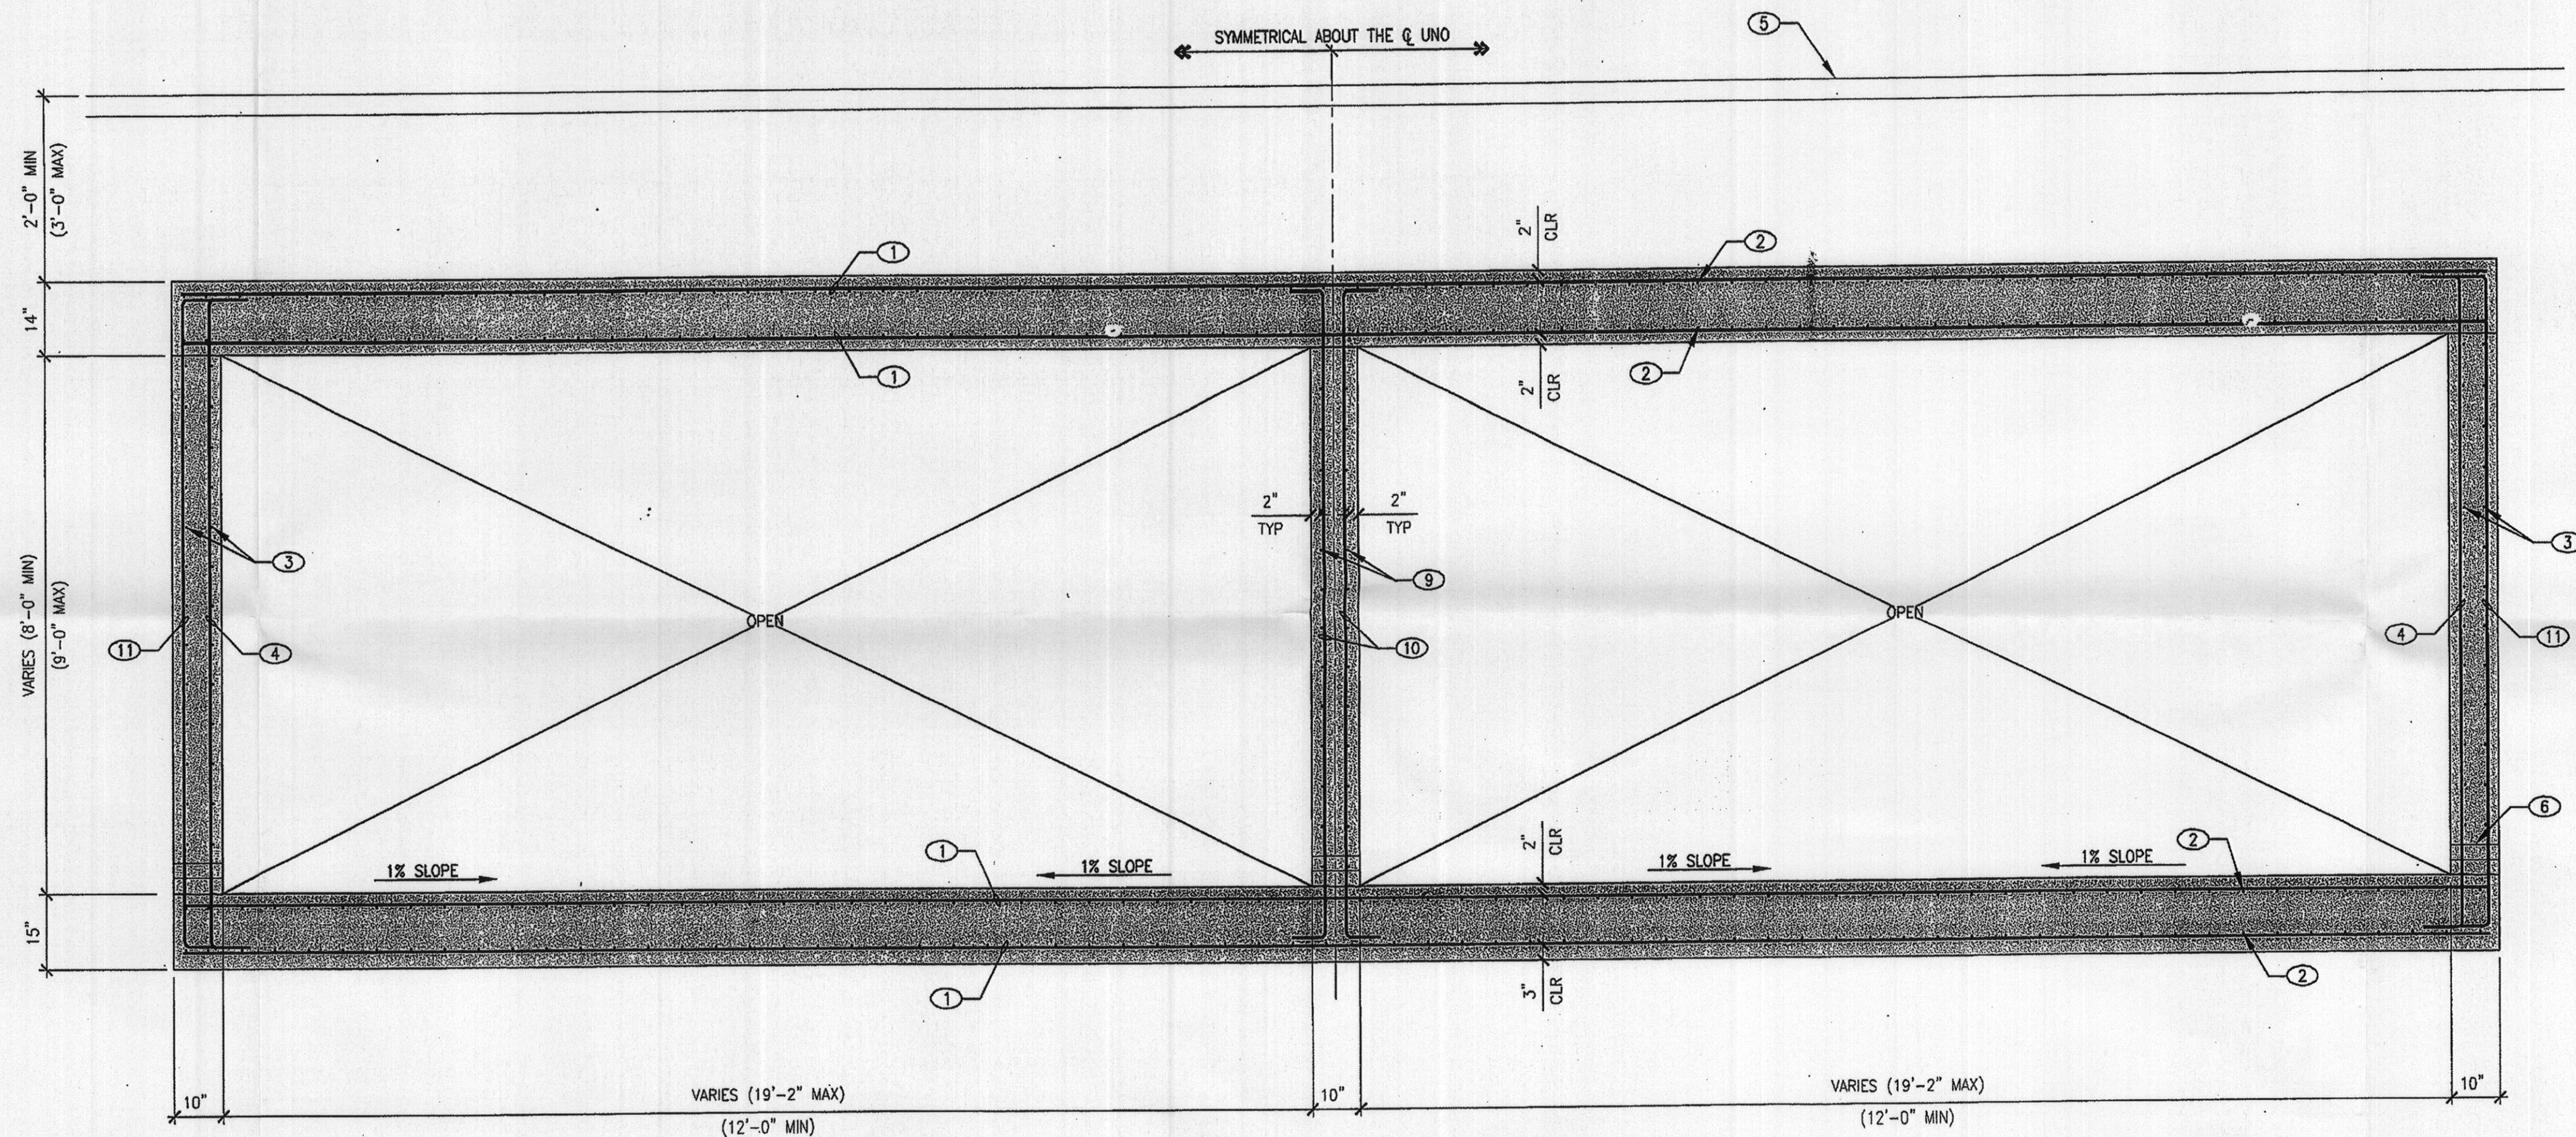

KEYNOTES:

- #6 TRANSVERSE AT 5" O.C.
- #5 LONGITUDINALS AT 7" O.C.
- #4 HORIZ AT 12" O.C. E.F.
- #5 VERTS AT 7" O.C. W/ STANDARD HOOK T&B
- FINISH GRADE
- WEEP HOLE AND ROCK POCKET, SEE PLAN FOR SPACING PER TYPICAL DETAIL 2/SO.1
- BACKFILL MATERIAL AND PROCEDURE PER GSN
- CONCRETE BOX BEDDING PER GSN
- #4 AT 12" O.C. HORIZ
- #5 VERTS AT 9" O.C. VERT W/ W/ STANDARD HOOK T&B
- #5 VERTS AT 18" O.C. W/ STANDARD HOOK T&B

2 TRANSITION SECTION
NO SCALE

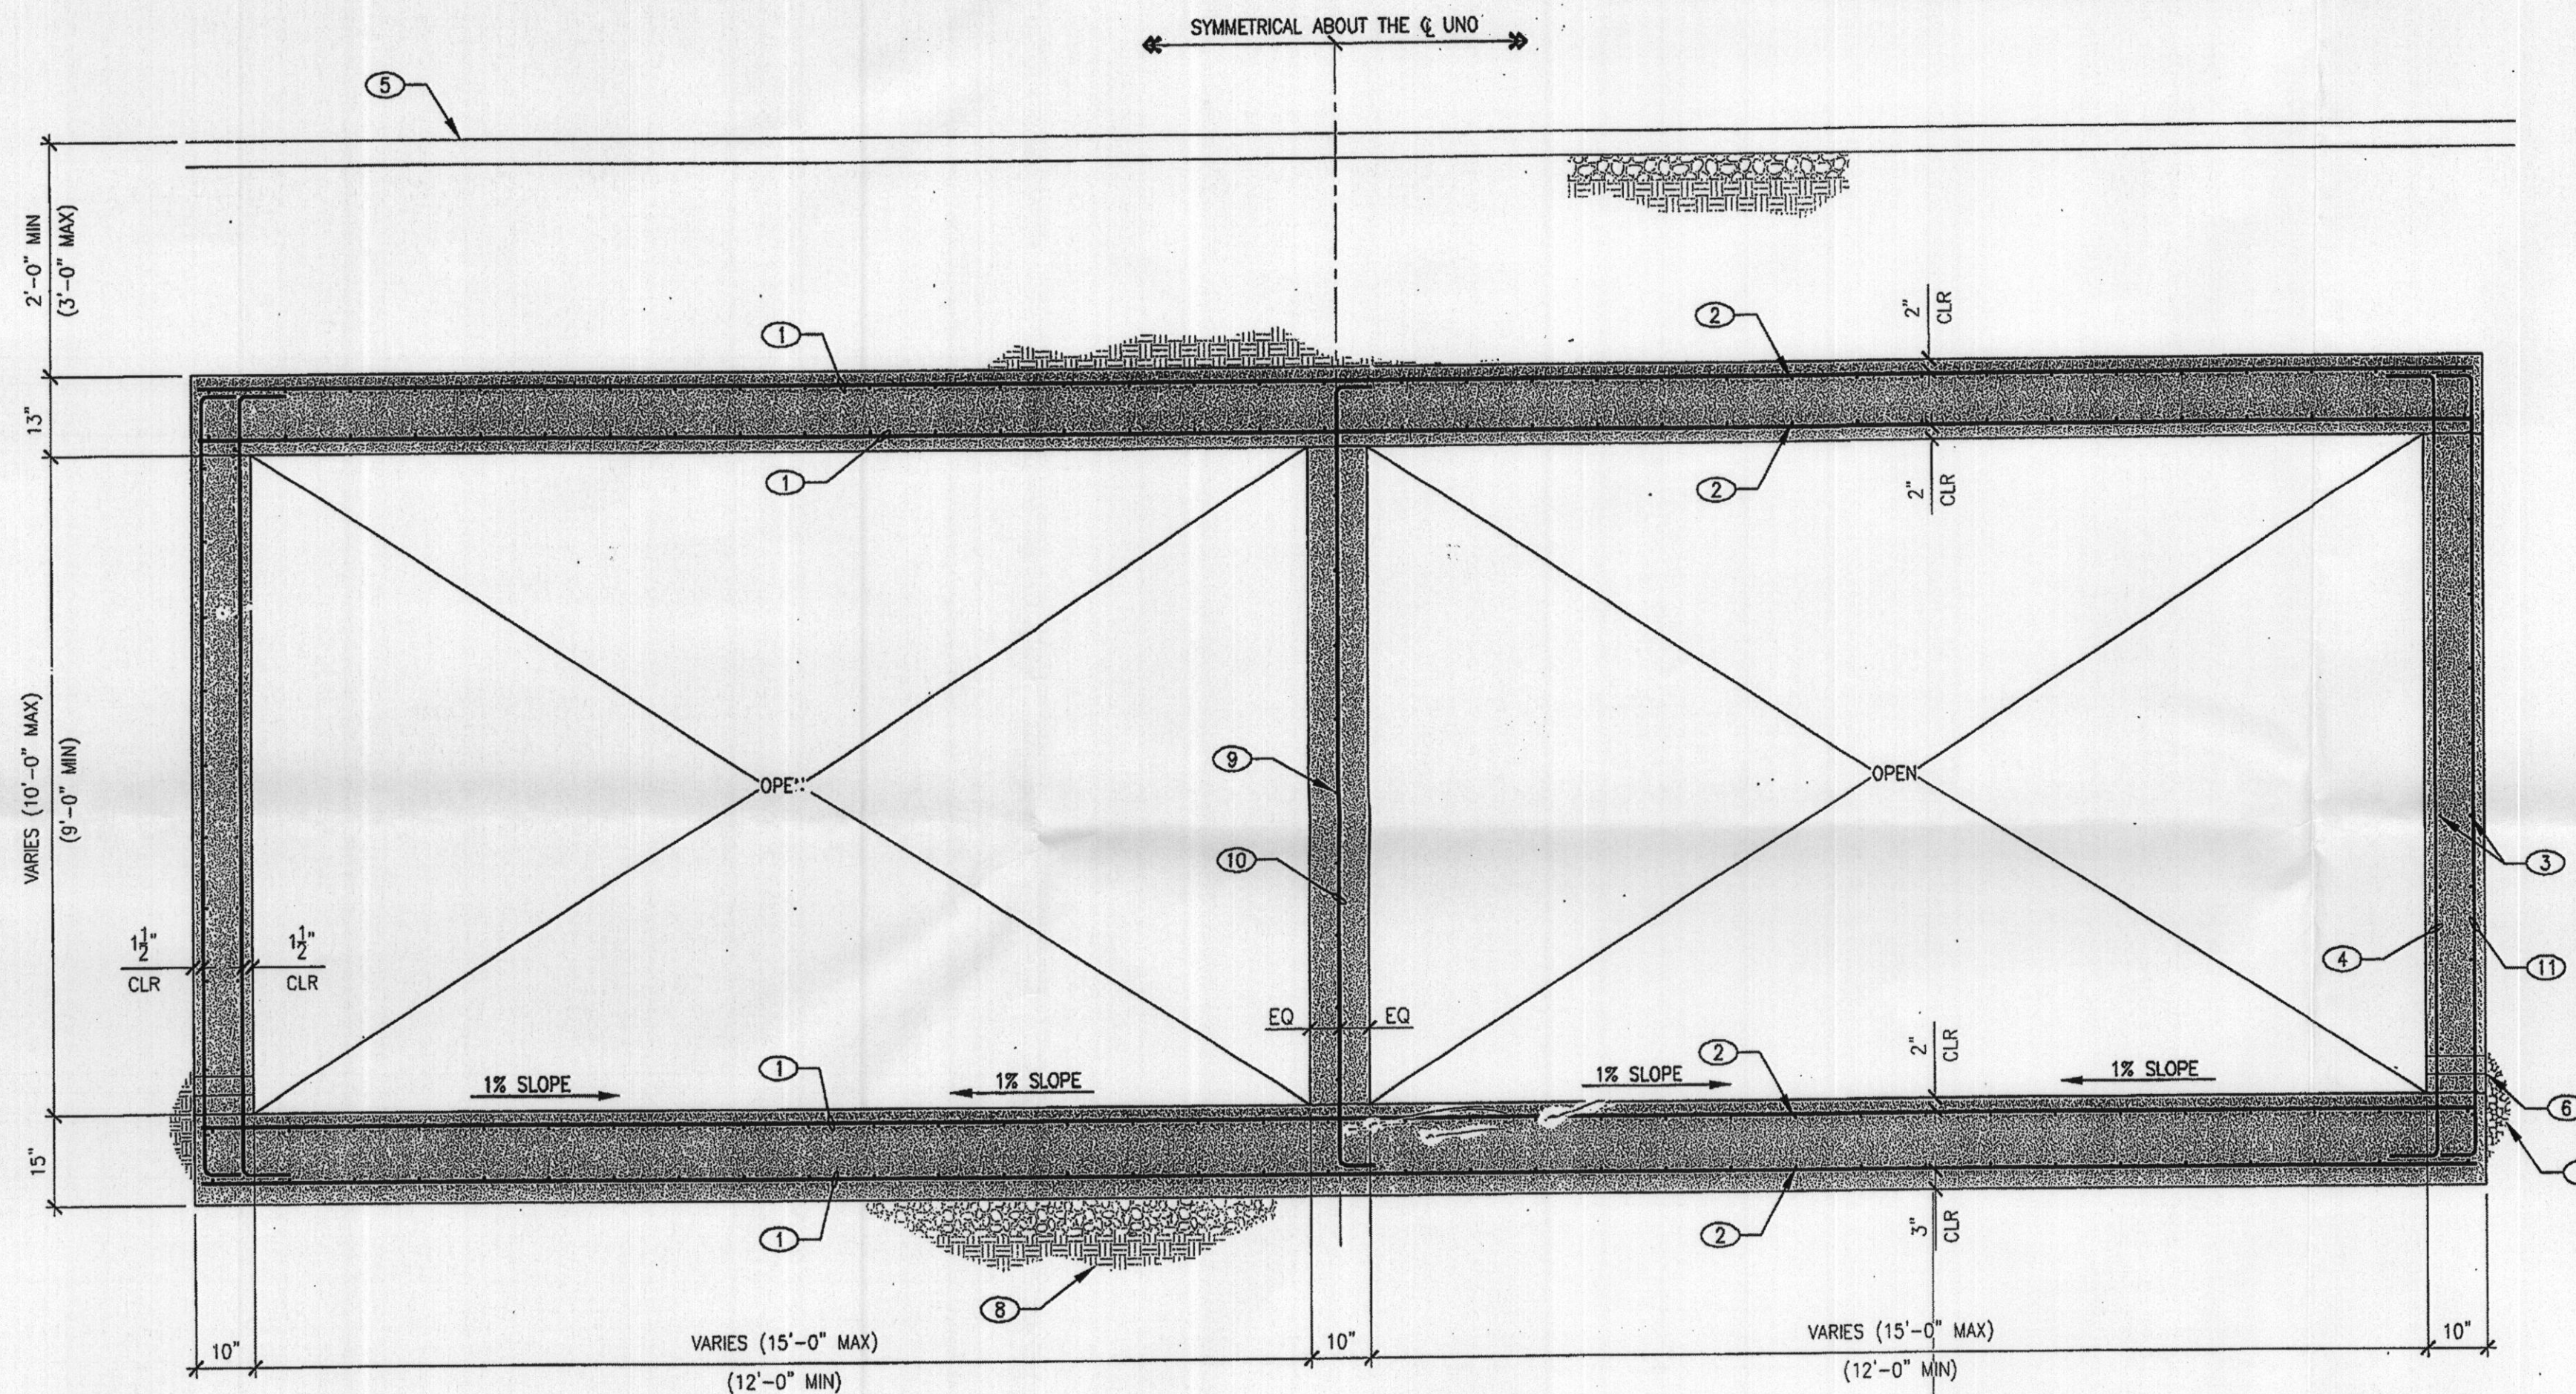

KEYNOTES:

- #6 TRANSVERSE AT 7" O.C. T&B
- #6 LONGITUDINALS AT 13" O.C. T&B
- #4 HORIZ AT 12" O.C. E.F.
- #5 VERTS AT 7" O.C. W/ STANDARD HOOK T&B
- FINISH GRADE
- WEEP HOLE AND ROCK POCKET, SEE PLAN FOR SPACING PER TYPICAL DETAIL 2/SO.1
- BACKFILL MATERIAL AND PROCEDURE PER GSN
- CONCRETE BOX BEDDING PER GSN
- #4 AT 12" O.C. HORIZ
- #5 VERTS AT 12" O.C. VERT W/ W/ STANDARD HOOK T&B
- #5 VERTS AT 14" O.C. W/ STANDARD HOOK T&B

SEAL

REGISTERED PROFESSIONAL ENGINEER - STATE OF NEVADA
GREG A. MEYER
Exp. 12/31/07
E.S. ENGINEERING SOLUTIONS

Aug. 28, 2007

6380 S. VALLEY VIEW, STE 406
LAS VEGAS, NEVADA 89118
Phone: (702) 616-3107
Fax: (702) 616-3725

STRUCTURAL ENGINEERING

ENGINEERING

PROJECT

PARADISE VILLAGE
STORM DRAIN TRANSITION STRUCTURE
LAS VEGAS, NV

SHEET TITLE

SECTIONS


REV.	DESCRIPTION	DATE
1	SUBMITTED FOR APPROVAL	8/20/07
2	SUBMITTED FOR APPROVAL	4/17/07
3	SUBMITTED FOR APPROVAL	4/10/07
4	SUBMITTED FOR APPROVAL	11/14/06

DRAWN: JDB CHECKED: BHL


DATE: NOVEMBER 14, 2006
PROJECT NUMBER: LV06108
SHEET NUMBER: 26 OF 29

S2.2

* DIMENSIONS SHOWN ARE APPROXIMATED BASED ON THE CIVIL DRAWINGS. REFERENCE CIVIL DRAWINGS FOR EXACT DIMENSIONS AND STATIONS.

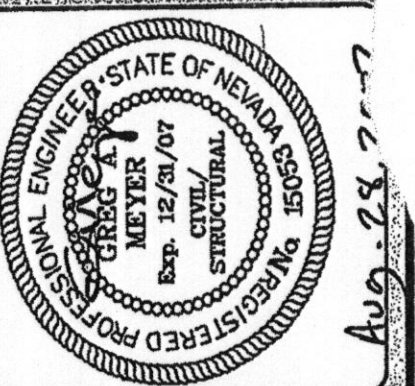

6380 S. VALLEY VIEW, STE 406
LAS VEGAS, NEVADA 89118
Phone: (702) 616-3107
Fax: (702) 616-3725

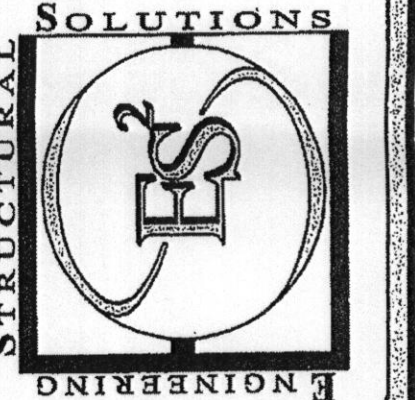



PARADISE VILLAGE
STORM DRAIN TRANSITION STRUCTURE
LAS VEGAS, NV

PLAN VIEWS




PROJECT:

REV.	DESCRIPTION	DATE
1	SUBMITTED FOR APPROVAL	6/20/07
2	SUBMITTED FOR APPROVAL	6/20/07
3	SUBMITTED FOR APPROVAL	4/17/07
4	SUBMITTED FOR APPROVAL	4/10/07
5	SUBMITTED FOR APPROVAL	1/14/06
6	SUBMITTED FOR APPROVAL	6/28/06



DRAWN: JDB
CHECKED: BHL
DATE: NOVEMBER 14, 2006
PROJECT NUMBER: LV06108
SHEET NUMBER: 24 OF 29
S1.3

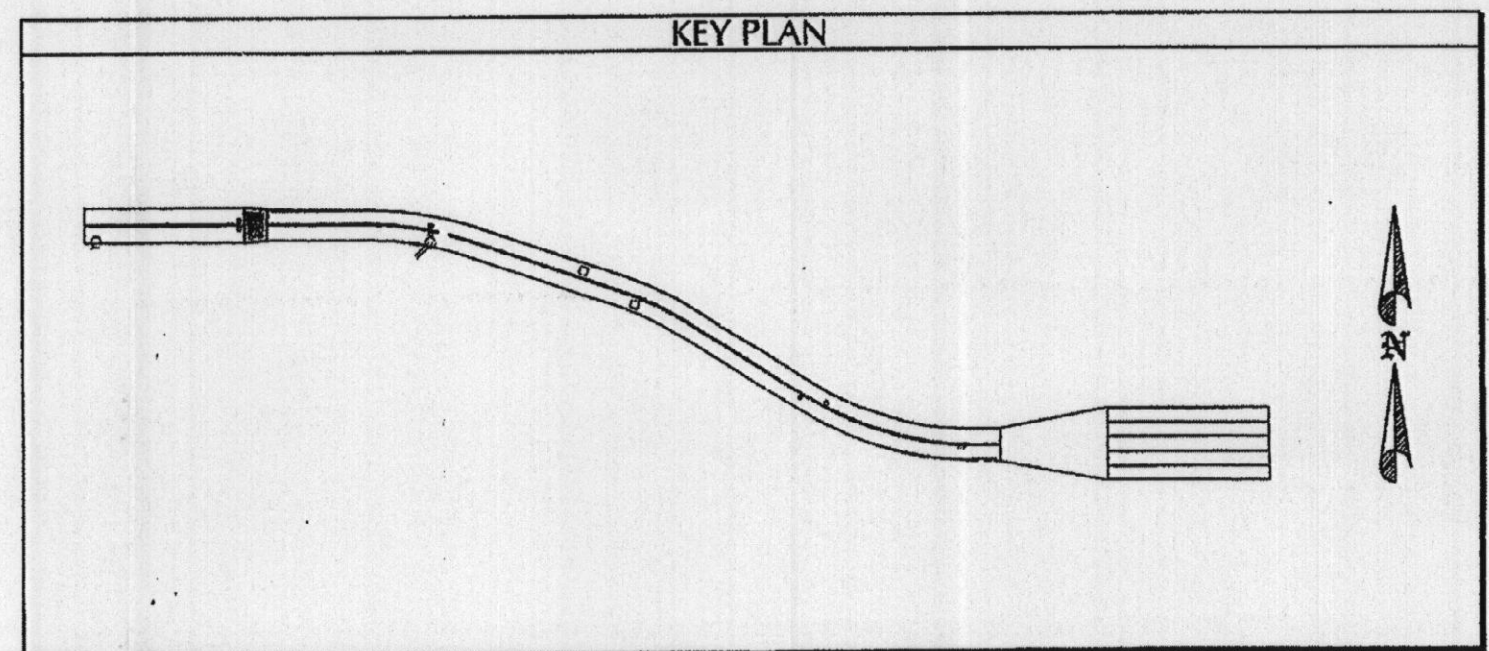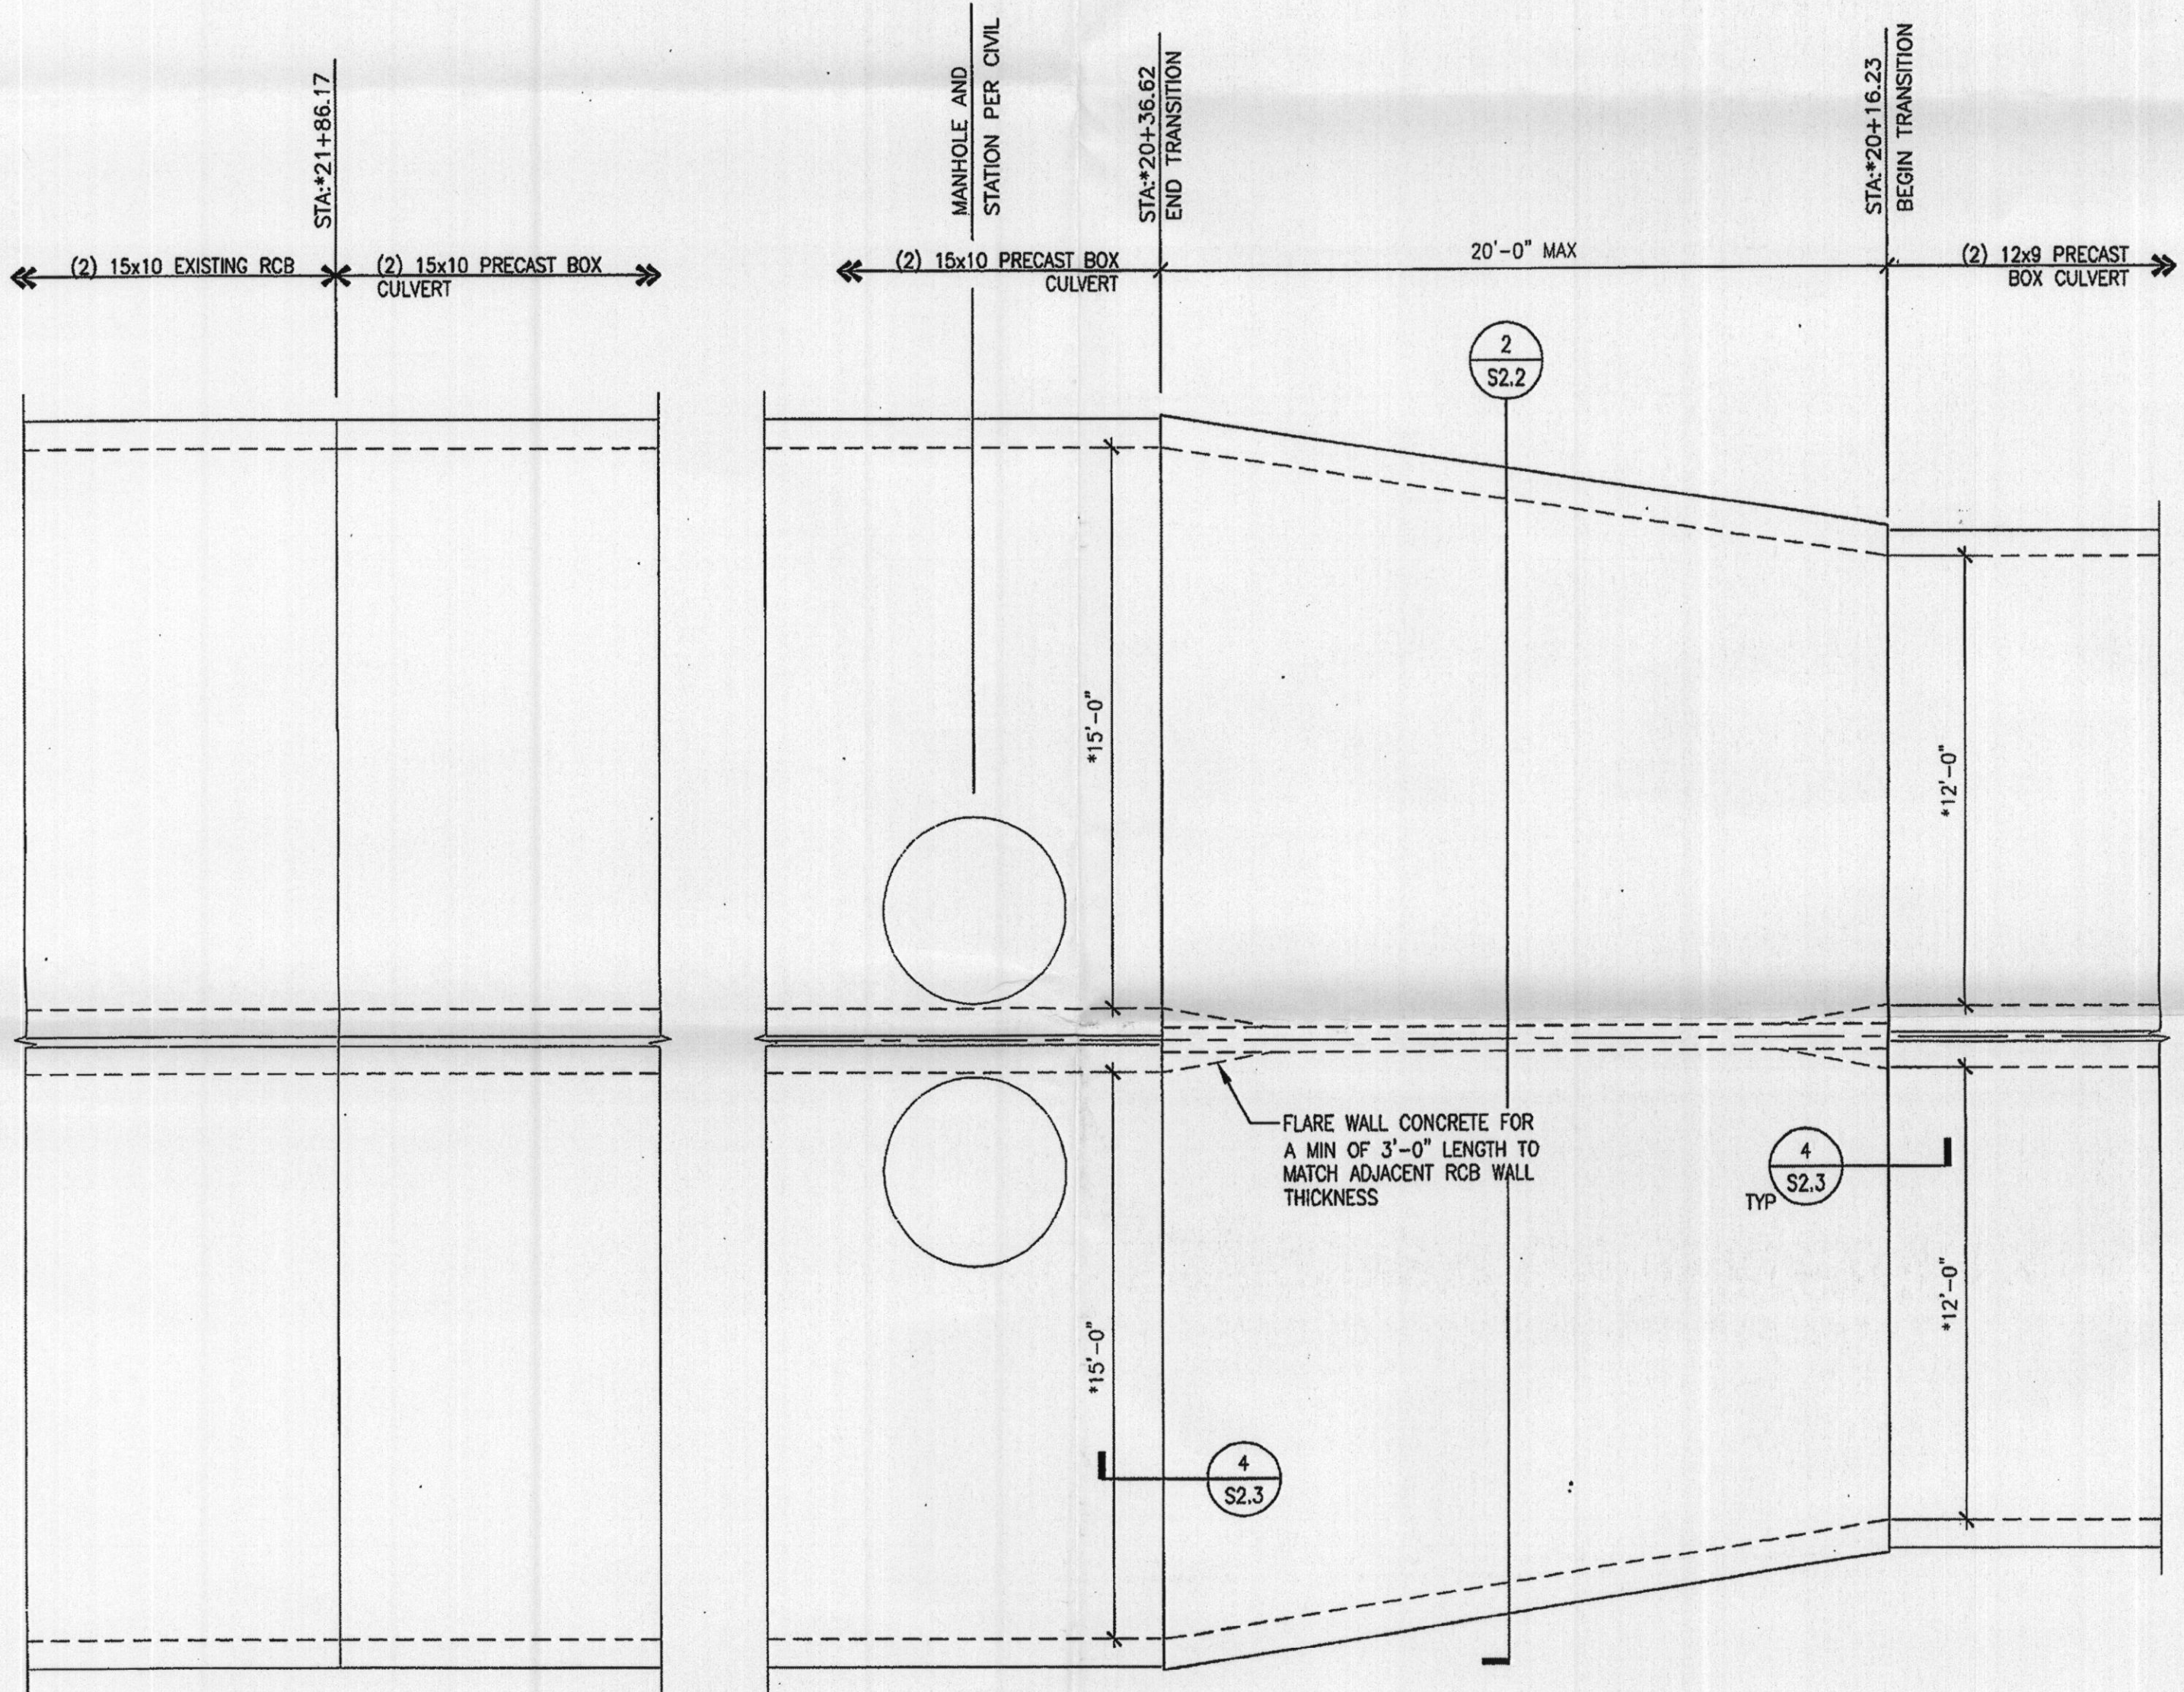

TRANSITION PLAN VIEW SCALE: 1/4"=1'-0"

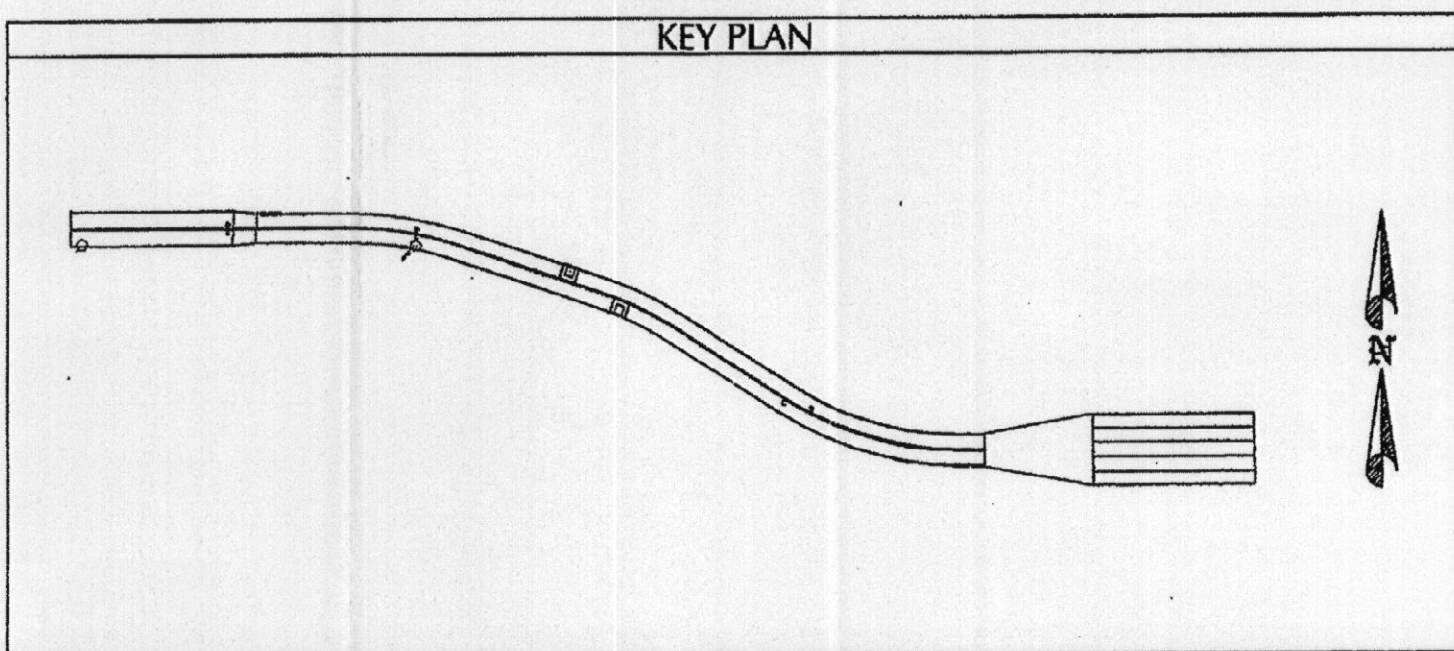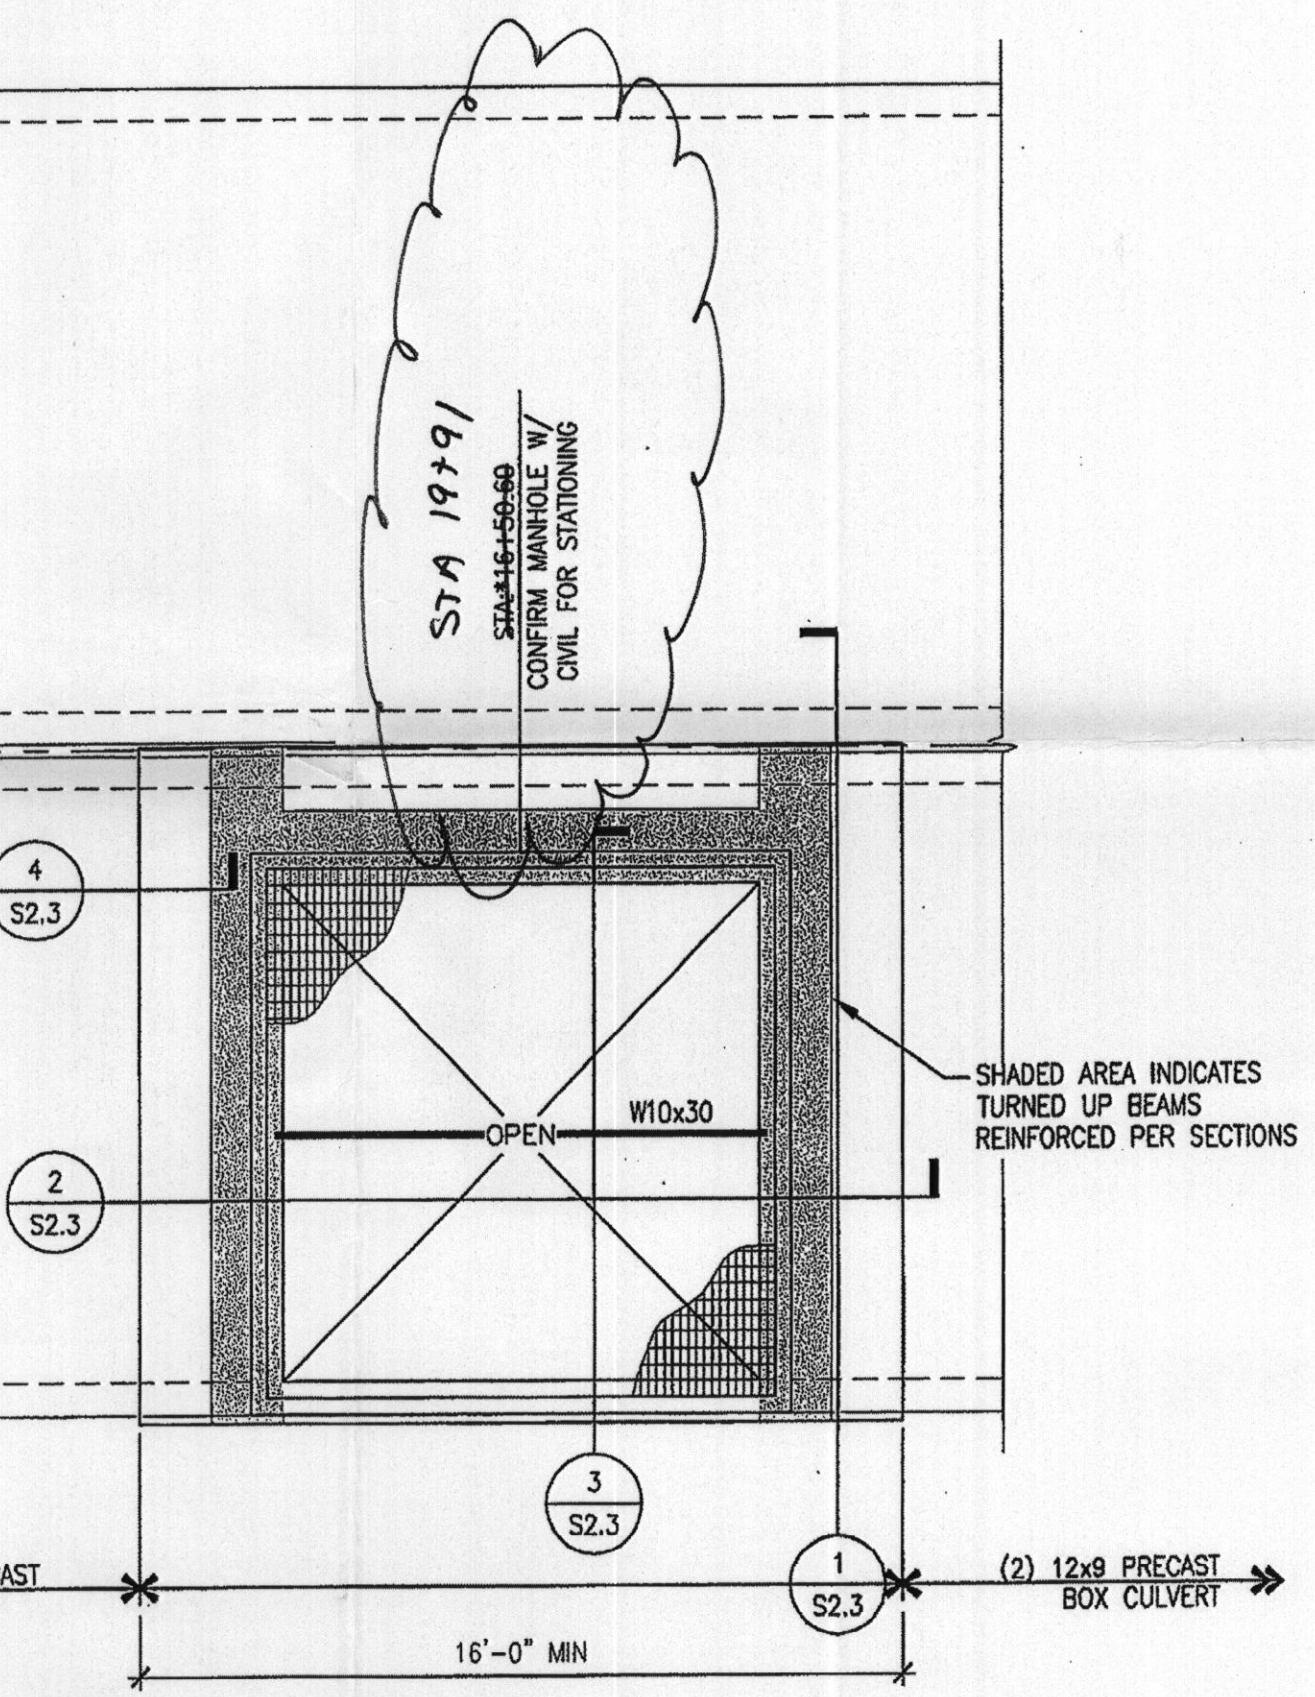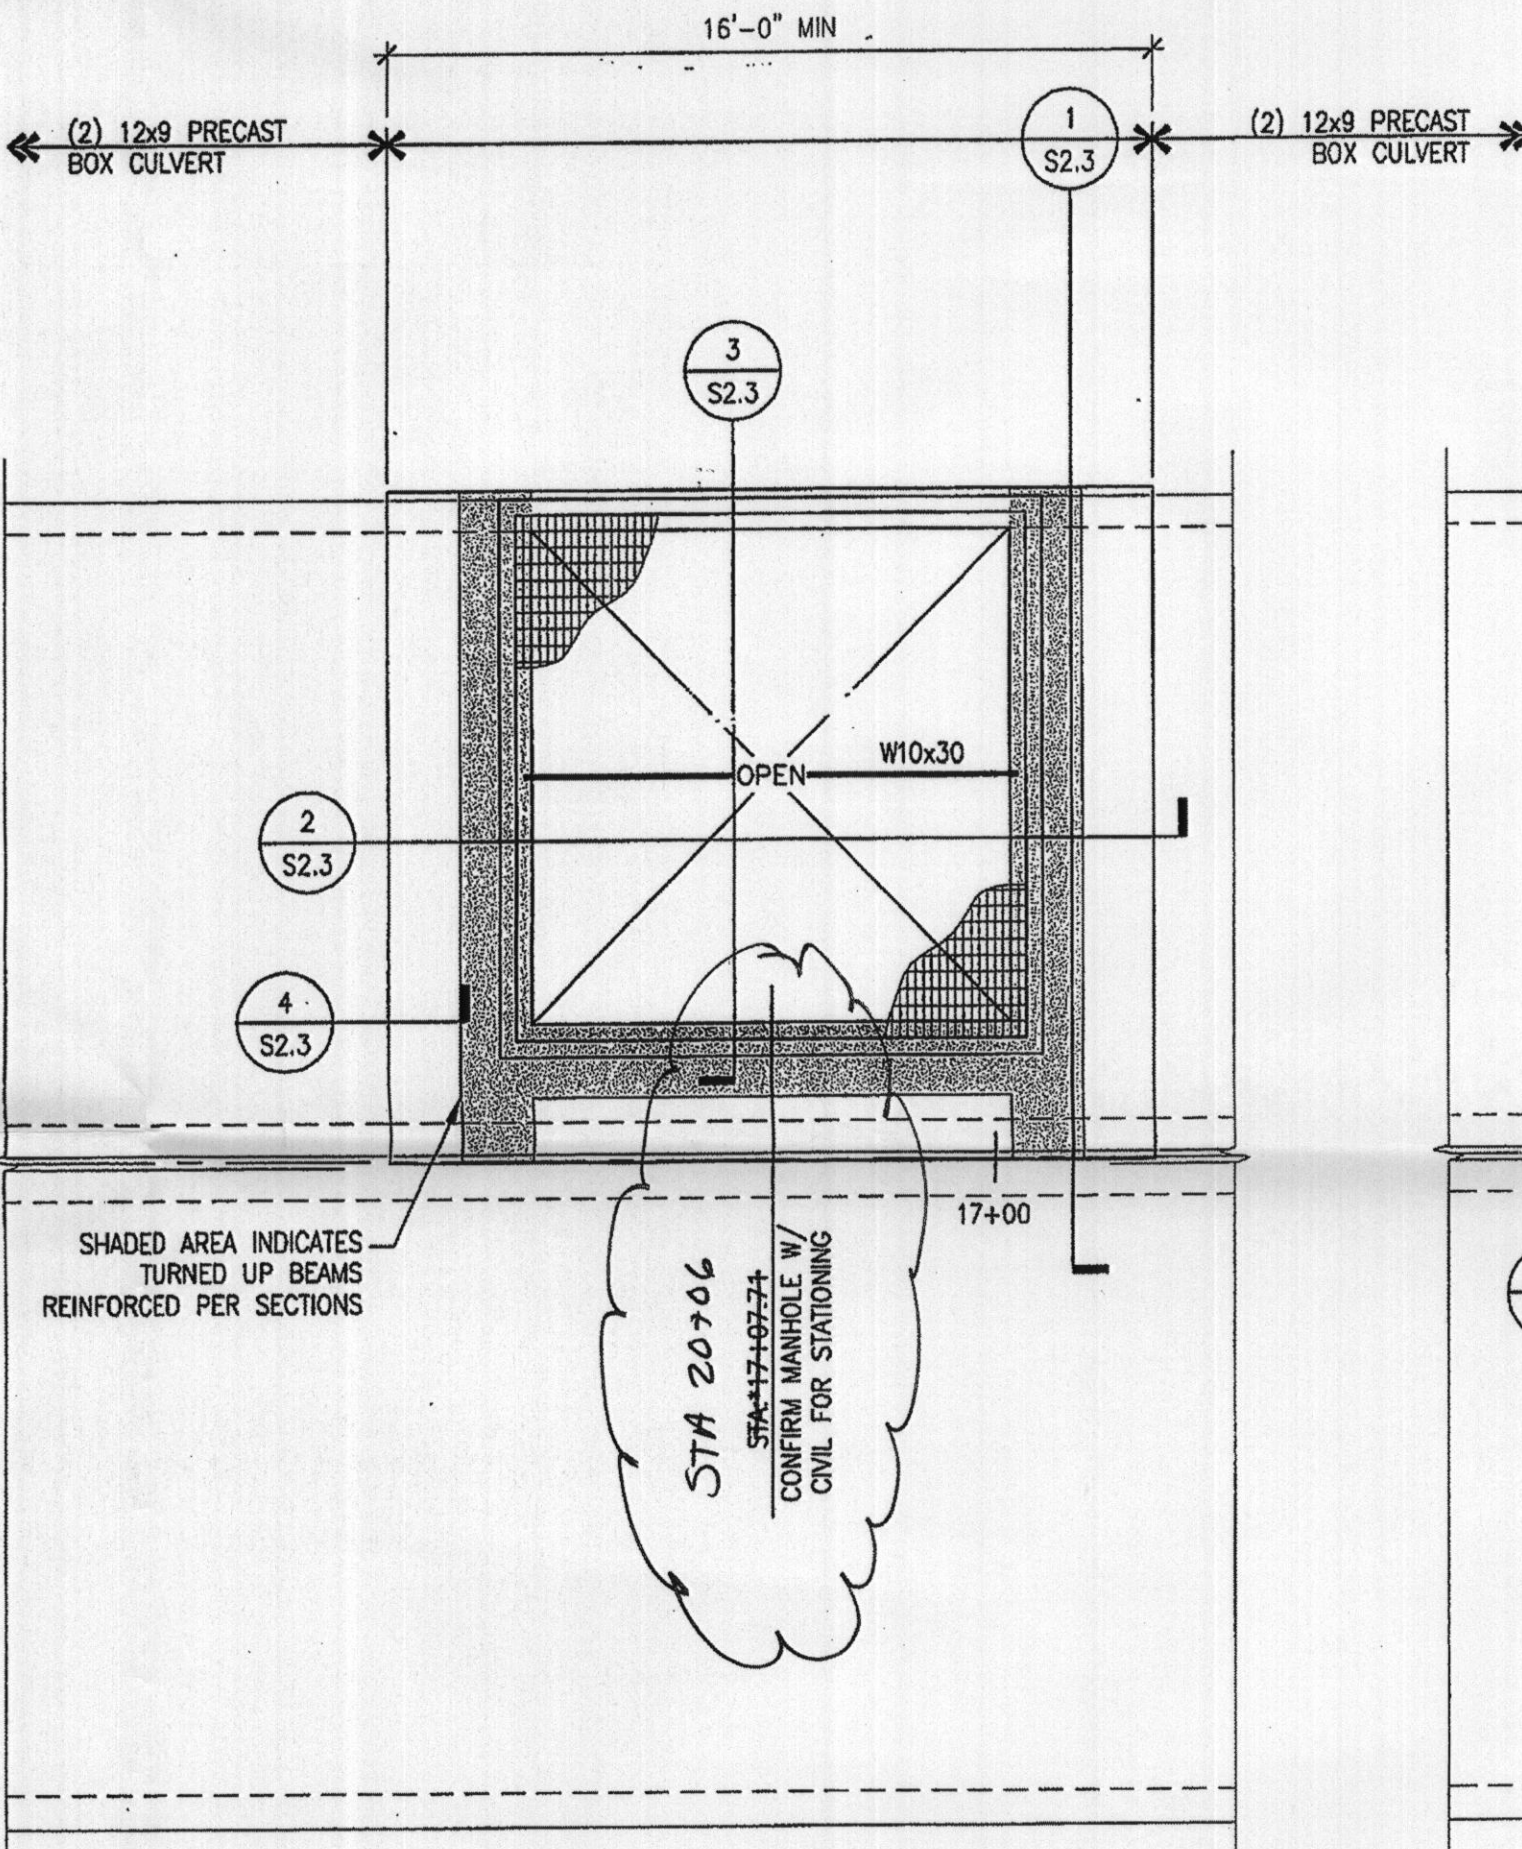


ACCESS MANHOLE PLAN VIEW SCALE: 1/4"=1'-0"

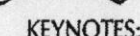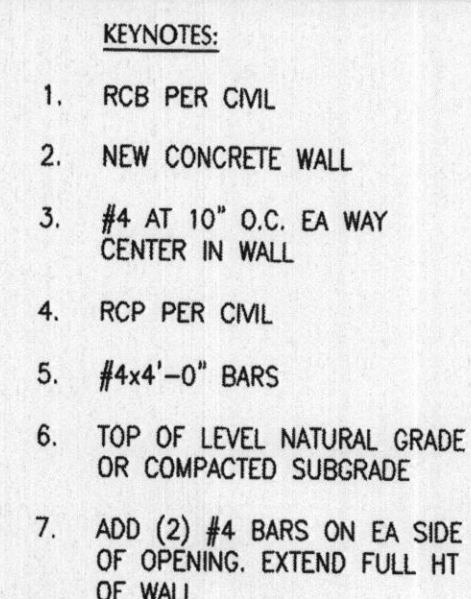


1. EXISTING GRADE
2. EXISTING PRECAST RCB BY OTHERS
3. PRECAST RCB JOINT
4. #4 REBAR AT 18" O.C. EA WAY
5. #4 REBAR W/ STD HOOK AT 18" O.C.
DRILL AND EPOXY W/ SIMPSON SET
EPOXY OR EQUIVALENT. MIN EMBED
4". SPECIAL INSPECTION REQ'D
FOR ALL EPOXY CONSTRUCTION

NOTES:

- A. THIS FIELD FIX SHALL BE USED WHERE PRECAST BOX JOINT GAPS EXCEED 2 1/4" BUT ARE 3 1/4" OR LESS
- B. CONTRACTOR SHALL EXTEND FIX DOWN EXPOSED SIDE OF BOX AND ENSURE EPOXIED REBAR PER KEYNOTE #5 IS AT EA END
- C. THIS FIELD FIX IS FOR THE GAP BETWEEN PRECAST BOXES, AND IN NO WAY ANALYZES, RECOMMENDS, OR APPROVES OF THE PRECAST RCB'S THAT ARE EXISTING

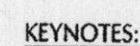


1. EXISTING RCB AND HEADWALL
2. REINFORCING AT CIP SECTION
PER DETAIL 2/S2.2
3. NEW PRECAST RCB BY OTHERS
4. #4x23" REBAR DRILL AND EPOXY
USING SIMPSON SET OR EQUIVALENT.
5" MIN EMBED. SPECIAL INSTRUCTION
REQ'D FOR EPOXY CONSTRUCTION
5. SAWCUT AND REMOVE TOP OF
EXISTING HEADWALL AS REQ'D. TRIM
TOP OF BOX AS OCCURS. PROVIDE
EPOXY SEALANT COATING ON SAWCUT
FACE AT EA EXPOSED REBAR

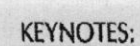

1. TOP SLAB OF EXISTING RCB
2. TOP OF NEW CONC GUTTER PER CIVIL PLANS
3. THICKNESS OF NEW CONC GUTTER AS REQ'D PER CIVIL. MIN 4" THICKNESS
4. #4 REBAR AT 12" O.C. EA WAY
5. IF THICKNESS OF NEW CONC GUTTER IS 10" OR GREATER, CONTRACTOR SHALL PLACE SECOND MAT OF REINFORCEMENT AS SHOWN W/ #4 REBAR AT 12" O.C. EA WAY
6. DRILL AND EPOXY #4 DOWELS W/ STD HOLE AT 18" O.C. EA WAY USING SIMPSON SET OR EQUIVALENT. MIN EMBED 5". SPECIAL INSPECTION REQ'D FOR EPOXY CONSTRUCTION

NOTES:

- A. LOCATION OF CONC GUTTER PER CIVL

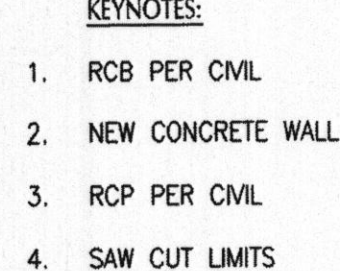

- KEYNOTES:
1. RCB PER CIVIL
 2. NEW CONCRETE WALL
 3. #4 BENT DOWEL AT 12" O.C.
EA WAY W/ STANDARD HOOK.
EMBED 5" MIN W/ SIMPSON SET EPOXY
 4. RCP PER CIVIL
 5. TOP OF LEVEL NATURAL GRADE OR
COMPACTED SUBGRADE

Willdan
Paradise Village Structural

WILLDAN
SERVING PUBLIC AGE

FEB 20 2008

RECEIVED
LAS VEGAS

SEAL:

TOP SLAB PLAN

SHEET TTT.B:

REV.	DESCRIPTION	DATE
	SUBMITTED FOR APPROVAL	8/2/07
	SUBMITTED FOR APPROVAL	6/20/07
	SUBMITTED FOR APPROVAL	4/17/07
	SUBMITTED FOR APPROVAL	4/10/07
	SUBMITTED FOR APPROVAL	1/14/06
	SUBMITTED FOR APPROVAL	6/28/06

DRAWN: JDB	CHECKED: BHL
---------------	-----------------

DATE: NOVEMBER 14, 2006
PROJECT NUMBER: LV06108
SHEET NUMBER: 23 OF 29

\$1.2



routing: f:\p17\2002\1\006108\ACAD\1\006108_511_512.dwg Last Saved: Tue Aug 28, 2007 - 1:23pm By: jerry
 Last Plotted: Tue Aug 28, 2007 - 1:25pm

BEAL:


FOUNDATION PLAN

SHEET TITLE:

	SUBMITTED FOR APPROVAL	8/20/07
	SUBMITTED FOR APPROVAL	4/17/07
	SUBMITTED FOR APPROVAL	4/10/07
	SUBMITTED FOR APPROVAL	11/14/06
	SUBMITTED FOR APPROVAL	6/28/06

DRAWN:	CHECKED:
JDB	BHL
DATE: NOVEMBER 14, 2000	
PROJECT NUMBER: LV0610	
SHEET NUMBER: 22 OF 2	

\$1.1

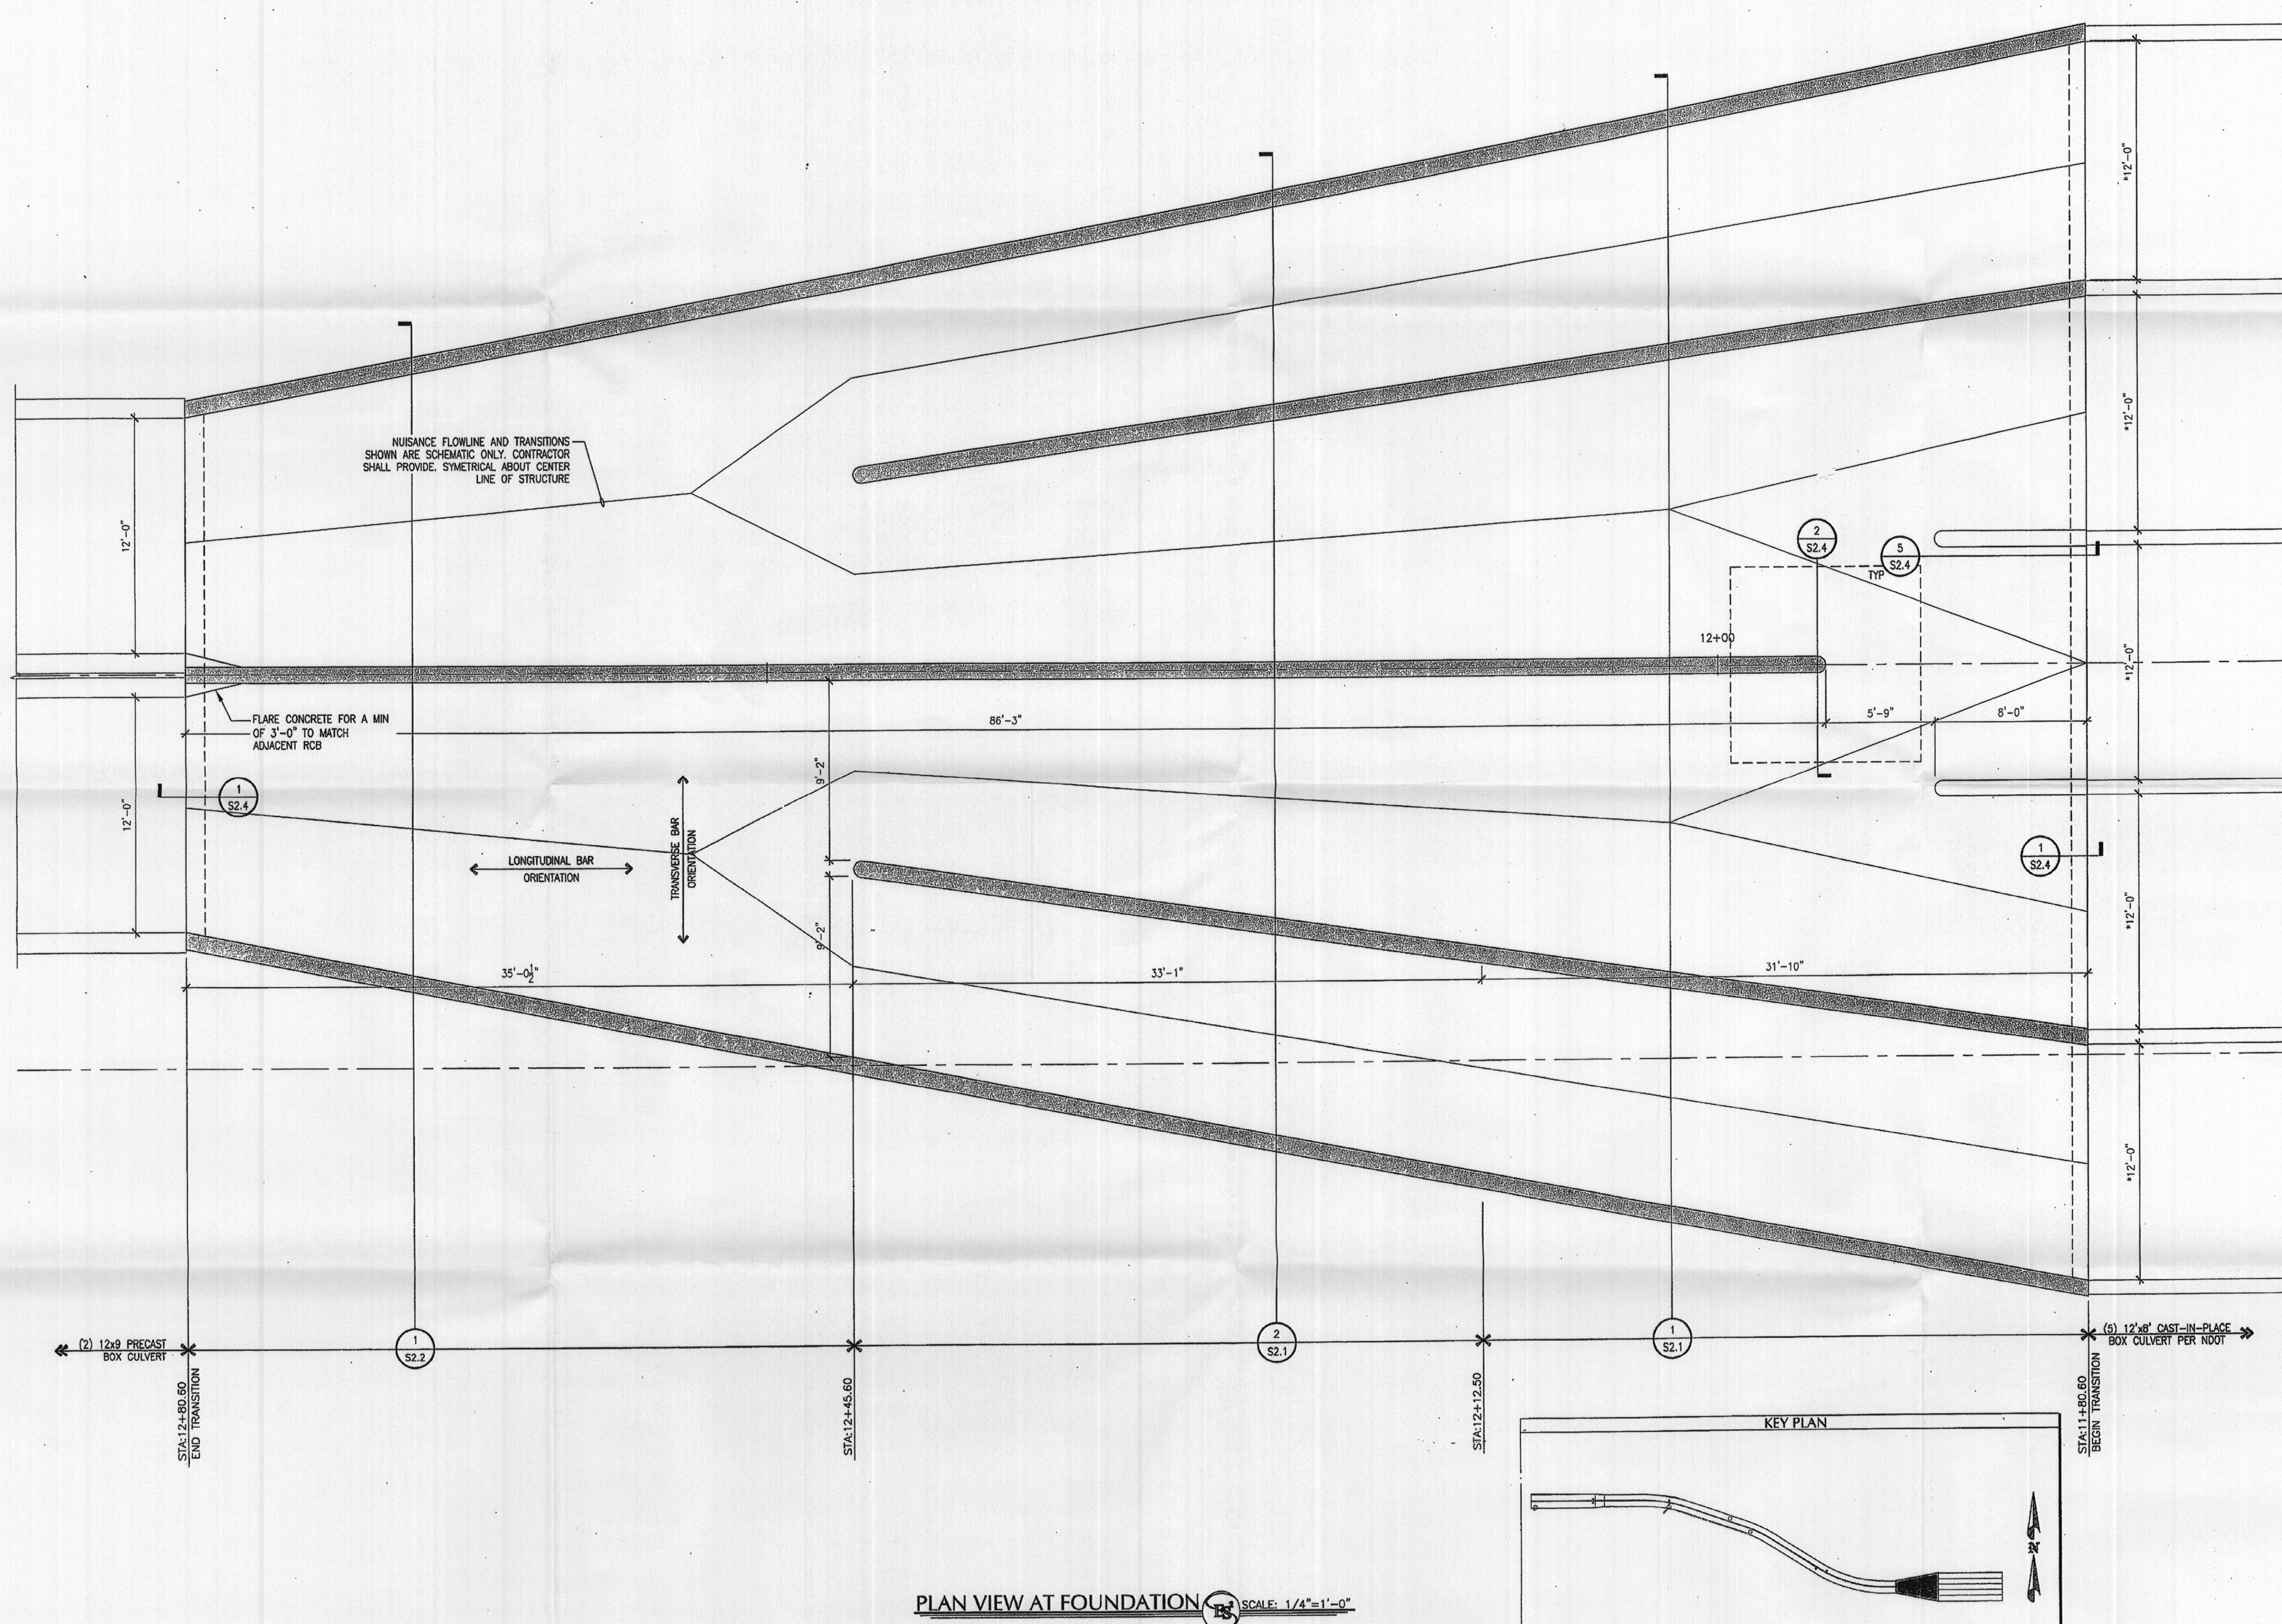

PLAN VIEW AT FOUNDATION SCALE: 1/4"=1'-0"

running: c:\DATA\2006\1\1405108\ACAD\1_51_2.dwg Last Saved: Tue Aug 28, 2007 - 1:23pm Last Plotted: Tue Aug 28, 2007 - 1:23pm By: jirany

GENERAL STRUCTURAL NOTES

GENERAL REQUIREMENTS

- THESE DRAWINGS HAVE BEEN PREPARED USING STANDARDS OF PROFESSIONAL CARE AND COMPLETENESS NORMALLY EXERCISED UNDER SIMILAR CIRCUMSTANCES BY REPUTABLE STRUCTURAL ENGINEERS IN THIS OR SIMILAR LOCALITIES. THEY NECESSARILY ASSUME THAT THE WORK DEPICTED WILL BE PERFORMED BY AN EXPERIENCED CONTRACTOR AND/OR WORKMEN WHO HAVE A WORKING KNOWLEDGE OF THE APPLICABLE CODE STANDARDS AND REQUIREMENTS AND OF INDUSTRY ACCEPTED STANDARD GOOD PRACTICE. AS NOT EVERY CONDITION OR ELEMENT IS (OR CAN BE) EXPLICITLY SHOWN ON THESE DRAWINGS, IT IS UNDERSTOOD THAT THE CONTRACTOR WILL USE INDUSTRY ACCEPTED STANDARD GOOD PRACTICE FOR ALL MISCELLANEOUS WORK NOT EXPLICITLY SHOWN.
- THESE DRAWINGS REPRESENT THE FINISHED STRUCTURE. THEY DO NOT INDICATE THE METHOD OF CONSTRUCTION. THE CONTRACTOR SHALL BE SOLELY RESPONSIBLE FOR CONSTRUCTION MEANS, METHODS, TECHNIQUES, SEQUENCES AND PROCEDURES. IT SHALL BE THE CONTRACTOR'S RESPONSIBILITY TO DESIGN AND PROVIDE ADEQUATE SHORING, BRACING, FORM-WORK, ETC., AS REQUIRED FOR THE PROTECTION OF LIFE AND PROPERTY DURING CONSTRUCTION. CONSTRUCTION MATERIALS SHALL BE UNIFORMLY SPREAD OUT SUCH THAT DESIGN LIVE LOAD PER SQUARE FOOT AS STATED HEREIN IS NOT EXCEEDED. VISITS TO THE SITE BY THE STRUCTURAL ENGINEER SHALL NOT INCLUDE INSPECTION OF THE ABOVE ITEMS.
- THE CONTRACTOR SHALL BE RESPONSIBLE FOR ALL EXCAVATION PROCEDURES INCLUDING SHORING AND PROTECTION OF ADJACENT PROPERTY, STRUCTURES, STREETS AND UTILITIES IN ACCORDANCE WITH THE LOCAL BUILDING DEPARTMENT. ALL WORK OR CONSTRUCTION SHALL COMPLY WITH ALL APPLICABLE BUILDING CODES, REGULATIONS AND SAFETY REQUIREMENTS.
- THE CONTRACTOR SHALL BE RESPONSIBLE FOR VERIFICATION OF ALL DIMENSIONS, CONDITIONS AND ELEVATIONS WITH CIVIL DRAWINGS PRIOR TO START OF CONSTRUCTION. THE CONTRACTOR SHALL INFORM THE CIVIL ENGINEER AND/OR STRUCTURAL ENGINEER IN WRITING OF ANY DISCREPANCIES OR OMISSIONS NOTED ON THE DRAWINGS. ANY SUCH DISCREPANCY, OMISSION, OR VARIATION NOT REPORTED BEFORE START OF CONSTRUCTION SHALL BE THE RESPONSIBILITY OF THE CONTRACTOR. WHERE DISCREPANCIES OCCUR IN THESE DRAWINGS, NOTES AND DETAILS ON DRAWINGS SHALL TAKE PRECEDENCE OVER GENERAL STRUCTURAL NOTES AND TYPICAL DETAILS.
- WHERE REFERENCE IS MADE TO VARIOUS TEST STANDARDS FOR MATERIALS, SUCH STANDARDS SHALL BE THE LATEST EDITION AND/OR ADDENDA.
- OPTIONS ARE FOR CONTRACTOR'S CONVENIENCE. IF ANY OPTION IS USED, THE CONTRACTOR SHALL USE THE LATEST EDITION AND/OR ADDENDA.
- ESTABLISH AND VERIFY ALL OPENINGS AND INSERTS FOR CIVIL AND ELECTRICAL REQUIREMENTS WITH APPROPRIATE TRADES, DRAWINGS AND SUBCONTRACTORS PRIOR TO CONSTRUCTION.
- OWNER SHALL BE RESPONSIBLE FOR THE COSTS OF ALL INSPECTIONS WHETHER PERFORMED BY AN AGENCY, INDEPENDENT CONSULTANT OR STRUCTURAL ENGINEER. ALL INSPECTIONS REQUIRED BY THE BUILDING CODES, LOCAL BUILDING DEPARTMENTS OR BY THESE PLANS SHALL BE PROVIDED BY AN INDEPENDENT INSPECTION COMPANY OR THE BUILDING DEPARTMENT. SITE VISITS BY THE ENGINEER DO NOT CONSTITUTE AN INSPECTION, UNLESS SPECIFICALLY CONTRACTED FOR.
- SHOP DRAWINGS SHALL BE SUBMITTED FOR ALL STRUCTURAL ITEMS. SHOP DRAWINGS ARE REVIEWED ONLY FOR GENERAL COMPLIANCE WITH THE STRUCTURAL DRAWINGS. REVIEW DOES NOT INDICATE THAT THE SHOP DRAWINGS ARE CORRECT OR COMPLETE. RESPONSIBILITY FOR CORRECTNESS SHALL REST WITH THE CONTRACTOR. ANY CHANGES, SUBSTITUTIONS, OR DEVIATIONS FROM CONTRACT DRAWINGS SHALL BE CLOUDED. ANY OF THE AFOREMENTIONED SHALL NOT BE CONSIDERED APPROVED AFTER ENGINEERS REVIEW UNLESS SPECIFICALLY NOTED ACCORDINGLY. THE SHOP DRAWINGS DO NOT SUPERSEDE OR REPLACE THE ORIGINAL CONTRACT DRAWINGS. ANY ENGINEERING PROVIDED BY OTHERS AND SUBMITTED FOR REVIEW SHALL BEAR THE SEAL OF AN APPROPRIATELY REGISTERED ENGINEER. ES2 SHALL NOT BE RESPONSIBLE FOR THE ADEQUACY OF ENGINEERING DESIGNS PERFORMED BY THE OTHERS. ALLOW 5 WORKING DAYS FOR THE ENGINEER OF RECORD'S REVIEW. ONE COPY OF EACH SUBMITTAL WILL BE RETAINED BY THE ENGINEER OF RECORD.

DESIGN BASIS

- PARADISE VILLAGE-STORM DRAIN TRANSITION STRUCTURES
- CODE: AASHTO 1996 ed. STANDARD SPECIFICATIONS
- DEAD LOAD: STRUCTURE SELF WEIGHT CONCRETE = 150 pcf
VARYING COVER WITH A SOIL BACKFILL DENSITY = 120pcf
- LIVE LOAD: HS20-44 LOADING

FOUNDATION

- THE FOUNDATIONS FOR THE ABOVE REFERENCED PROJECT ARE DESIGNED WITH RECOMMENDATIONS FROM AMT ILL. FILE# 05208 DATED NOVEMBER 2, 2005. ALL RECOMMENDATIONS LISTED WITH IN THE GEO TECH REPORT REGARDING SITE PREPARATION, GRADING, COMPACTION TESTS, INSPECTIONS ETC. SHALL BE FOLLOWED WITH STRICT ADHERENCE AND SHALL BE COMPLETED PRIOR TO CONSTRUCTION. SHOULD THE GEOTECHNICAL REPORT NOT RECOMMEND FOUNDATION PREPARATIONS THE FOLLOWING SPECIFICATIONS SHALL BE FOLLOWED: EXISTING SUB-BASE SHALL BE FREE OF COBBLES LARGER THAN A 12" SPHERE, AND SILT OR CLAY DEPOSITS.

CONCRETE

- MIN. 28 DAY COMPRESSIVE STRENGTH, f'c, SHALL BE 4500 PSI.
- CEMENT SHALL BE TYPE V AND MAX W/C RATIO SHALL BE 0.45
- CONCRETE SHALL BE TESTED IN ACCORDANCE WITH ASTM C 42 SPECIFICATION.
- ALL CONCRETE SHALL BE NORMAL WEIGHT USING HARDROCK AGGREGATES.
- CONCRETE MIXES SHALL BE DESIGNED BY A CERTIFIED LABORATORY AND SUBMITTED W/ SHOPS' TO ES2 FOR APPROVAL.
- ALL CONCRETE SHALL BE REGULAR WEIGHT OF 145 POUNDS PER CUBIC FOOT USING HARDROCK AGGREGATES CONFORMING TO ASTM C33. WATER SHALL BE CLEAN AND POTABLE.
- CONCRETE FOR SLABS ON GRADE SHALL BE CONSOLIDATED USING SURFACE VIBRATION METHODS. ALL OTHER CONCRETE SHALL BE CONSOLIDATED USING INTERNAL VIBRATION METHODS. REMOVE ALL DEBRIS FROM FORMS BEFORE PLACING CONCRETE. CONCRETE SHALL NOT BE DROPPED THROUGH REINFORCING STEEL SO AS TO CAUSE SEGREGATION OF AGGREGATES. UNCONFINED FALL OF CONCRETE SHALL NOT EXCEED 5 FEET.
- ALL ITEMS TO BE CAST IN CONCRETE SUCH AS REINFORCING, DOWELS, BOLTS, ANCHORS, SLEEVES, ETC., SHALL BE SECURELY POSITIONED PRIOR TO CONCRETE PLACEMENT.
- ADMIXTURES
ONLY ADMIXTURES PERMITTED BY THE UNIFORM STANDARD SPECIFICATIONS FOR PUBLIC WORKS' CONSTRUCTION OFF-SITE IMPROVEMENTS CLARK COUNTY SHALL BE ALLOWED.
CURING
CURING ON THE OUTSIDE SURFACE AND INSIDE SURFACE AFTER FORM REMOVAL SHALL BE BY MEANS OF LIQUID MEMBRANE-FORMING COMPOUND MEETING THE REQUIREMENTS OF THE UNIFORM STANDARD SPECIFICATIONS FOR PUBLIC WORKS' CONSTRUCTION OFF-SITE IMPROVEMENTS CLARK COUNTY.
- SURFACES OF STEEL FORMS SHALL BE COATED W/ AN ICBO APPROVED FORM RELEASE OIL.

REINFORCING STEEL

- REINFORCING STEEL SHALL CONFORM TO THE REQUIREMENTS OF ASTM A615. REINFORCING SHALL BE GRADE 60 (FY = 60 KSI) DEFORMED BARS FOR ALL BARS #4 AND LARGER AND ALL BARS USED FOR CONCRETE WALLS. REINFORCING MAY BE GRADE 40 (FY = 40 KSI) DEFORMED BARS FOR ALL BARS #3 AND SMALLER UNLESS NOTED OTHERWISE ON PLANS OR DETAILS. ALL REINFORCING TO BE WELDED SHALL BE ASTM A706, GRADE 60 ALLOY WELDABLE STEEL.

- ALL DIMENSIONS SHOWING THE LOCATION OF REINFORCING STEEL NOT NOTED AS "CLEAR" OR "CLR" ARE TO CENTER OF STEEL. MINIMUM COVER FOR NON-PRESTRESSED CONCRETE REINFORCING SHALL BE AS FOLLOWS, UNLESS NOTED OTHERWISE ON PLANS OR DETAILS:

EXPOSURE CONDITION:	COVER:	TOLERANCES: (+/-)
FOOTINGS & SLABS ON GRADE:	3"	3/8"
WALLS & SLABS EXPOSED TO EARTH OR WEATHER:	1 1/2"	1/2"
#6 BAR OR LARGER:	2"	1/2"
INTERIOR SLABS:	1 1/2"	1/2"

- LAP SPICES OF REINFORCING STEEL IN CONCRETE BEAMS, SLABS AND FOOTINGS SHALL BE ACCORDING TO ACI 318-99 OPT 12 OR LAP SCHEDULE WHERE PRESENT, UNLESS NOTED OTHERWISE. STAGGER SPICES A MINIMUM OF ONE LAP LENGTH. NO TACK WELDING OF REINFORCING BARS ALLOWED. LATEST ACI CODE AND DETAILING MANUAL APPLY. PROVIDE BENT CORNER BARS TO MATCH AND LAP WITH HORIZONTAL BARS AT ALL CORNERS AND INTERSECTIONS PER TYPICAL DETAILS. VERTICAL WALL BARS SHALL BE SPICED AT OR NEAR FLOOR LINES. SPICE BARS TOP BARS AT CENTER LINE OF SPAN AND BOTTOM BARS AT THE SUPPORT IN SPANDRELS, BEAMS, GRADE BEAMS, ETC., UNLESS NOTED OTHERWISE.

REBAR LAP SCHEDULE	
BAR	LAP
#3	31"
#4	31"
#5	39"
#6	48"

- ALL REINFORCING SHALL BE BENT COLD. BARS SHALL NOT BE UNBENT AND RE-BENT EXCEPT AS NOTED ON PLAN. FIELD BENDING OF REBAR SHALL NOT BE ALLOWED EXCEPT AS NOTED ON PLAN. BENDS AND HOOKS SHALL CONFORM TO ACI STANDARD 318-80.
- WELDING OF REINFORCING BARS, METAL INSERTS, AND CONNECTIONS SHALL CONFORM WITH ACI 318 CHAPTER 12, AND SHALL BE MADE ONLY AT LOCATIONS SHOWN ON PLANS OR DETAILS. ALL REINFORCING SHALL BE BENT COLD. BARS SHALL NOT BE UN-BENT AND RE-BENT.
- REINFORCING BAR SPACING SHOWN ON PLANS ARE HANDBOOK. DOWEL ALL VERTICAL REINFORCING TO FOUNDATION. SECURELY TIE ALL BARS IN LOCATION BEFORE PLACING CONCRETE.

INSPECTIONS

- THE SPECIAL INSPECTORS SHALL PROVIDE INSPECTIONS DURING PLACEMENT OF BACKFILL, REINFORCEMENT, CONCRETE, AND EPOXY DOWELING. THE INSPECTOR SHALL SUBMIT A STATEMENT TO THE OWNER, AND ES2 INDICATING COMPLIANCE WITH THE PLANS AND SPECIFICATIONS.
- SPECIAL INSPECTION OF THE FILL AROUND THE ROJ AND/OR JUNCTION STRUCTURE SHALL BE PROVIDED AT A FREQUENCY AS NECESSARY TO ENSURE THAT PROPER FILL AND COMPACTION IS ACHIEVED. COMPACTION TESTS FOR EACH LIFT SHALL BE TAKEN PER EVERY 2500 SQUARE FEET PLACED AS A MINIMUM. THE SPECIAL INSPECTOR SHALL SUBMIT A COMPLIANCE REPORT TO THE OWNER, AND ES2 DOCUMENTING FILL TYPE AND PROCEDURES OF PLACEMENT.

DEFERRED SUBMITTALS

- ALL ITEMS CONSIDERED IN THESE DESIGN DOCUMENTS AS BY OTHERS ARE NOTED AS DEFERRED SUBMITTALS. THE FOLLOWING WILL INCLUDE BUT NOT BE LIMITED TO:
 - CONCRETE MIX DESIGN
 - REINFORCING SHOP DRAWING

- PRIOR TO SUBMITTAL OF DEFERRED ITEMS TO PLAN REVIEW, THEY SHALL BE SUBMITTED TO OUR OFFICE FOR REVIEW.

EPOXY ANCHORAGE

- EPOXY GROUTED DOWELS SHALL BE INSTALLED USING:


- HILTI HIT HY-150 ADHESIVE ANCHOR SYSTEM (ICBO REPORT NO. 5193)
- SIMPSON STRONG-TIE SET ADHESIVE ANCHOR SYSTEM (ICBO NO. 5279).
- INSTALL THE ABOVE SYSTEMS PER THE ICBO REPORT AND MGR'S RECOMMENDATIONS.
- ALTERNATE EPOXY GROUT SYSTEMS WITH CURRENT ICBO APPROVAL MAY BE SUBMITTED BY THE CONTRACTOR FOR APPROVAL.

SHEET INDEX

SHEET NO.	SHEET TITLE	SHEET NO.	SHEET TITLE
S0.1	GSN, STD ABBREVIATIONS, SHEET INDEX	S2.2	SECTIONS
S1.1	PLAN VIEW	S2.3	SECTIONS
S1.2	PLAN VIEW	S2.4	SECTIONS
S1.3	PLAN VIEW	S2.5	RCP PENETRATION PLAN/SECTIONS
S2.1	SECTIONS		

STANDARD ABBREVIATIONS

ACI	AMERICAN CONCRETE INSTITUTE	FLR	FLOOR	PSI	POUNDS PER SQUARE INCH
ASCI	AMERICAN INSTITUTE OF STEEL CONSTRUCTION	FTG	FOOTING	REQ'D	REQUIRED
ANSI	AMERICAN NATIONAL STANDARDS INSTITUTE	GSN	GENERAL STRUCTURAL NOTES	SMR	SIMILAR
ASTM	AMERICAN SOCIETY FOR TESTING AND MATERIAL	KSI	KIPS PER SQUARE INCH	T&B	TOP AND BOTTOM
CL	CENTER LINE	MFG	MANUFACTURER	TOP	TOP OF FOOTING
CLR	CLEAR	MAX	MAXIMUM	TOPC	TOP OF PILECAP
CONC	CONCRETE	MECH	MECHANICAL	TOW	TOP OF WALL
CONT	CONTINUOUS	MISC	MISCELLANEOUS	UNIFORM	UNIFORM BUILDING CODE
DA OR #	DRAWING	NTS	NOT TO SCALE	VERT	UNLESS OTHERWISE NOTED
DWG	DRAWING	OC	ON CENTER	W/ W/O	WITH WITHOUT
ELEV	ELEVATION	OPP	OPPOSITE	WT	WEIGHT
EQ	EQUAL	PSE	POUNDS PER SQUARE FOOT		

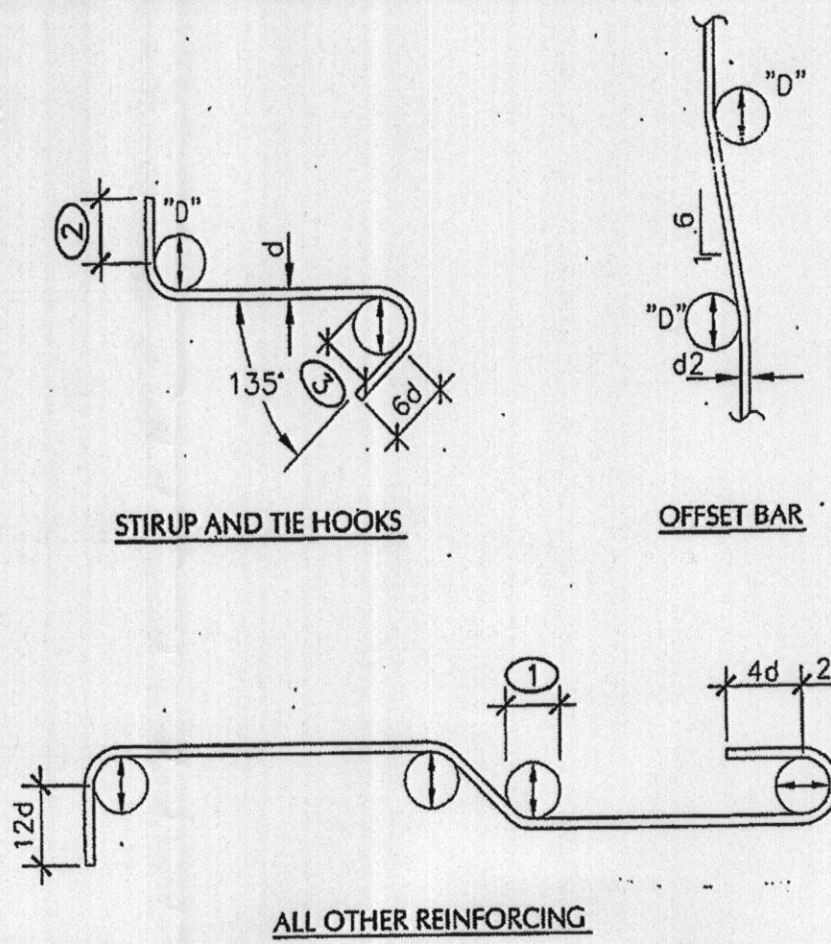


3 STANDARD REBAR BENDING DETAILS
NO SCALE

KEYNOTES:

- D = 6d FOR #3 THRU #8
D = 8d FOR #9, 10 AND 11
D = 10d FOR #14 AND #18
- 6"x4" FOR #5 AND SMALLER
12"x4" FOR #6 THRU #8
- MINIMUM FINISHED BEND DIA FOR STIRRUPS AND TIES ONLY
4"x4" OF #5 AND SMALLER
6"x4" FOR #6 THRU #8
6"x4" FOR #6 THRU #8

NOTES:

- "d" = BAR DIA
- ALL REINFORCEMENT SHALL BE BENT COLD UNLESS NOTED OTHERWISE ON PLANS OR DETAILS

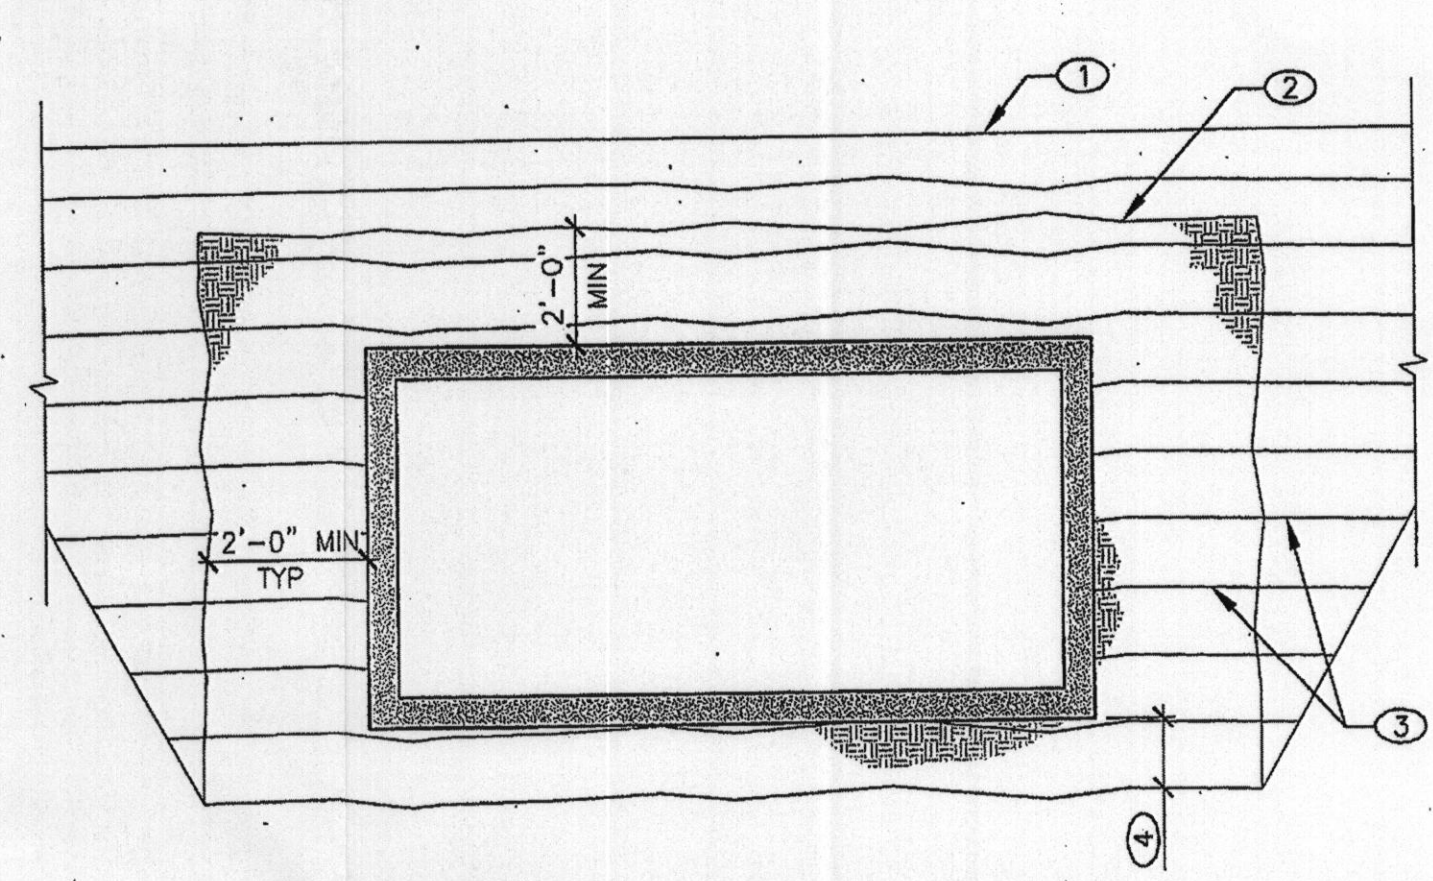

KEYNOTES:

- FINISHED GRADE
- MIN LIMITS OF BACKFILL ZONE (GEOTECHNICAL ENGINEER MAY REQUIRE ADDITIONAL)
- FOR FILL HEIGHT LESS THAN 2'-0" THE FINISH GRADE SHALL BE THE BOUNDARY LINE FOR THE BACKFILL ZONE. BACK FILLING OPERATIONS WITHIN THE BACKFILL ZONE SHALL BE PERFORMED PER THE GEOTECHNICAL REPORT.
- SCARIFY 12" MIN AND COMPACT PER NOTE A


NOTES:

- ALL BACKFILL FOR THE REFERENCED PROJECT SHALL CONSIST OF MATERIAL AS SPECIFIED IN THE REFERENCED GEOTECHNICAL REPORT. HOWEVER, SHOULD THE REPORT NOT RECOMMEND A MATERIAL TYPE THE FOLLOWING SPECIFICATION SHALL BE FOLLOWED. BACKFILL SHALL CONSIST OF WELL GRADED 3" MINUS GRANULAR MATERIAL WITH A MINIMUM OF 2'-0" COVER OVER THE BOX AND 2'-0" ON EACH SIDE OF THE ARCH OR STEM WALLS. EXISTING SUBBASE SHALL BE SCARIFIED FOR 1'-0" DEPTH AND COMPACTED TO 95% OF DRY DENSITY AND 6" OF WELL GRADED 3" MINUS GRANULAR MATERIAL BE PLACED ON EXISTING COMPACTED SUBBASE AND PROPERLY COMPACTED TO 95% OF DRY DENSITY. 8" OF WELL GRADED 3" MINUS GRANULAR MATERIAL GRATED TO 95% DRY DENSITY SHALL BE REQUIRED WHEN COBBLES 12" IN DIA ARE FOUND.
- PLACEMENT OF THE FILL AT THE STEM WALLS AND OVER THE BOX MAY BEGIN WHEN THE CONCRETE STRENGTH HAS REACHED 3800 psi COMPRESSIVE STRENGTH AFTER A MIN OF TEN DAYS. FILL SHALL BE PLACED IN 8" MAXIMUM VERTICAL LIFTS AND COMPACTED TO 95% OF DRY DENSITY. LIFTS SHALL BE PLACED SYMMETRICALLY EACH SIDE ALONG THE FULL LENGTH OF ROJ WITH A MAXIMUM BACKFILL LIFT HEIGHT DIFFERENTIAL OF 1'-0". MAXIMUM DRY DENSITY SHALL BE DETERMINED PER THE GEOTECHNICAL REPORT. BACKFILL SHALL BE COMPACTED PER GEOTECHNICAL REPORT.
- NO EQUIPMENT WEIGHING MORE THAN A 3 YARD RUBBER TIRE LOADER (928 CATERPILLAR OR EQUIVALENT) SHALL BE ALLOWED TO PASS OVER THE STRUCTURE UNTIL THE SPECIFIED FILL IS IN PLACE. HEAVY EQUIPMENT SUCH AS SCRAPERS AND CRANES SHALL NOT BE ALLOWED TO PASS OVER THE STRUCTURE UNLESS SPECIFIC WRITTEN PERMISSION IS OBTAINED BY THE STRUCTURAL ENGINEER.

1 BACKFILL REQUIREMENTS (ELEVATION)
NO SCALE

KEYNOTES:


- 2"x6" WEEP HOLE EACH SIDE OF BOX AT 6'-0" O.C.
- (2) CUBIC FOOT OF FREE DRAIN MATERIAL WRAPPED IN FILTER FABRIC AT EACH WEEP HOLE
- CONCRETE WALL
- COMPACT BACKFILL, SEE GEOTECHNICAL REPORT

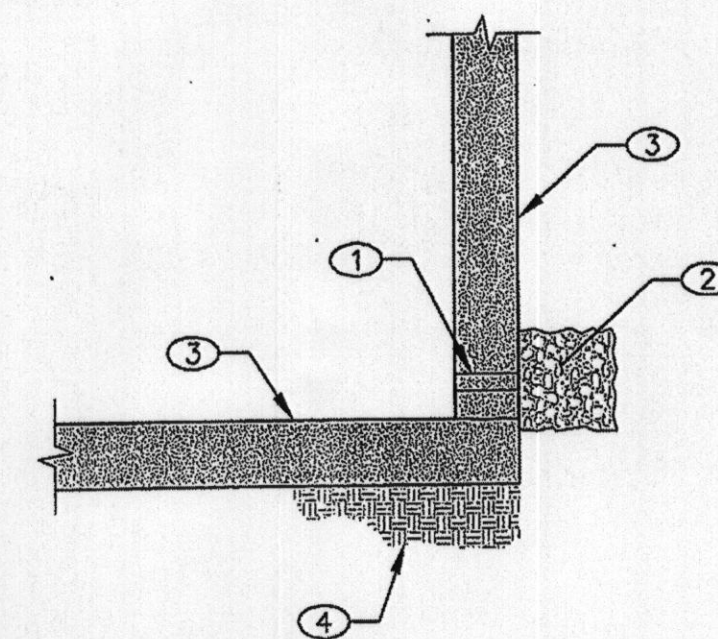

2 WEEP HOLE DRAIN REQUIREMENTS
NO SCALE

PARADISE VILLAGE
STORM DRAIN TRANSITION STRUCTURE
LAS VEGAS, NV

GSN, STD ABBREVIATIONS, SHEET INDEX

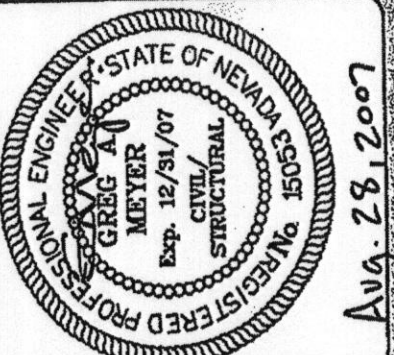

6380 S. VALLEY VIEW, STE 406
LAS VEGAS, NEVADA 89118
Phone: (702) 616-3107
Fax: (702) 616-3725





PROJECT:

DATE	DESCRIPTION
8/2/07	SUBMITTED FOR APPROVAL
11/14/06	SUBMITTED FOR APPROVAL
6/28/06	SUBMITTED FOR APPROVAL
	REV.


DRAWN:	CHECKED:
JDB	BHL
DATE:	NOVEMBER 14, 2006
PROJECT NUMBER:	LV06108
SHEET NUMBER:	21 OF 29

S0.1

MATCHLINE AT 13+25.00 - SEE PP2 FOR CONTINUATION

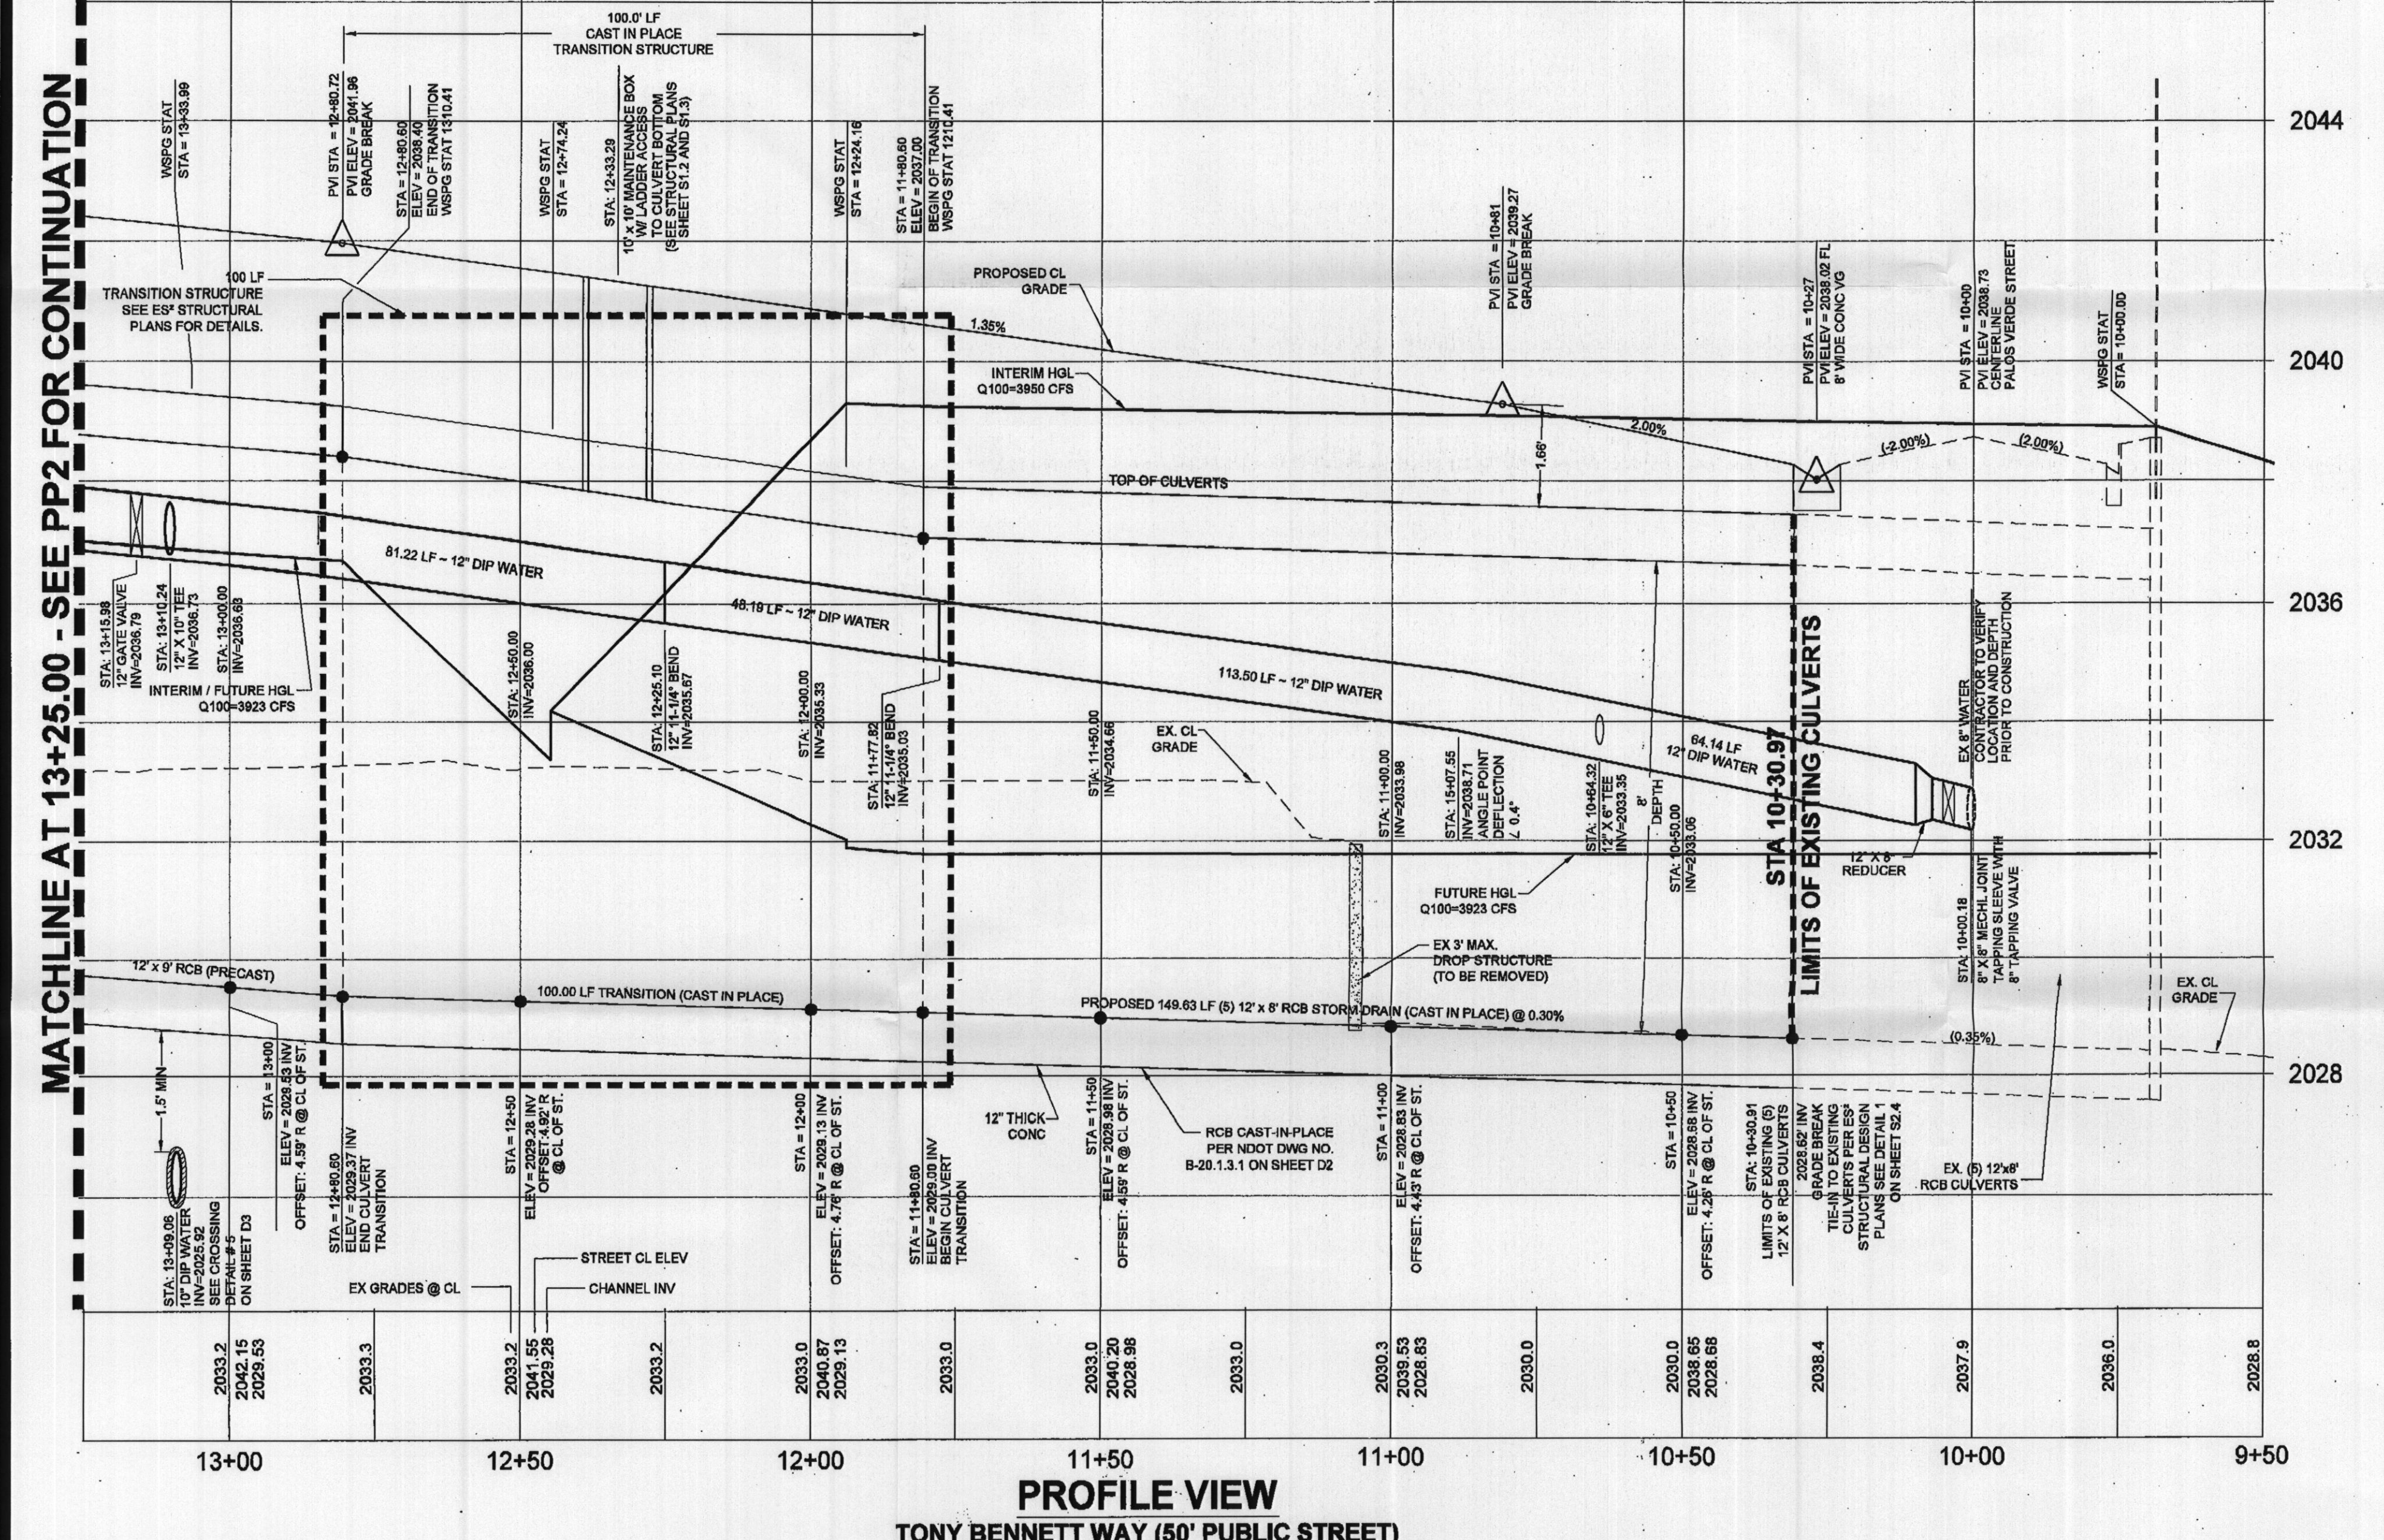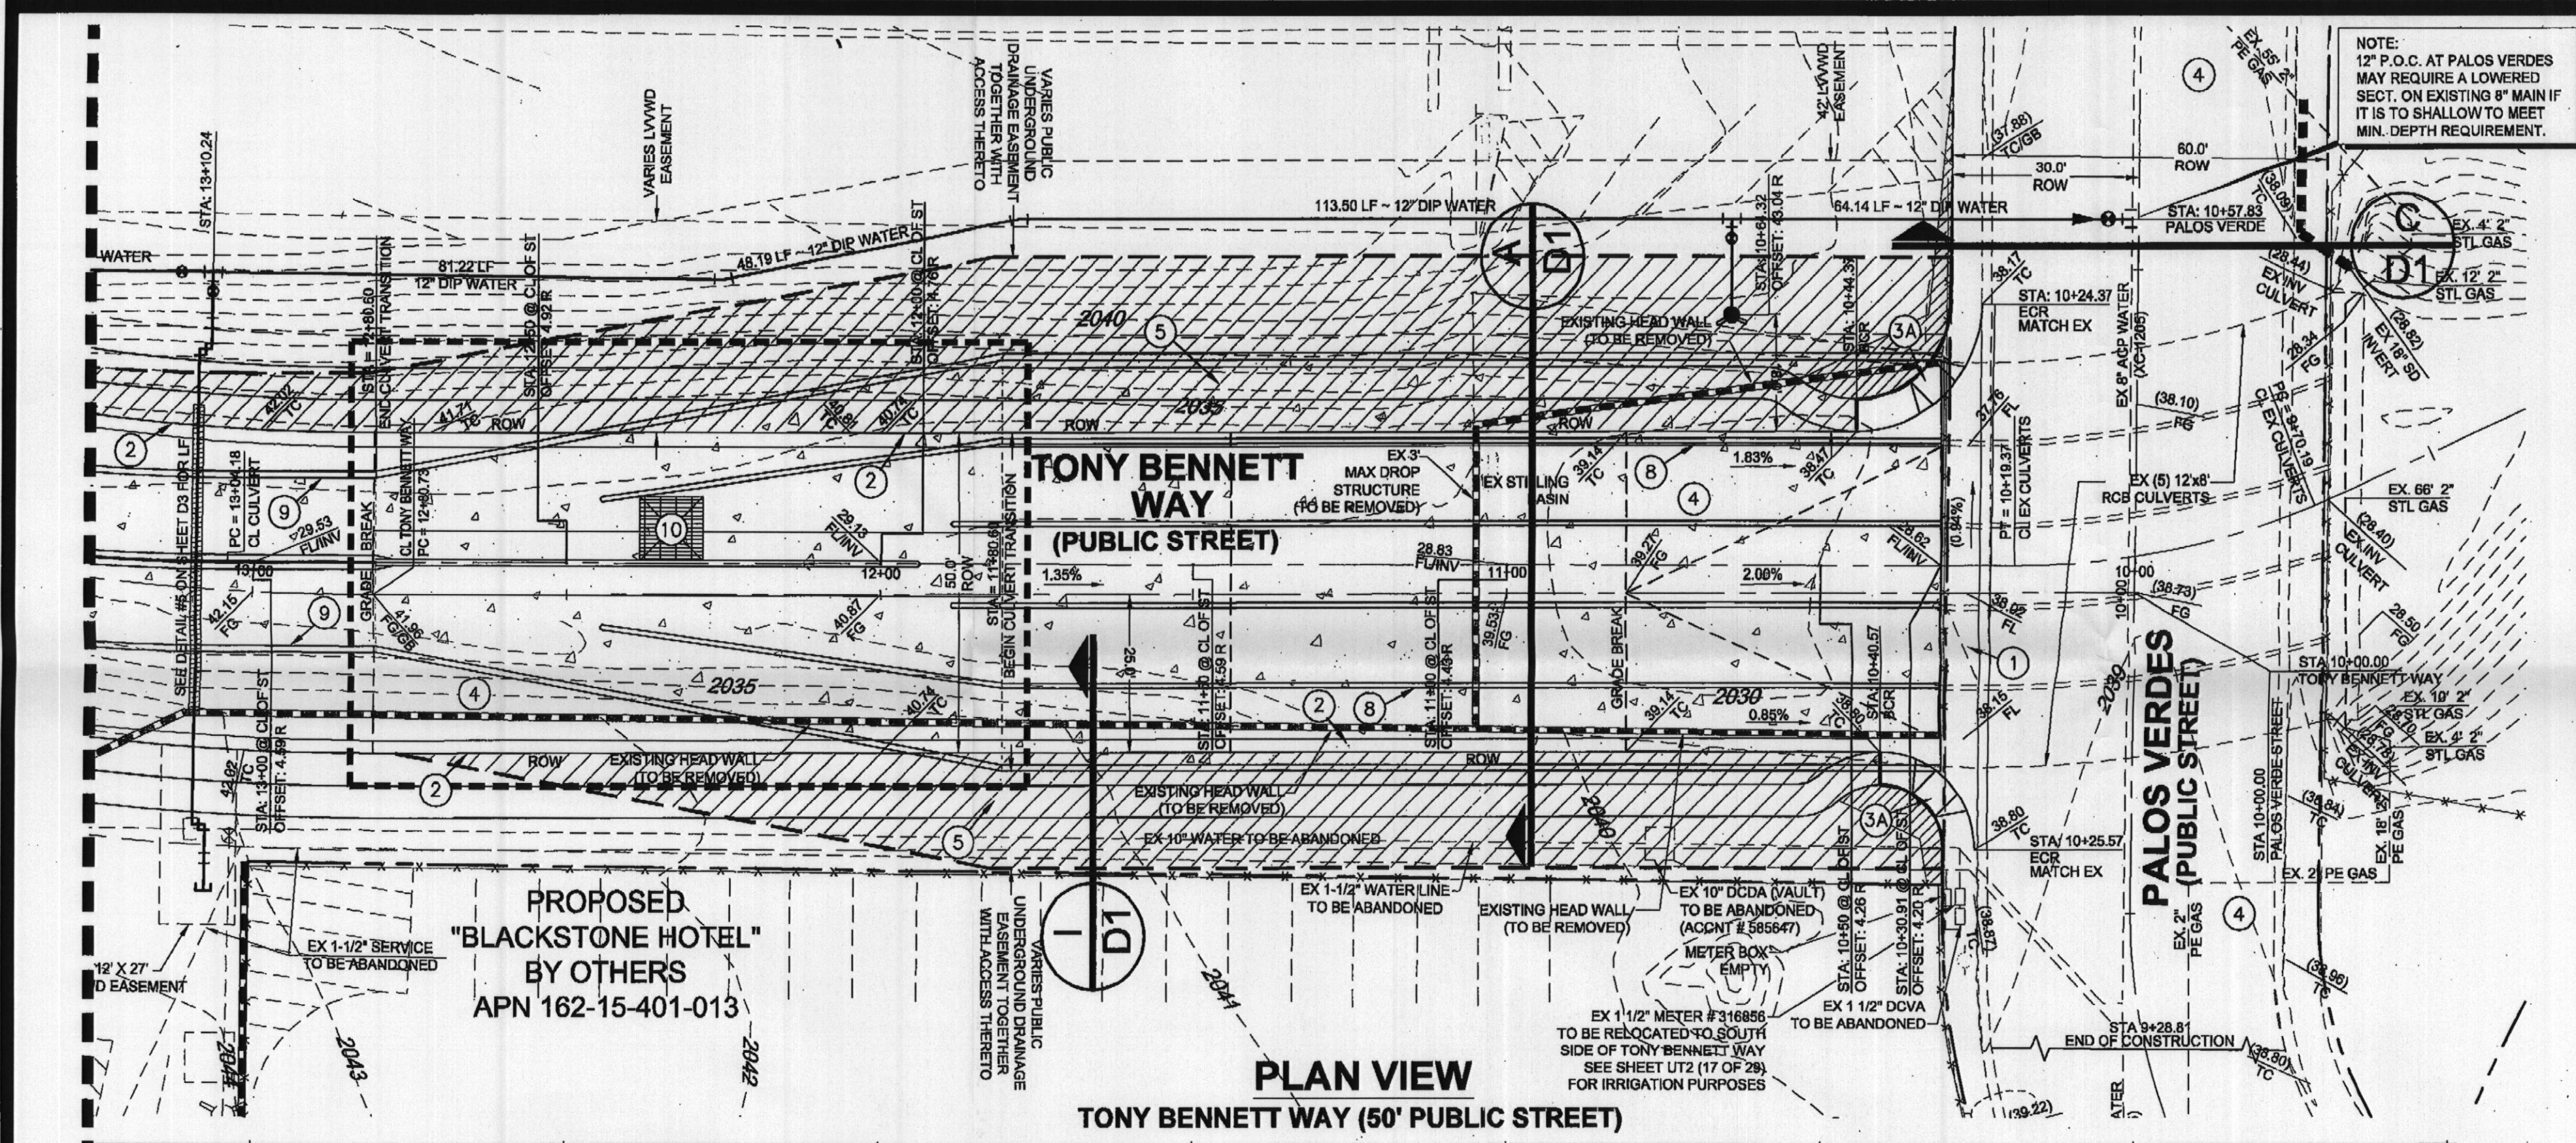

LEGEND	DESCRIPTION:	CONTOUR LINES	EDGE OF PAVEMENT	"A" TYPE CURBS	"L" TYPE CURBS	WALLS	FENCES	AC PAVEMENT	SPOT ELEVATIONS	SIGNS	FIRE HYDRANTS	GATE VALVES	CLEAN OUTS	REDUCERS	UTILITY BOX OR VAULT	100w HPS STREETLIGHTS	150w HPS STREETLIGHTS	200w HPS STREETLIGHTS	250w HPS STREETLIGHTS	MANHOLE DESCRIPTIONS	ROW LINE	PROPERTY LINE	SCARP LINE	SAWTOOTH LINE	CONCRETE PWT.	SEWER AND WATER SERVICE W/ PRVS	ELECTRICAL PEDESTAL	PULL BOX AS SHOWN	POWER POLE
EXISTING:	2308																												
PROPOSED:																													

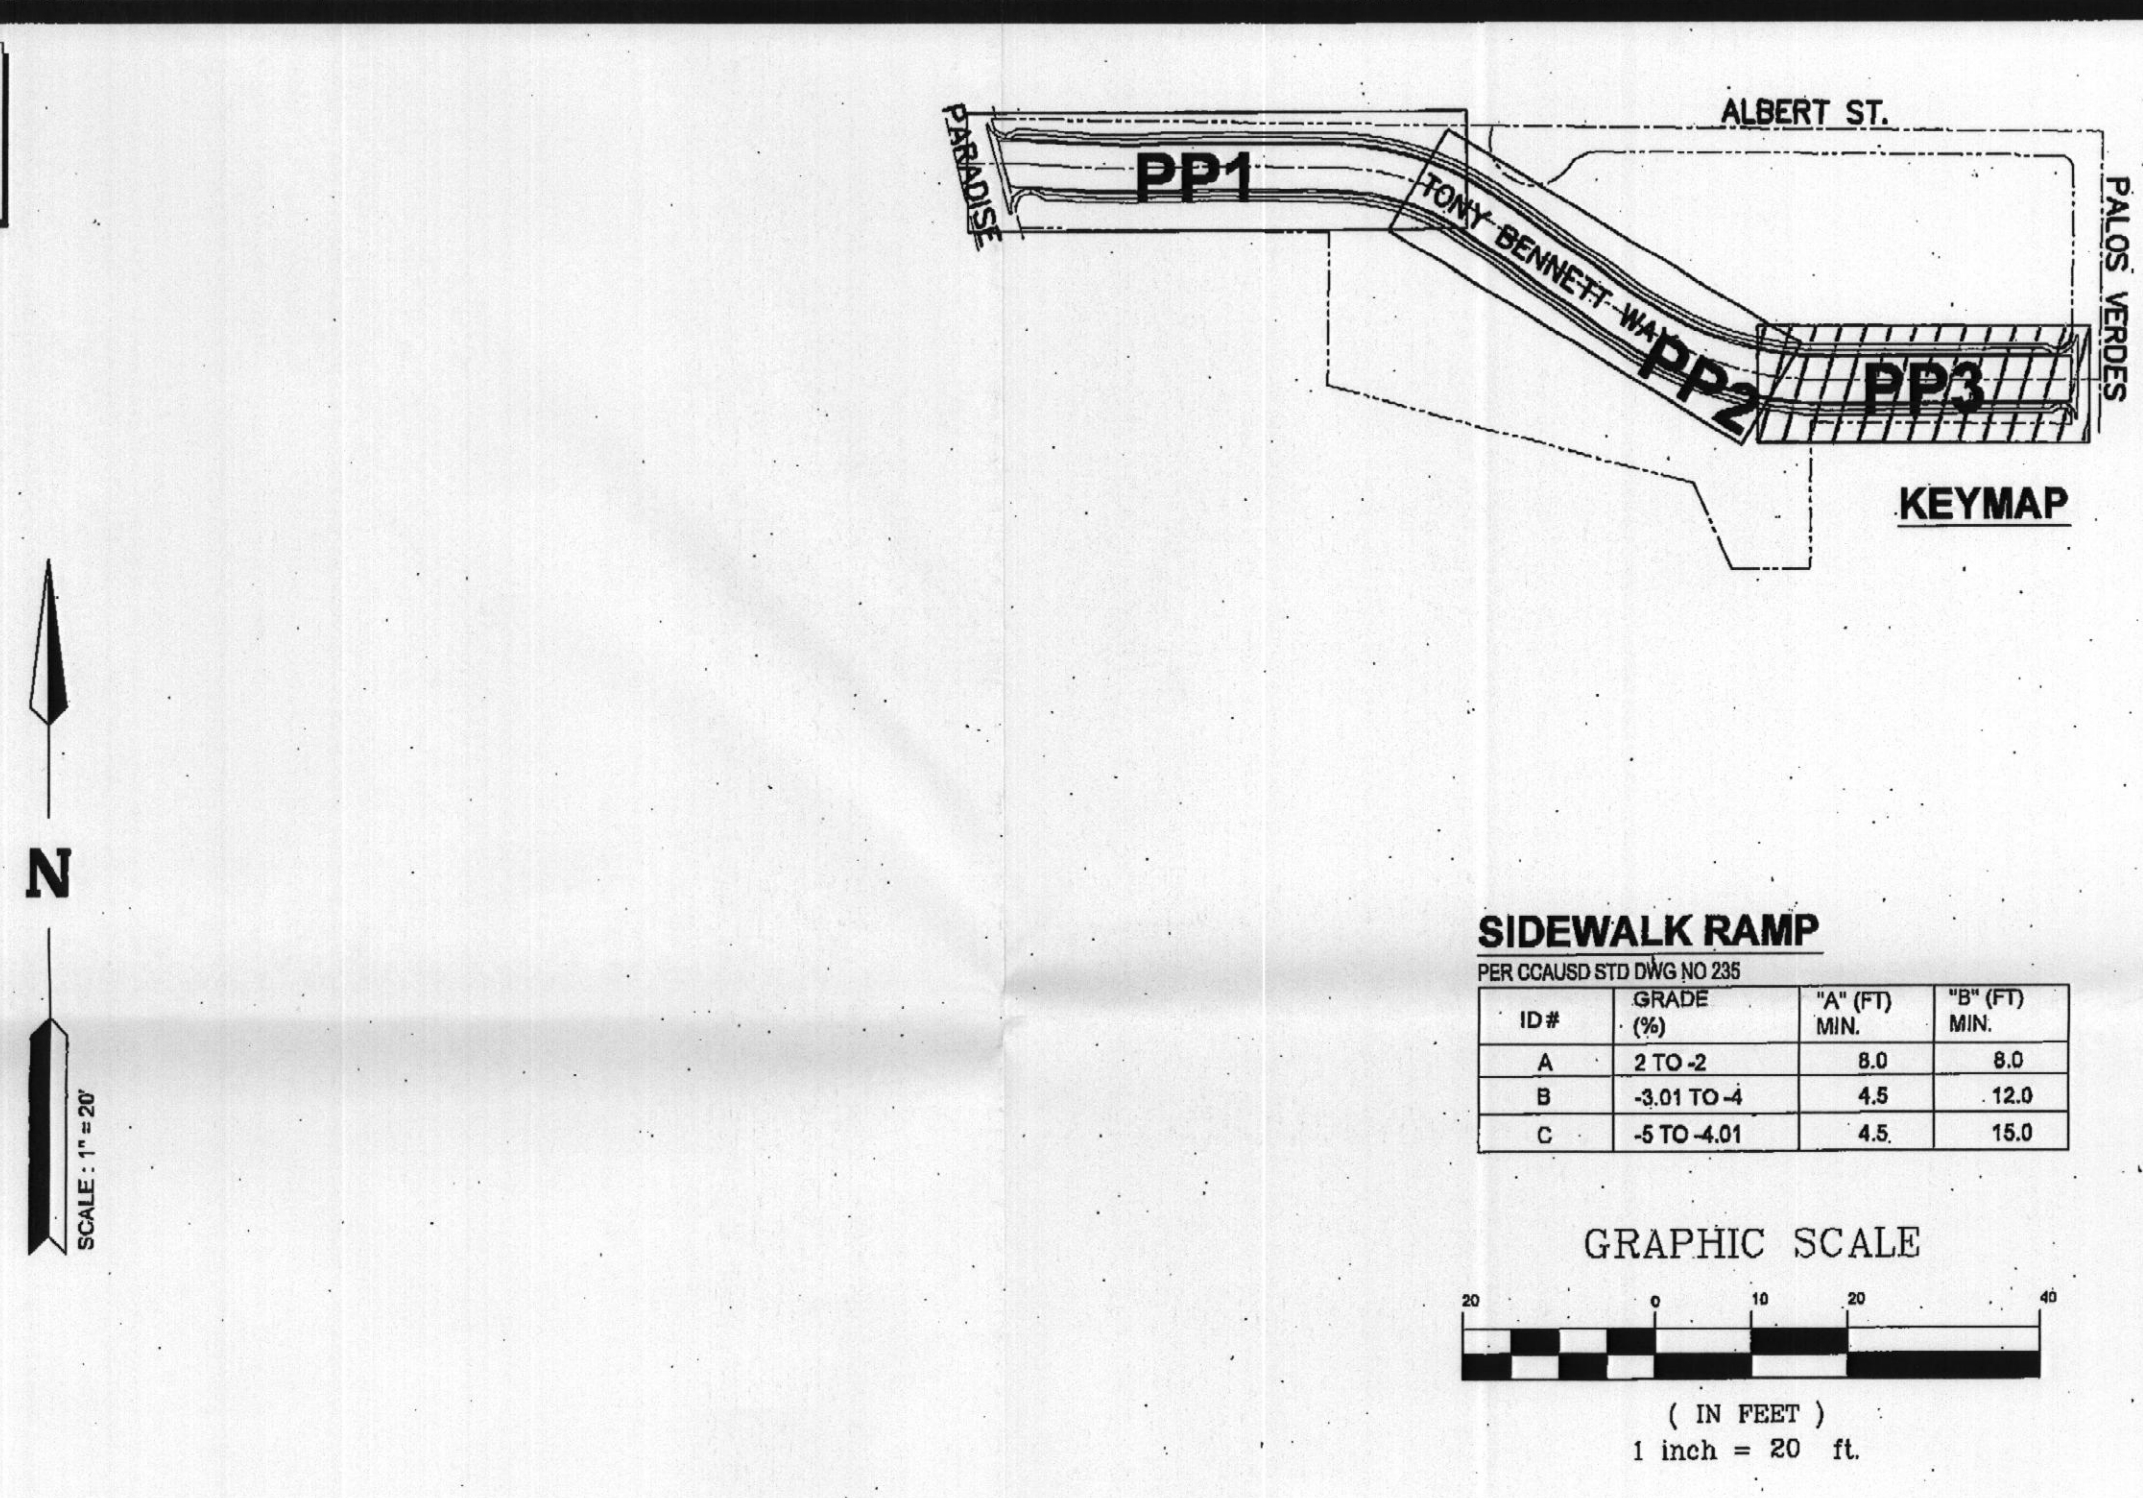

- CONSTRUCTION NOTES:**
- CONSTRUCT 8" WIDE CONCRETE VALLEY GUTTER PER C.C.A.U.S.D. NO. 228.
 - CONSTRUCT 24" "L" TYPE CURB & GUTTER PER C.C.A.U.S.D. NO. 216.
 - CONSTRUCT SIDEWALK RAMP USING ARMOR TILE TRUNCATED DOMES OR EQUIVALENT PER C.C.A.U.S.D. NO. 235, CASE 1.
 - CONSTRUCT 3" AC PAVEMENT ON 4" TYPE II OVER 6" TYPE I AGGREGATE BASE.
 - CONSTRUCT 5" CONCRETE SIDEWALK PER C.C.A.U.S.D. NO. 234.
 - INSTALL SIDEWALK UNDERDRAIN PER CC STD DWG NO. 235.
 - CONSTRUCT 2' 10' x 10' PRECAST MONOLITHIC IN PLACE REINFORCE CONCRETE BOX PER RINKERS MATERIAL.
 - CONSTRUCT 5' 12' x 8' CAST-IN-PLACE REINFORCE CONCRETE BOX (RCB) PER NDOT STD DWG NO. B-20.1.3.1 SEE DETAIL ON SHEET D2.
 - INSTALL DUAL 12' x 8' PRECAST MONOLITHIC IN PLACE REINFORCE CONCRETE BOX (RCB) PER ASTM C1433 OR EQUIVALENT. SEE DETAIL ON SHEET D2.
 - INSTALL AN 10' x 10' STEEL LID TRAFFIC RATED STORM DRAIN MANHOLE WITH CONCRETE COLLARS PER SSP STRUCTURAL CALCULATIONS AND PLANS ON SHEET S1.2 AND S1.3. STEEL LID SHALL CONFORM WITH CLARK COUNTY TRAFFIC STANDARDS. DESIGN SHALL BE A PART OF THE SHOP DRAWINGS TO BE REVIEWED AND APPROVED PRIOR TO MANUFACTURING.

BASIS OF BEARING

THE BASIS OF BEARINGS FOR THIS SURVEY IS THE WEST LINE OF THE SOUTHWEST ONE-QUARTER OF THE SOUTHWEST ONE-QUARTER OF SECTION 15, TOWNSHIP 21 SOUTH, RANGE 81 EAST, N.D.M. WHICH BEARS NORTH 00°04'12" EAST AS SHOWN IN THE OFFICE OF THE CLARK COUNTY, NEVADA RECORDER IN FILE 143 OF SURVEYS ON PAGE 22.

BENCHMARK

CLARK COUNTY BENCHMARK NUMBER 6C11 22NWS - RIVET AND SQUARE ALUMINUM PLATE IN TOP OF CURB, NORTHEAST CORNER OF PARADISE RD. AND FLAMINGO RD. NEAR THE PC OF PARADISE RD.

ELEVATION=624.806 METERS=2049.88 US SURVEY FEET (NAVD 88 DATUM)

APPROVALS:

CLARK COUNTY
DEPARTMENT OF
DEVELOPMENT SERVICES

ACCEPTANCE OF PLANS FOR FILING
BY *Maryanne* 9-10-07

ACCEPTANCE OF THESE PLANS FOR FILING SHALL NOT BE CONSTRUED TO BE A PERMIT FOR OR AN APPROVAL OF ANY VIOLATION OF ANY OF THE PROVISIONS OF THE STATE OR COUNTY LAWS AND/OR SPECIFICATIONS. CLARK COUNTY SHALL BE HELD FREE FROM DAMAGES WHICH MAY RESULT FROM THE CONSTRUCTION OF THE IMPROVEMENTS FROM THE ENGINEERING DESIGN DEPICTED HEREIN.

NOTE: POWER POLES AND/OR OTHER EXISTING FACILITIES NOT IN PROPER LOCATION BASED ON PROPOSED IMPROVEMENTS SHOWN HEREON WILL BE RELOCATED AT NO EXPENSE TO CLARK COUNTY.

APPROVED FOR CONSTRUCTION

LAS VEGAS VALLEY WATER DISTRICT
PROJECT # 114186

DATE:
ESN: 018 REV 06/01/04

LEGEND

ROW LINE
PROPERTY LINE
CL OR SURVEY LINE

SCARP LINE
SAWTOOTH LINE
EASEMENT LINE

CONCRETE PWT.

SEWER AND WATER SERVICE W/ PRVS
BACKWATER VALVE

ELECTRICAL PEDESTAL
PULL BOX AS SHOWN
POWER POLE

LAPOUR PARTNERS
5525 SOUTH DECATUR BLVD, SUITE 101
LAS VEGAS, NV 89118
(702) 222-3022

ENGINEERING COMPANY
3321 N. Buffalo Drive, Suite 200
Las Vegas, Nevada 89129
Tel: (702) 877-1300 Fax: (702) 877-0300

ALPHA &

PARADISE VILLAGE OFFSITE PLANS

PLAN & PROFILE
TONY BENNETT WAY
3 OF 5

SHEET
PP3
13 OF 29 SHEETS
DRAWING NO.
HTE# 07-15692

DATE
04-23-07

DESIGNED BY
SFC

CHECKED BY
SWS

PROJECT NO.
0527008

SCALE
1" = 20'



REVISION

BY

DATE

REV

NO.

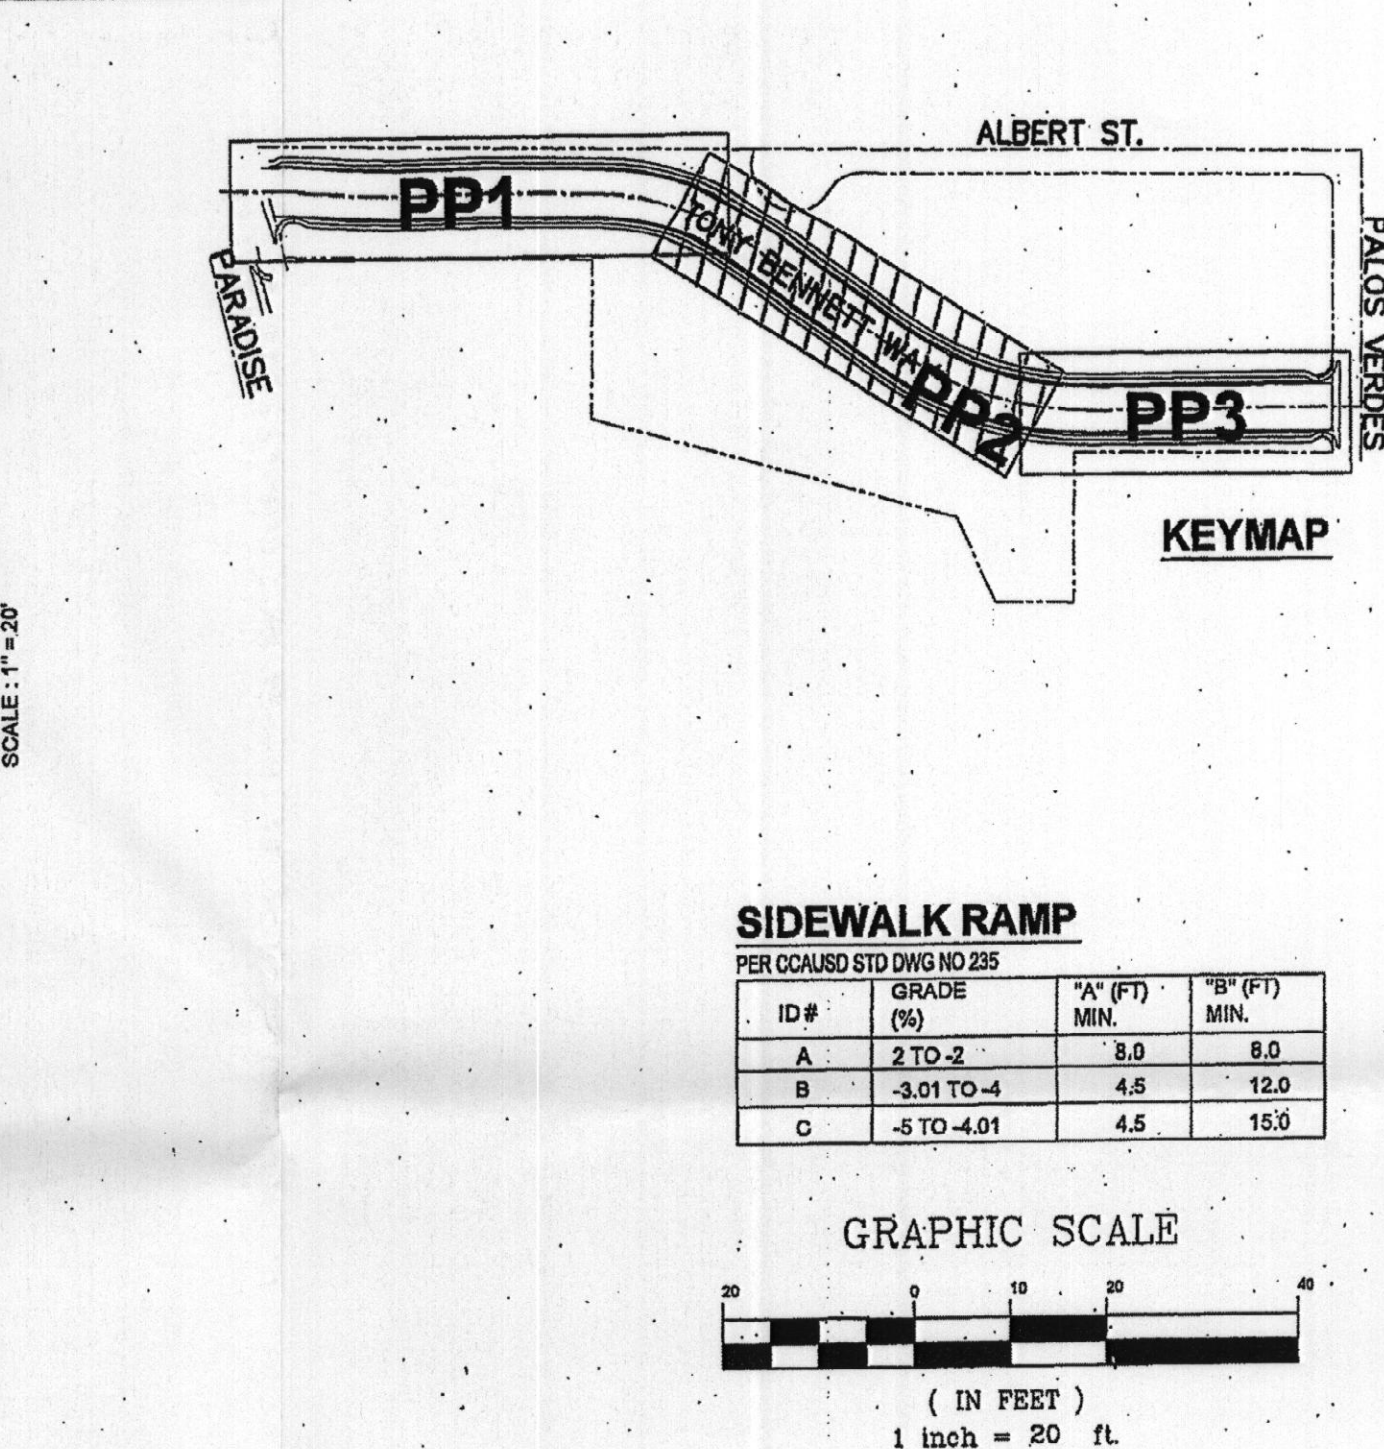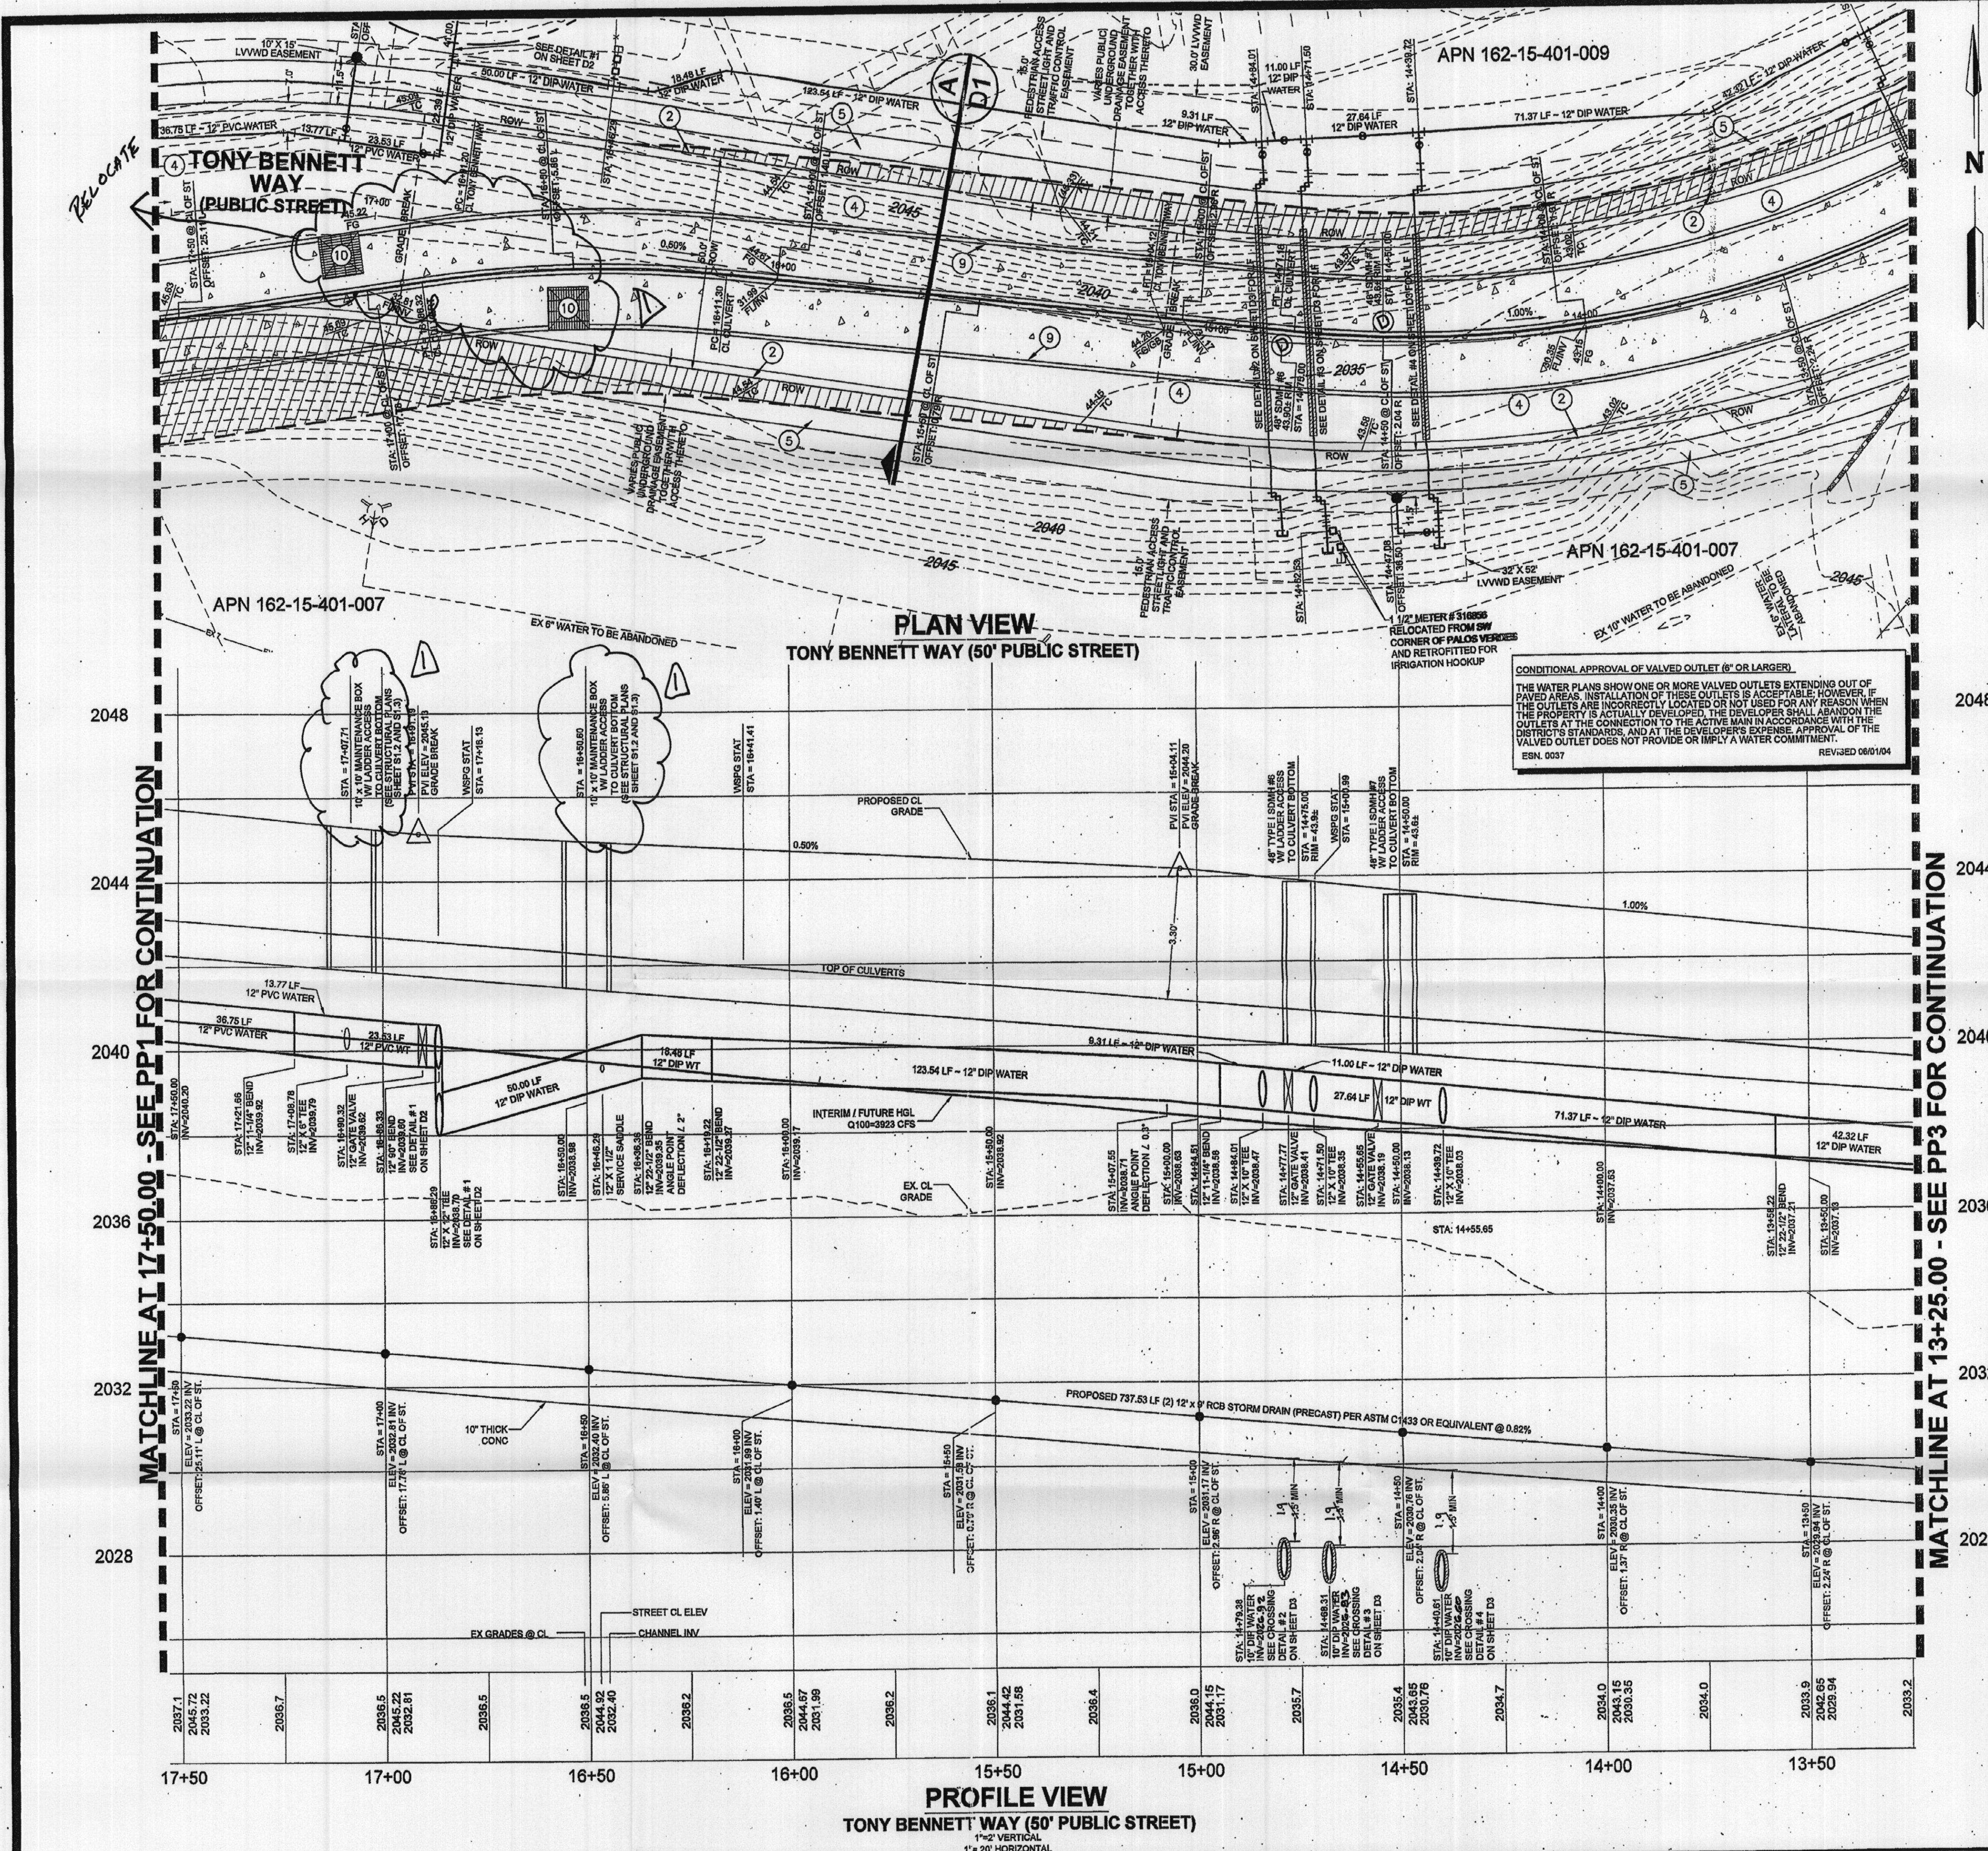

- CONSTRUCTION NOTES:**
1. CONSTRUCT 8" WIDE CONCRETE VALLEY GUTTER PER C.C.A.U.S.D. NO. 238.
 2. CONSTRUCT 24" "L" TYPE CURB & GUTTER PER C.C.A.U.S.D. NO. 216.
 3. CONSTRUCT SIDEWALK RAMP USING ARMOR TILE TRUNCATED DORIES OR EQUIVALENT PER C.C.A.U.S.D. NO. 235, CASE 1.
 4. CONSTRUCT 3" AC PAVEMENT ON 4" TYPE II OVER 6" TYPE I AGGREGATE BASE.
 5. CONSTRUCT 5" CONCRETE SIDEWALK PER C.C.A.U.S.D. NO. 234.
 6. INSTALL SIDEWALK UNDERDRAIN PER CC STD DWG # 235.
 7. CONSTRUCT 2' 15" X 10" PRECAST MONOLITHIC IN PLACE REINFORCE CONCRETE BOX PER RINKERS MATERIAL.
 8. CONSTRUCT 5' 12" X 8" CAST-IN-PLACE REINFORCE CONCRETE BOX (RCB) PER NDOT STD DWG NO. B-20.1.3.1 SEE DETAIL ON SHEET D2.
 9. INSTALL DUAL 12" X 8" PRECAST MONOLITHIC IN PLACE REINFORCE CONCRETE BOX (RCB) PER ASTM C1433 OR EQUIVALENT. SEE DETAIL ON SHEET D2.
 10. INSTALL AN 10' X 10' STEEL LID TRAFFIC RATED STORM DRAIN MANHOLE WITH CONCRETE COLLARS PER 8" STRUCTURAL CALCULATIONS AND PLANS ON SHEET S1.2 AND S1.3. STEEL LID SHALL CONFORM WITH CLARK COUNTY TRAFFIC STANDARDS. DESIGN SHALL BE A PART OF THE SHOP DRAWINGS TO BE REVIEWED AND APPROVED PRIOR TO MANUFACTURING.

BASIS OF BEARING
THE BASIS OF BEARINGS FOR THIS SURVEY IS THE WEST LINE OF THE SOUTHWEST ONE-QUARTER OF THE SOUTHWEST ONE-QUARTER OF SECTION 15, TOWNSHIP 21 SOUTH, RANGE 61 EAST, M.D.M. WHICH BEARS NORTH 00°42' EAST AS SHOWN IN THE OFFICE OF THE CLARK COUNTY, NEVADA RECORDER IN FILE 143 OF SURVEYS ON PAGE 22.

BENCHMARK
CLARK COUNTY BENCHMARK NUMBER 6C11 22NWS - RIVET AND SQUARE ALUMINUM PLATE IN TOP OF CURB, NORTHEAST CORNER OF PARADISE RD. AND FLAMINGO RD. NEAR THE PC OF PARADISE RD.
ELEVATION=624.808 METERS=2049.88 US SURVEY FEET (NAVD 83 DATUM)
803 11/12/07

APPROVALS:
CLARK COUNTY DEPARTMENT OF DEVELOPMENT SERVICES
ACCEPTANCE OF PLANS FOR FILING
BY: *M. J. J. J.* 9-10-09
DATE: 9-10-09
NOTE: POWER POLES AND/OR OTHER EXISTING FACILITIES NOT IN PROPER LOCATION BASED ON PROPOSED IMPROVEMENTS SHOWN HEREON WILL BE RELOCATED AT NO EXPENSE TO CLARK COUNTY.

APPROVED FOR CONSTRUCTION
LAS VEGAS VALLEY WATER DISTRICT
PROJECT # 114186
DATE: 9-20-09
ESN: 016 REV 08/01/04

LEGEND	DESCRIPTION:	CONTOUR LINES	EDGE OF PAVEMENT	"A" TYPE CURBS	"L" TYPE CURBS	WALLS	FENCES	AC PAVEMENT	SPOT ELEVATIONS	SIGNS	FIRE HYDRANTS	GATE VALVES	CLEAN OUTS	REDUCERS	UTILITY BOX OR VAULT	100w HPS STREETLIGHTS	150w HPS STREETLIGHTS	200w HPS STREETLIGHTS	250w HPS STREETLIGHTS	MANHOLE DESCRIPTIONS	ROW LINE	PROPERTY LINE	CL OR SURVEY LINE	SCARP LINE	SAWCUT LINE	EASEMENT LINE	CONCRETE PAVT.	SEWER AND WATER	SERVICE W/ PRVS	ELECTRICAL PEDESTAL	PULL BOX AS SHOWN	POWER POLE
EXISTING:	2309																															
PROPOSED:	22																															

LAPOUR PARTNERS
5525 SOUTH DECATUR BLVD, SUITE 101
LAS VEGAS, NV 89118
(702) 222-3022

ENGINEERING COMPANY
3321 N. Buffalo Drive, Suite 200
Las Vegas, NV 89118
Tel: (702) 877-1300 Fax: (702) 877-0300

PARADISE VILLAGE OFFSITE PLANS


PLAN & PROFILE TONY BENNETT WAY 2 OF 5

APPROVED FOR CONSTRUCTION

PP2


12 OF 29 SHEETS

DRAWING NO. HTE# 07-15692

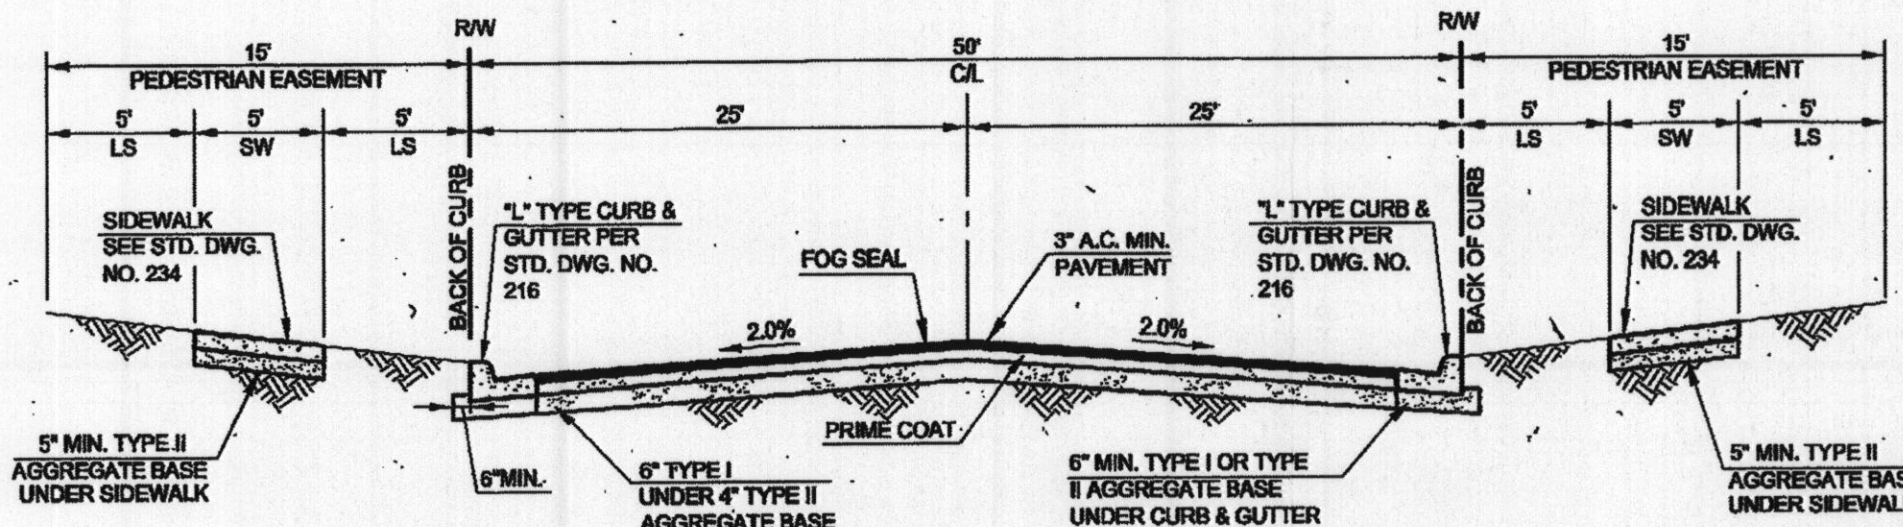


- NOTES:
1. FINAL A.C. PAVEMENT SURFACE SHALL BE 1/2" ABOVE LIP OF GUTTER.
 2. STRUCTURAL SECTION SHOWN IS BASED ON AN "R" VALUE OF 20. OTHER STRUCTURAL SECTIONS MAY BE APPROVED IF BASED ON ENGINEERING ANALYSIS BASED ON "R" OR "CBR" VALUES DETERMINED BY SOIL TESTING. IN NO CASE SHALL THE A.C. THICKNESS BE LESS THAN SHOWN.

A
D1 TONY BENNETT WAY (50' PUBLIC STREET SECTION) TYPICAL
PER MODIFY VERSION OF C.C.A.U.S.D. NO. 205 WITH DETACHED SIDEWALK
NTS

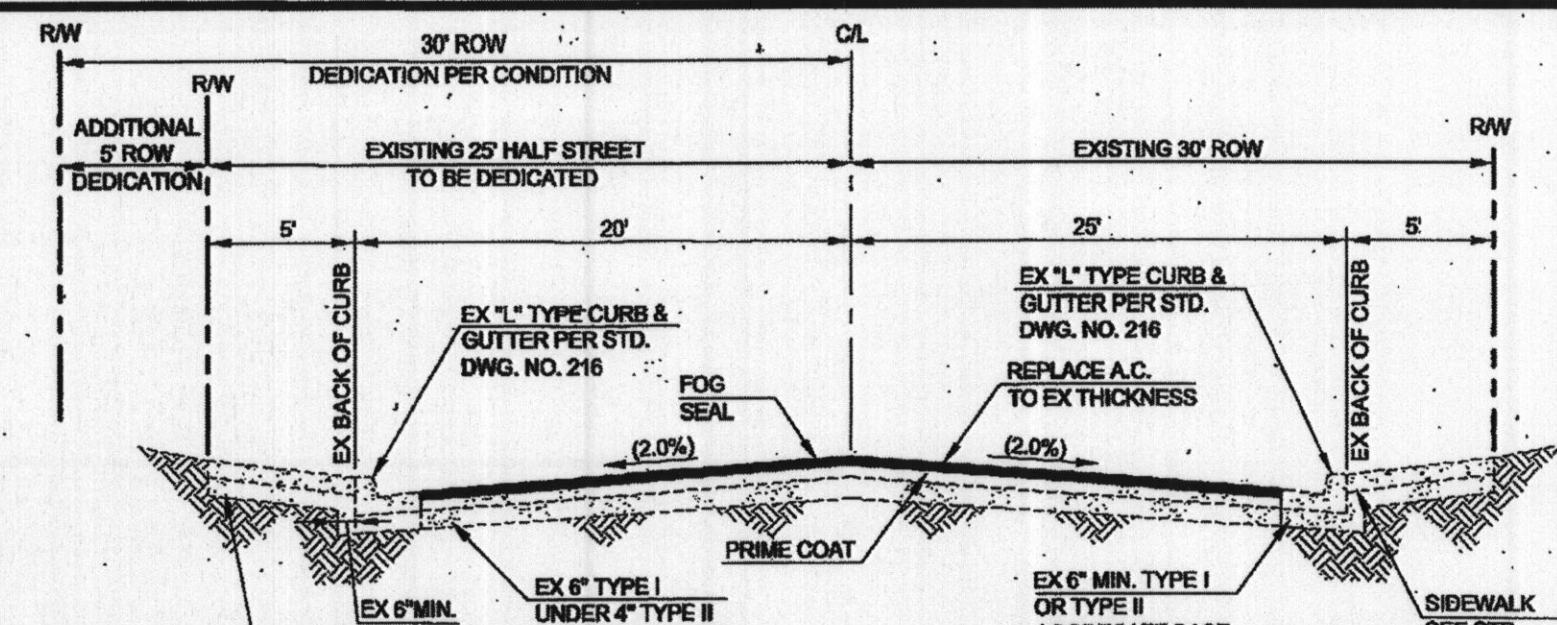


- NOTES:
1. FINAL A.C. PAVEMENT SURFACE SHALL BE 1/2" ABOVE LIP OF GUTTER.
 2. STRUCTURAL SECTION SHOWN IS BASED ON AN "R" VALUE OF 20. OTHER STRUCTURAL SECTIONS MAY BE APPROVED IF BASED ON ENGINEERING ANALYSIS BASED ON "R" OR "CBR" VALUES DETERMINED BY SOIL TESTING. IN NO CASE SHALL THE A.C. THICKNESS BE LESS THAN SHOWN.

B
D1 ALBERT AVENUE (60' PUBLIC STREET SECTION) TYPICAL
NTS

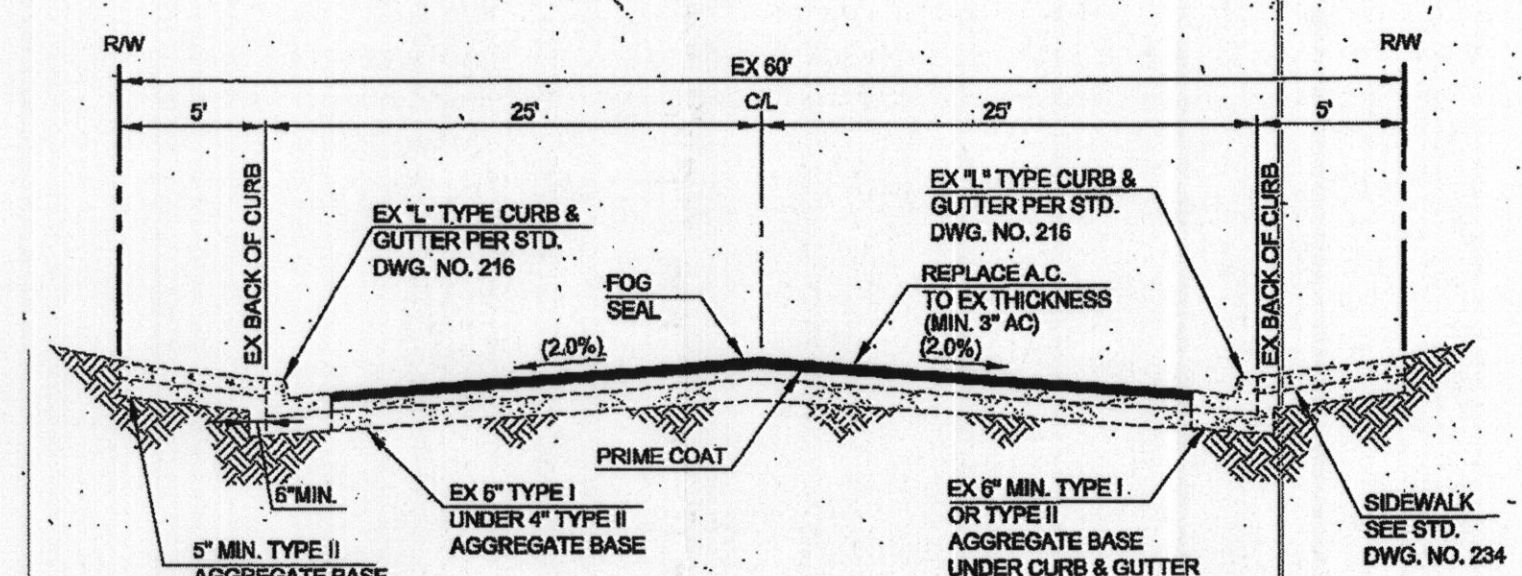


- NOTES:
1. FINAL A.C. PAVEMENT SURFACE SHALL BE 1/2" ABOVE LIP OF GUTTER.
 2. STRUCTURAL SECTION SHOWN IS BASED ON AN "R" VALUE OF 20. OTHER STRUCTURAL SECTIONS MAY BE APPROVED IF BASED ON ENGINEERING ANALYSIS BASED ON "R" OR "CBR" VALUES DETERMINED BY SOIL TESTING. IN NO CASE SHALL THE A.C. THICKNESS BE LESS THAN SHOWN.


C
D1 PALOS VERDES STREET (60' PUBLIC STREET SECTION) TYPICAL
NTS

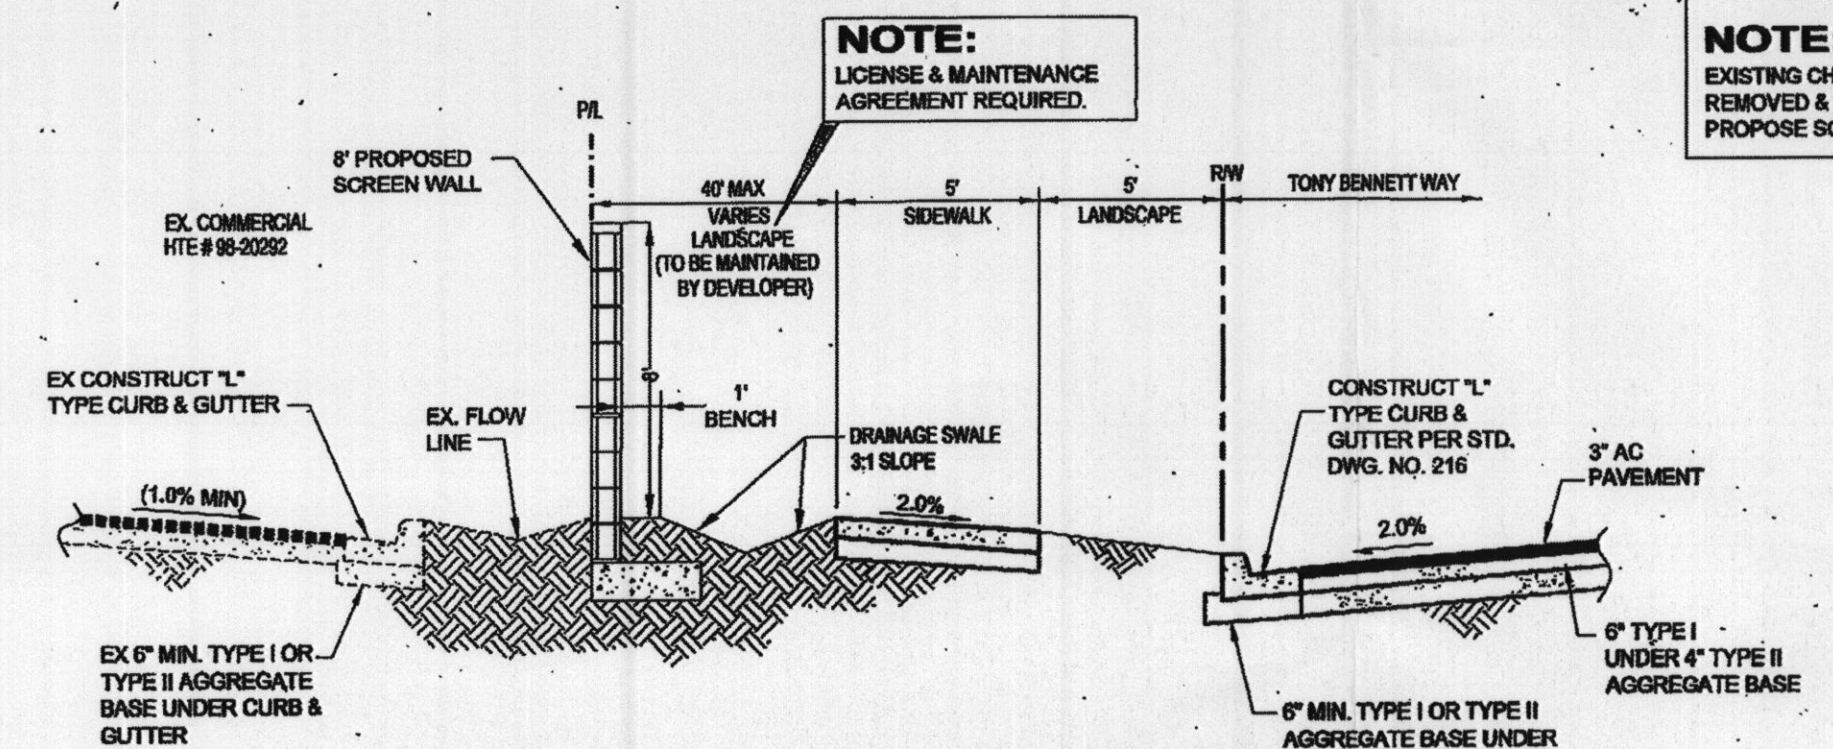


D
D1 CROSS SECTION D
NTS

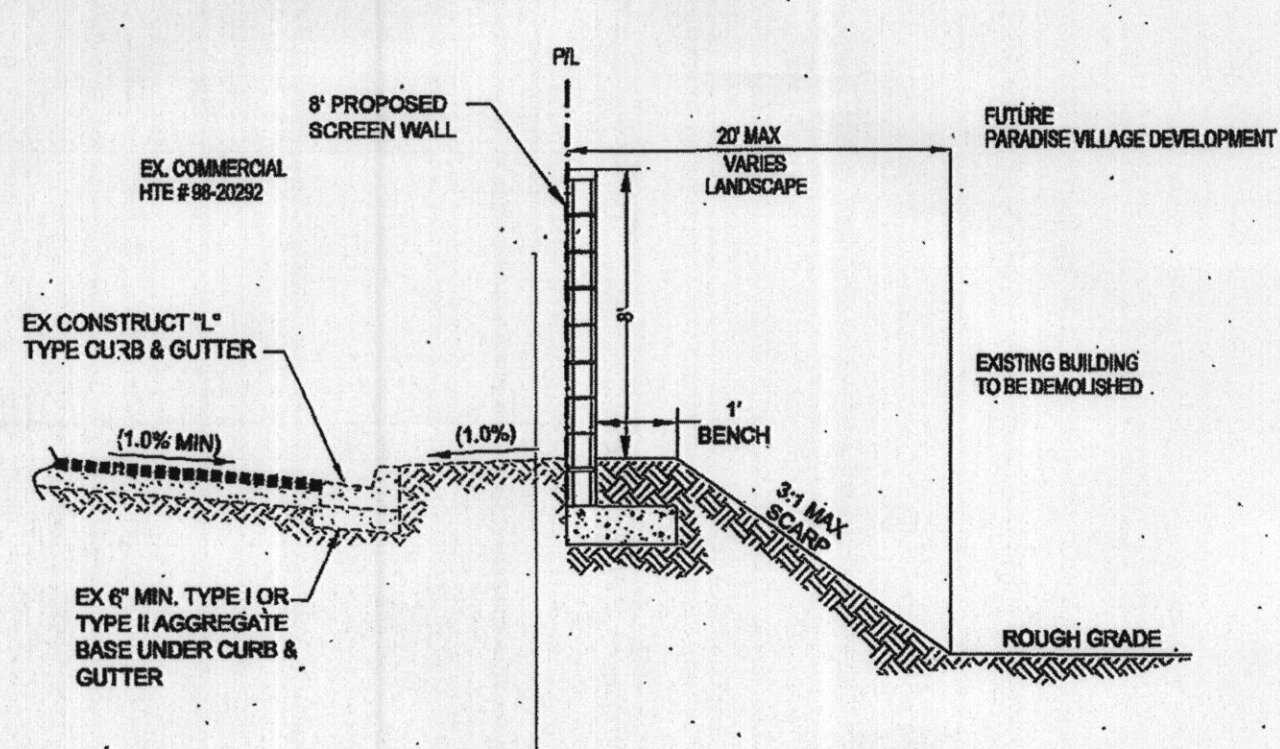


E
D1 CROSS SECTION E
NTS

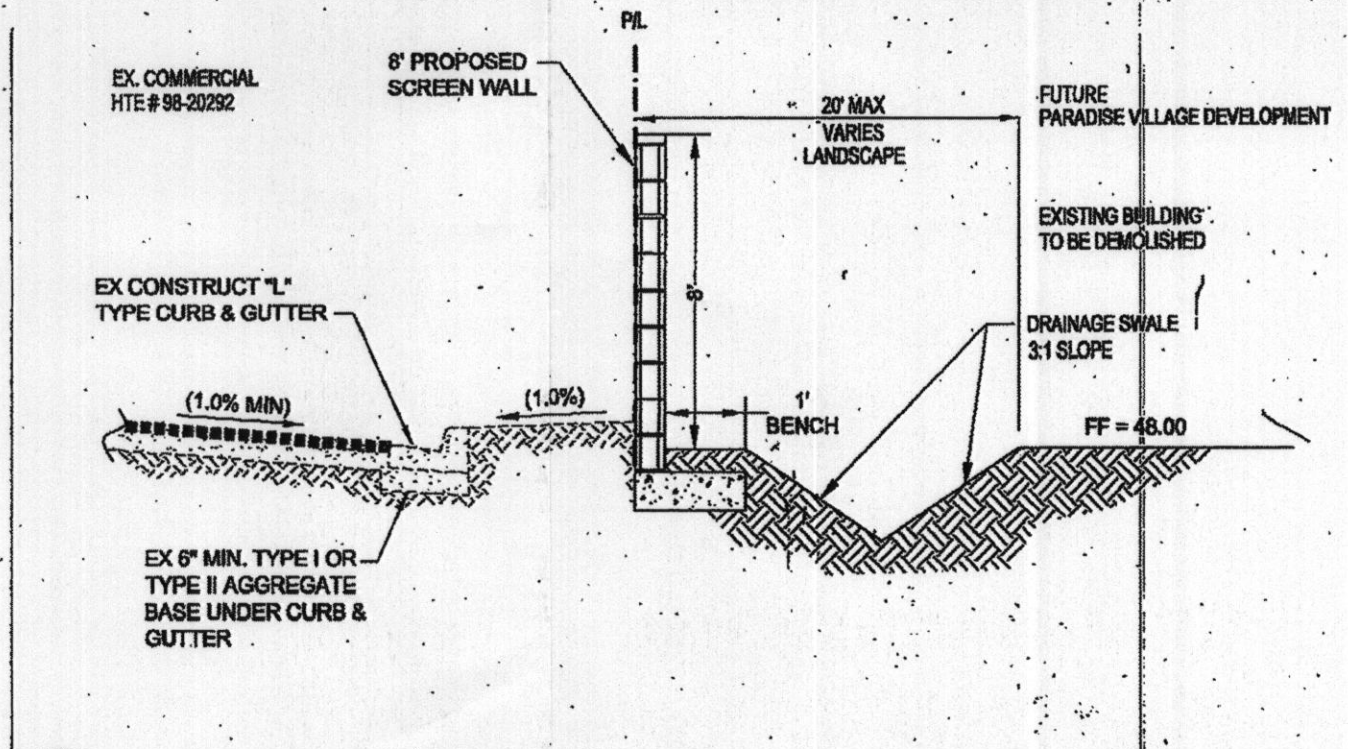


F
D1 CROSS SECTION F
NTS

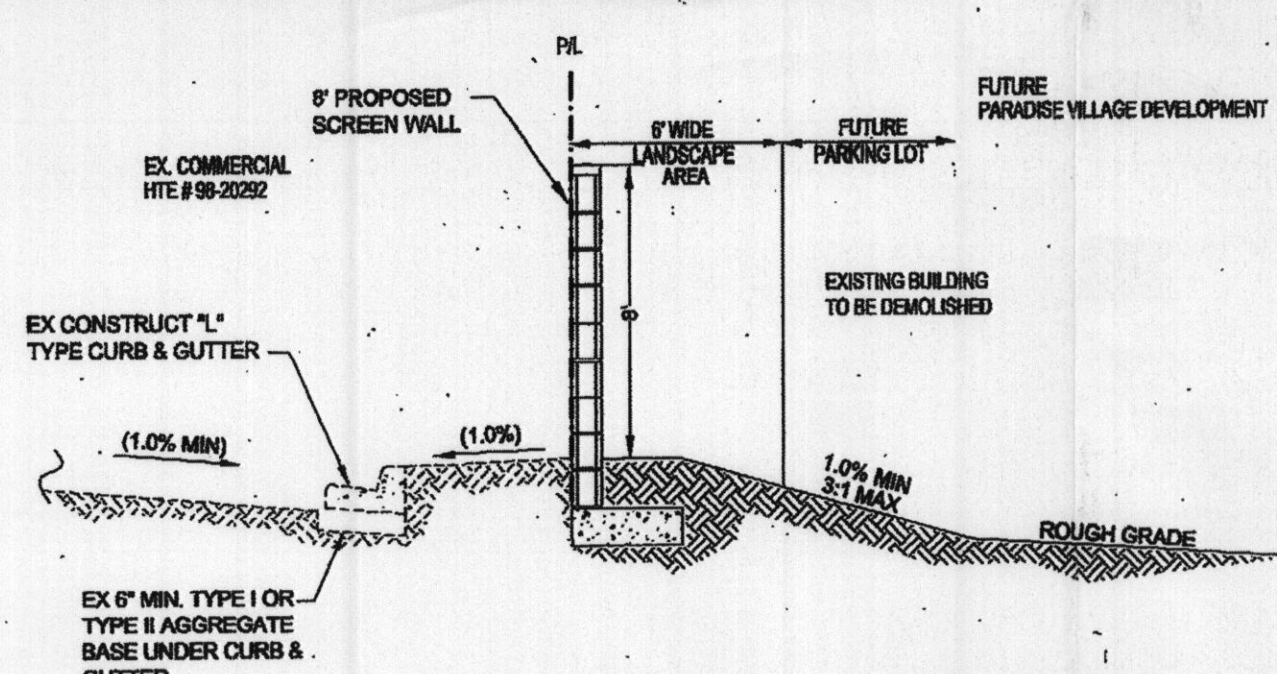


G
D1 CROSS SECTION G
NTS

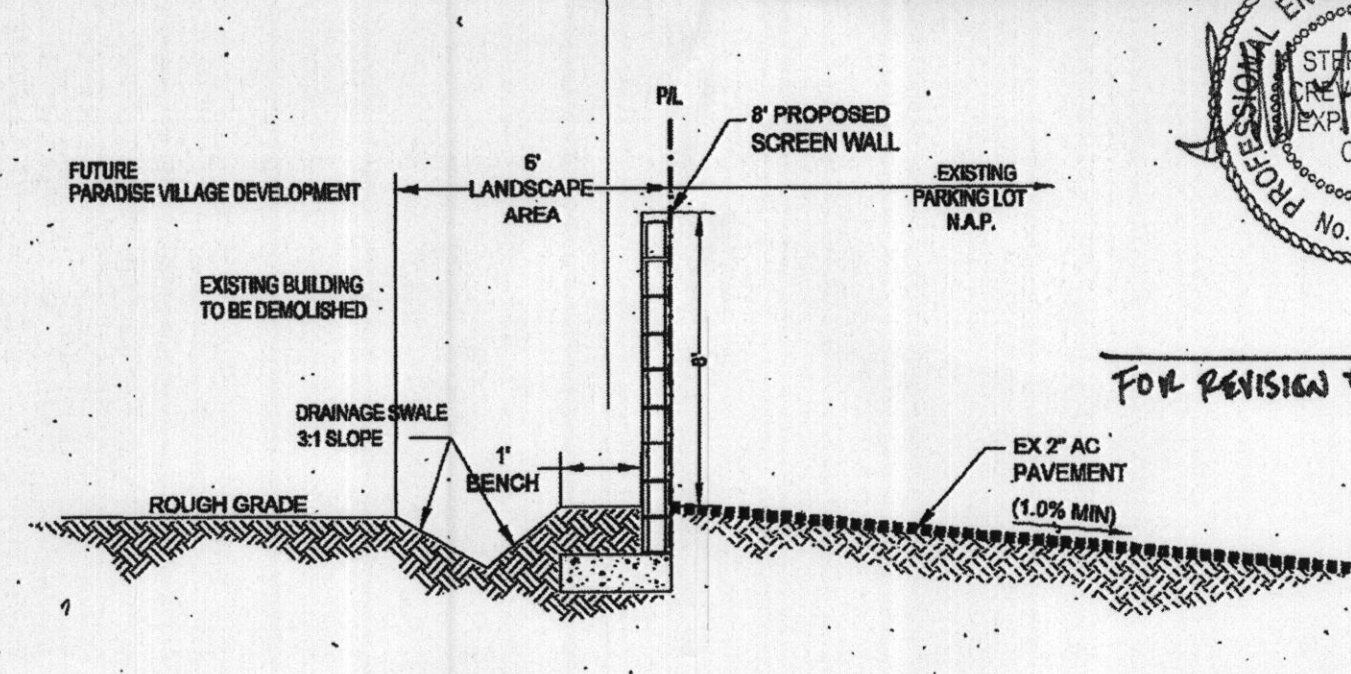


H
D1 CROSS SECTION H
NTS

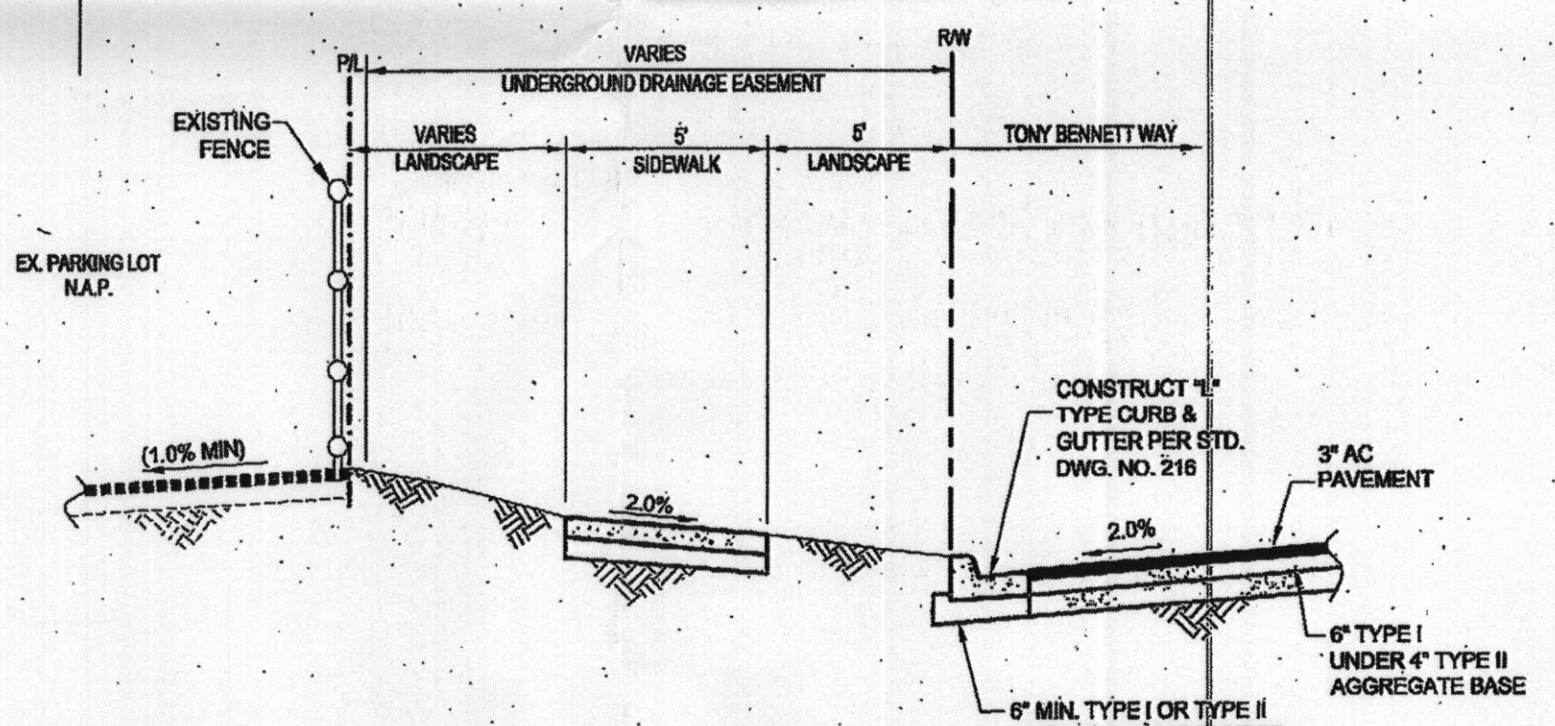

I
D1 CROSS SECTION I
NTS

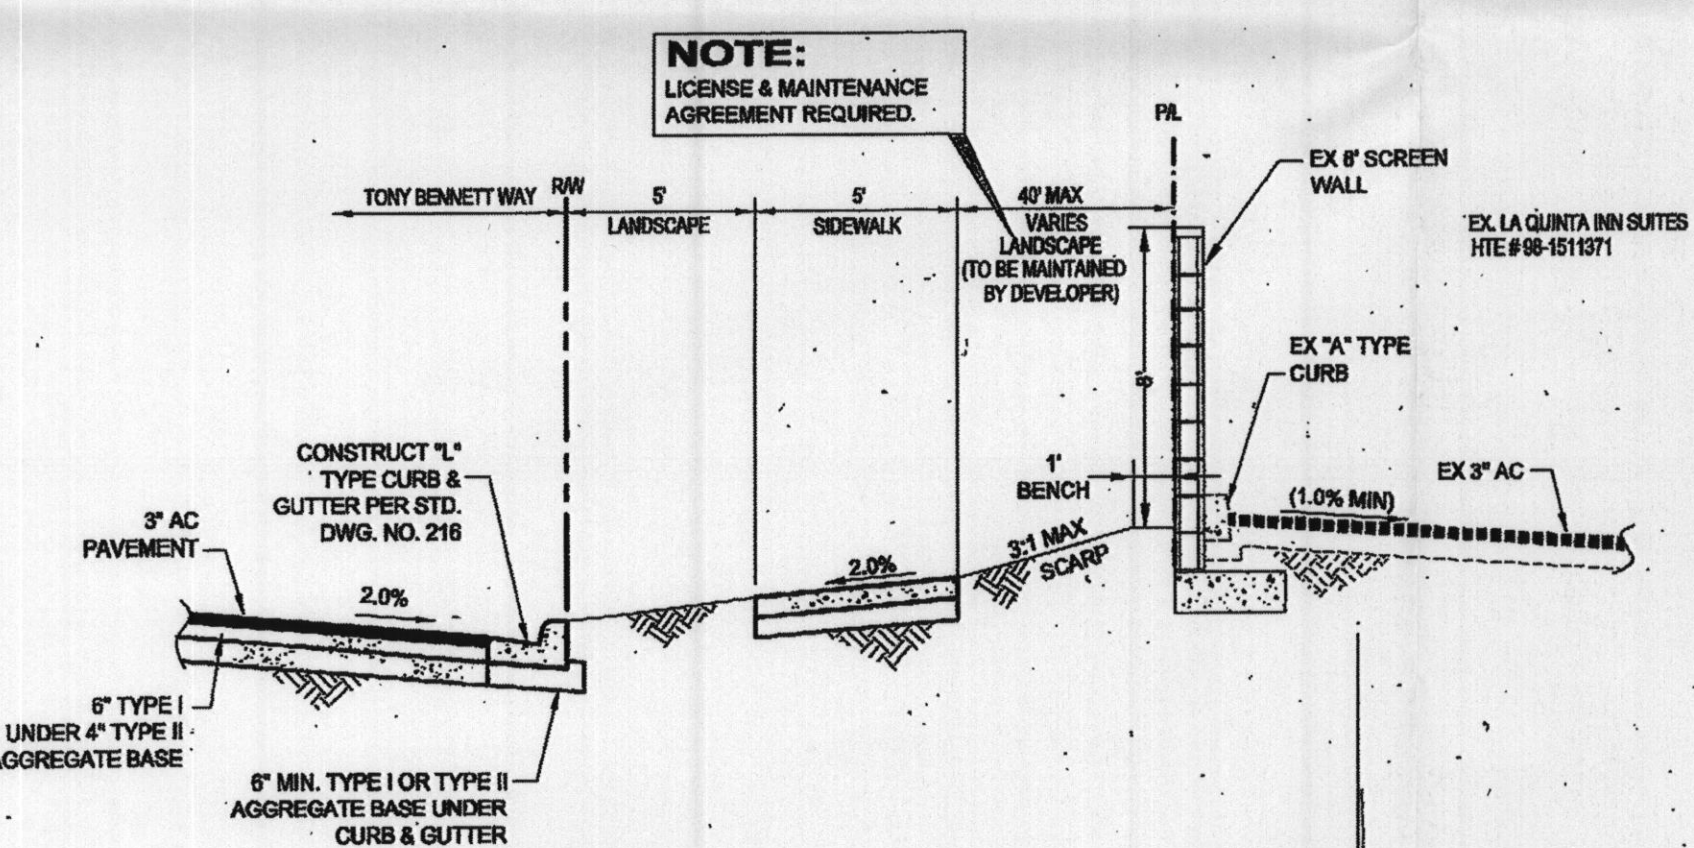



J
D1 CROSS SECTION J
NTS

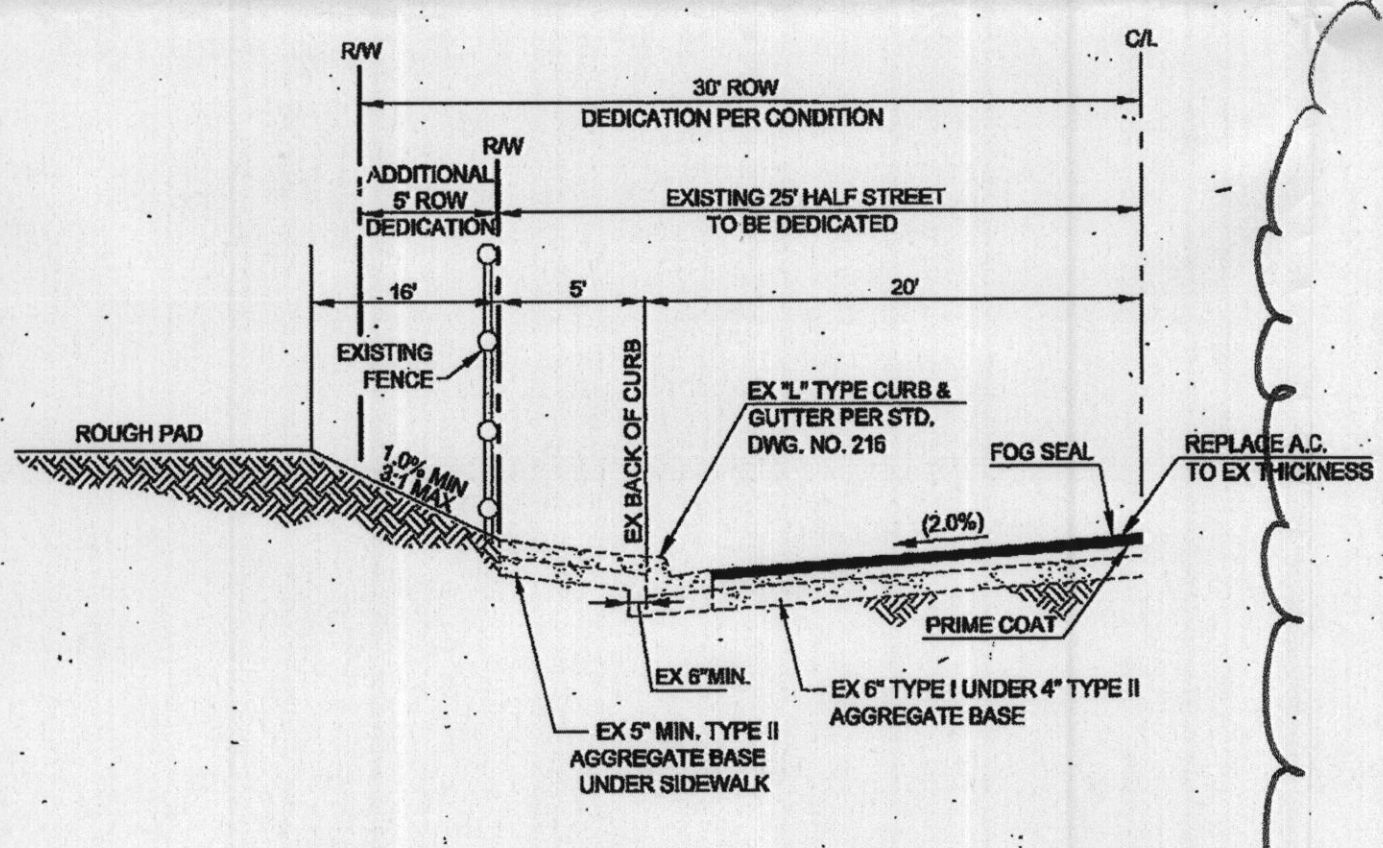

K
D1 NORTH PL. SECTION (ALBERT STREET)
NTS

NOTES:

1. DESIGN IS IN ACCORDANCE WITH ASTM C-1430-06 (TABLE 2), SECTION 7.2.
2. FOR EARTH COVER (SEE TABLE) AND INTERSTATE LIVE LOAD.
3. MINIMUM CONCRETE STRENGTH = 5,000 psi.
4. 15'x10' BOX WEIGHT PER FOOT = 6,880 LBS.
5. 12'x8' BOX WEIGHT PER FOOT = 4,880 LBS.

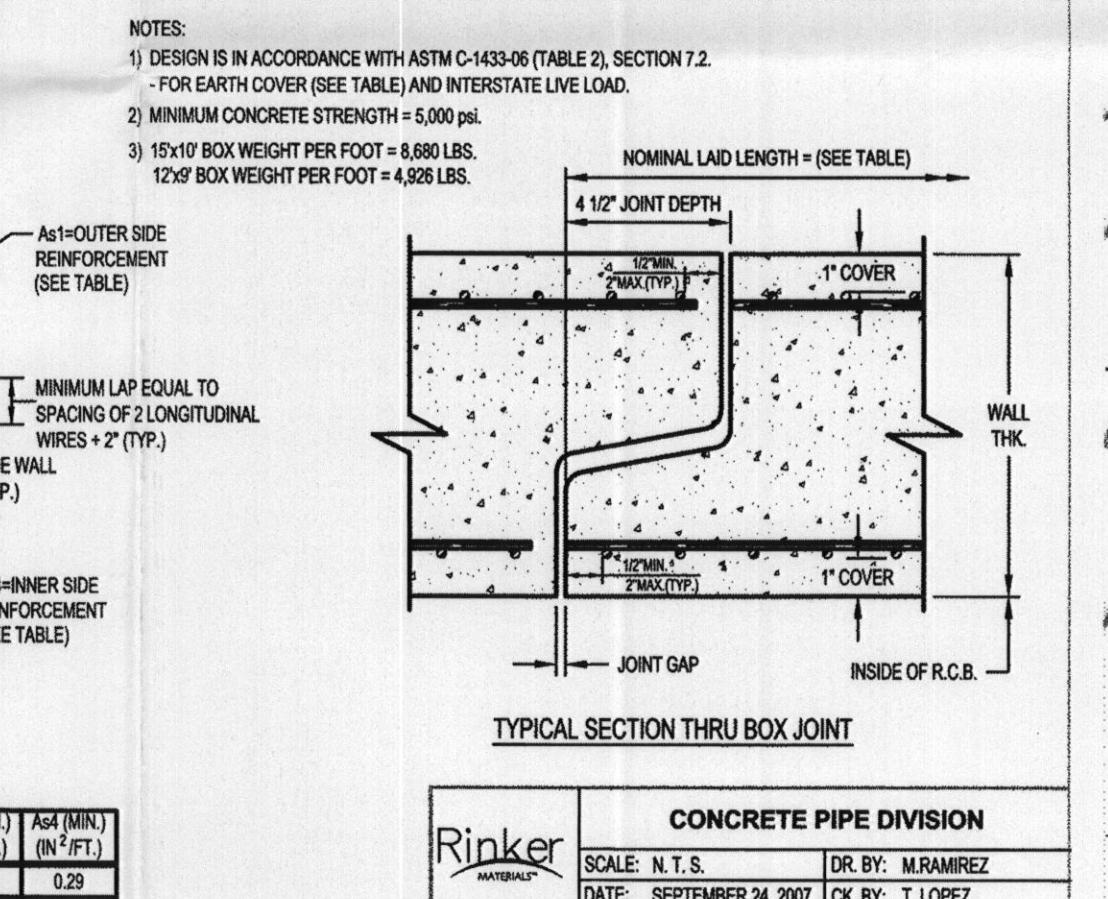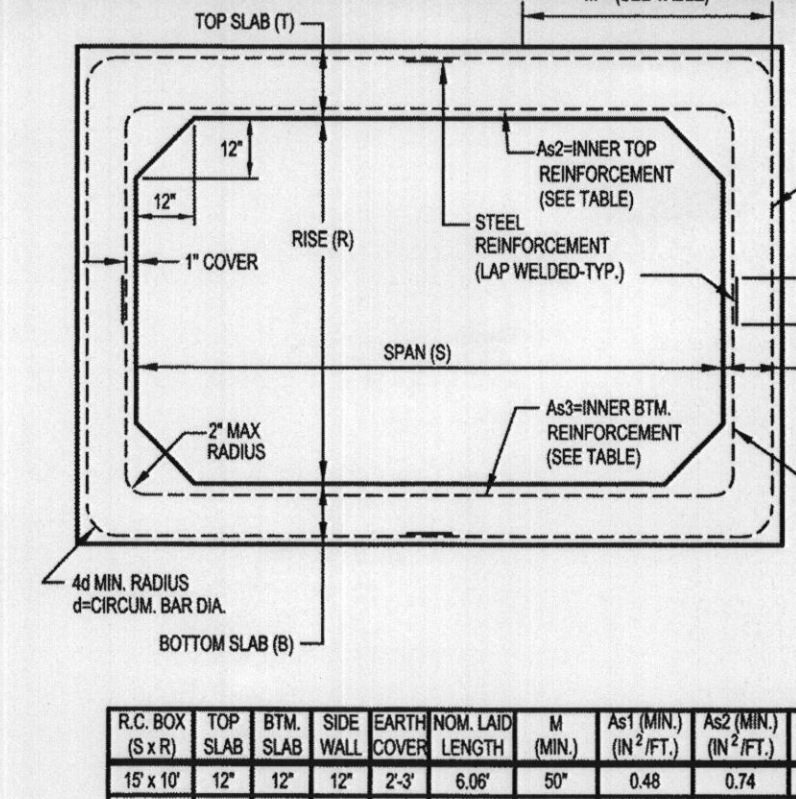

CONCRETE PIPE DIVISION

SCALE: N.T.S.

DATE: SEPTEMBER 24, 2007

PROJECT: PARADISE VILLAGE

LOCATION: LAS VEGAS, NEVADA

LAPOUR PARTNERS
5525 S. DECATUR BLVD. STE. 101
LAS VEGAS, NV 89118
PH: (702) 222-3072 FAX: (702) 222-0861

ENGINEERING COMPANY
3321 N. BULFORD DRIVE, SUITE 200
LAS VEGAS, NEVADA 89118
TEL: (702) 877-1808 FAX: (702) 877-3300

ALPHA


PARADISE VILLAGE OFFSITE PLANS


DETAIL SHEET 1 OF 3

D1

8 OF 29 SHEETS

HTE# 07-15692

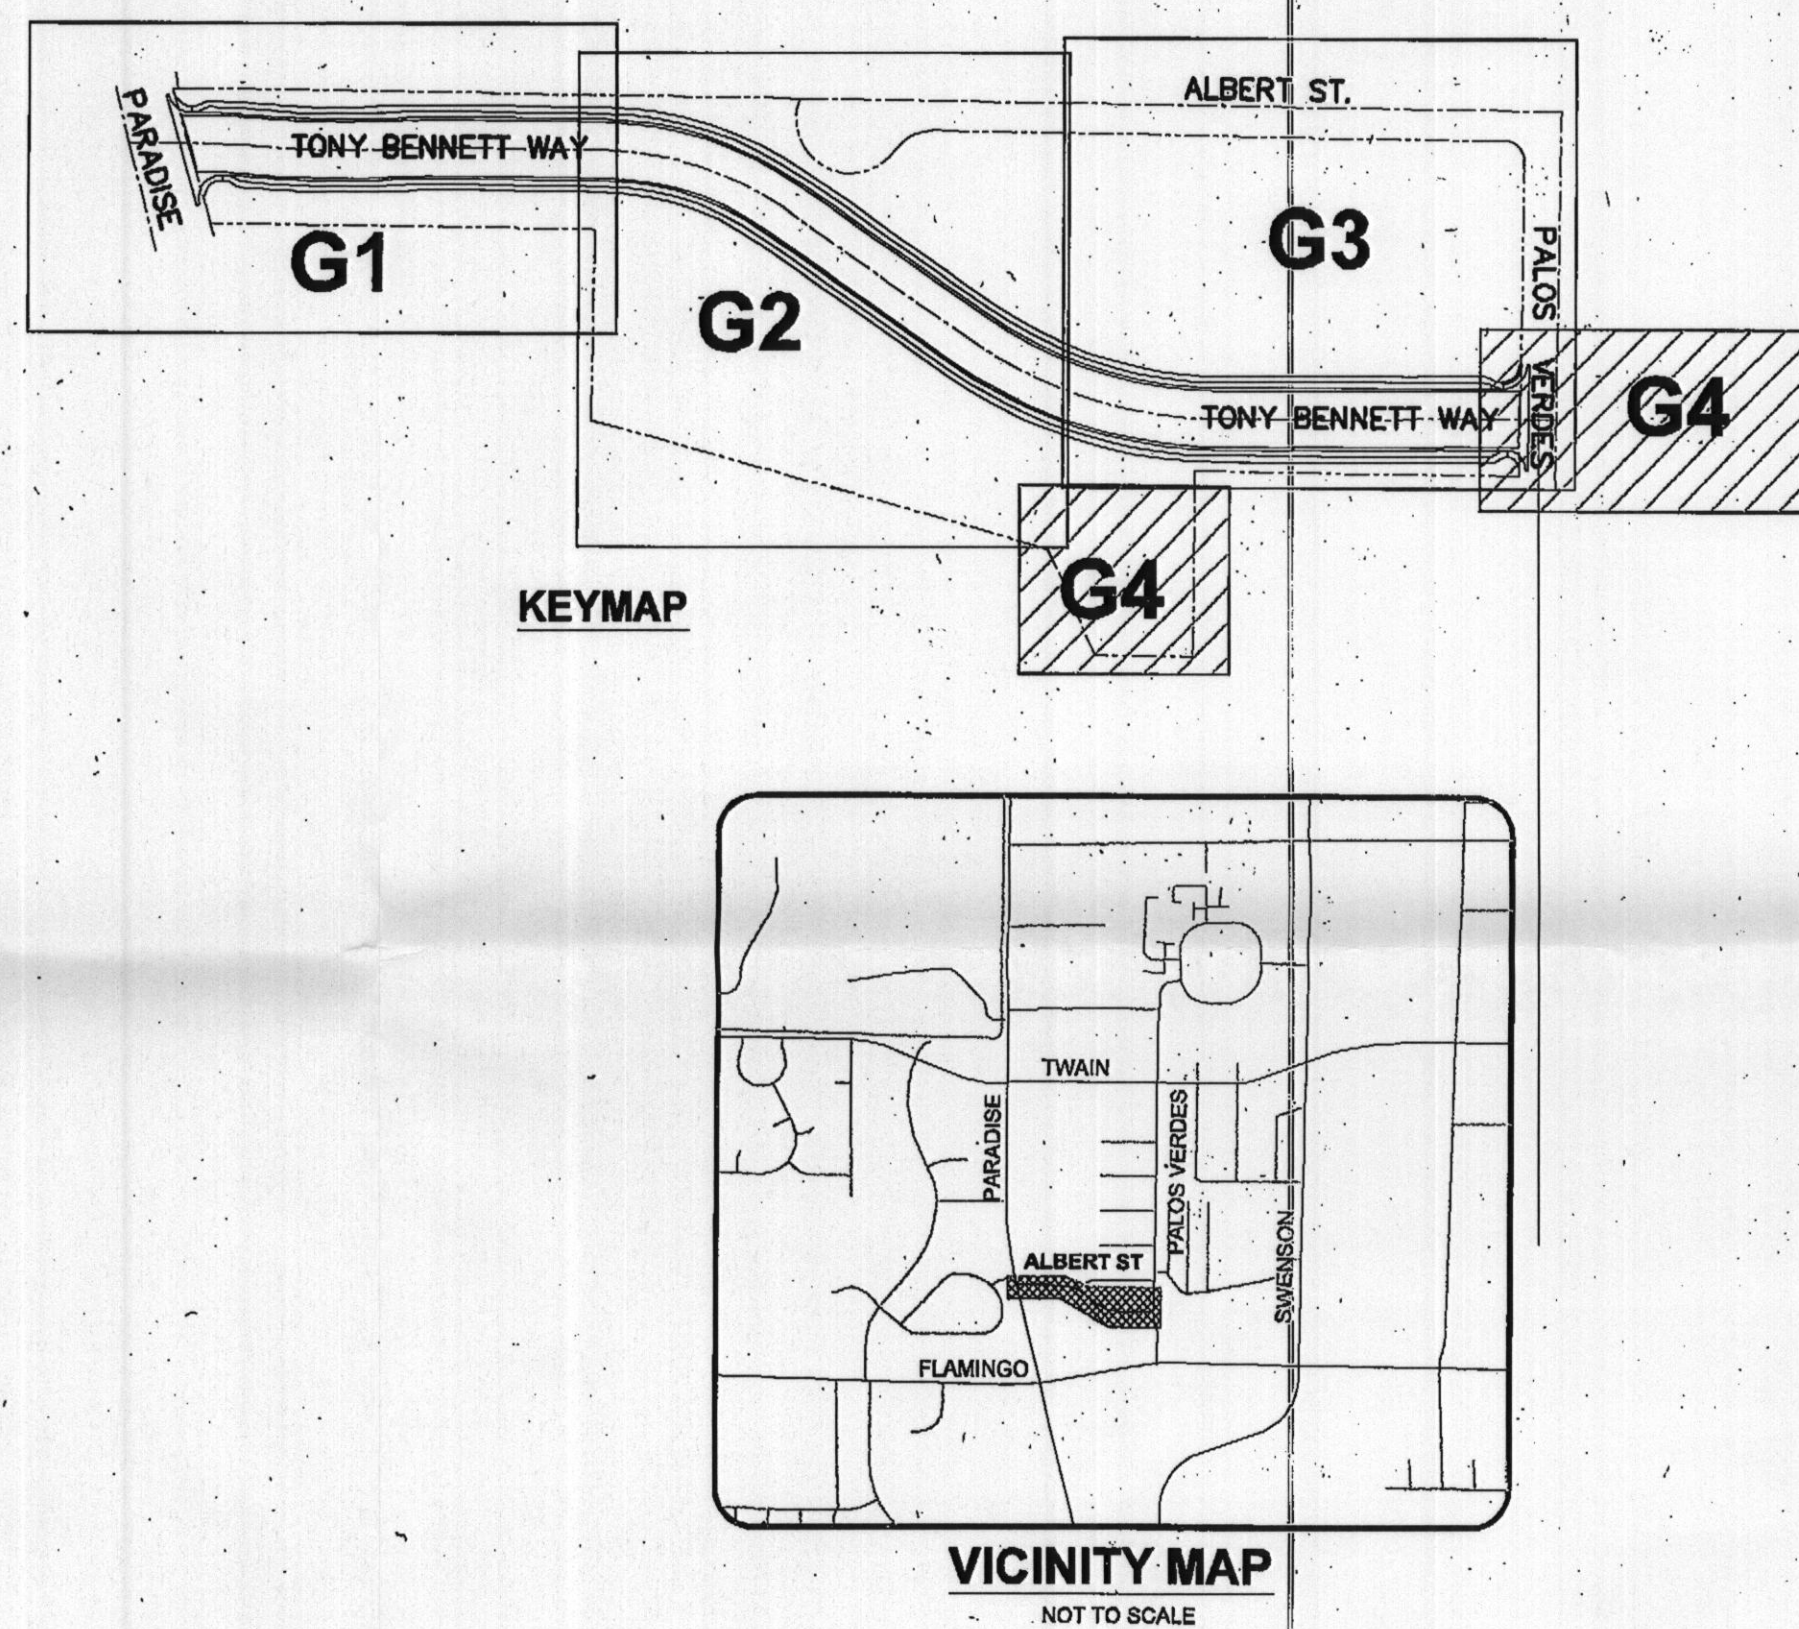

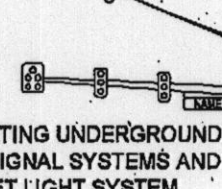A diagram showing a traffic signal pole with two lights. A car is at the intersection, and a pedestrian is crossing the street. The text 'CALL' is written above the pedestrian.


**AVOID HITTING UNDERGROUND
TRAFFIC SIGNAL SYSTEMS AND
STREET LIGHT SYSTEMS
CONDUITS IT'S COSTLY**

**Call
before you
Underground**

**CALL BEFORE YOU
DO
UNDERGROUND**


1-702-455-7511
CLARK COUNTY TRAFFIC OPERATIONS
AND
1-702-432-5300

LAS VEGAS AREA COMPUTERIZED TRAFFIC SYSTEM

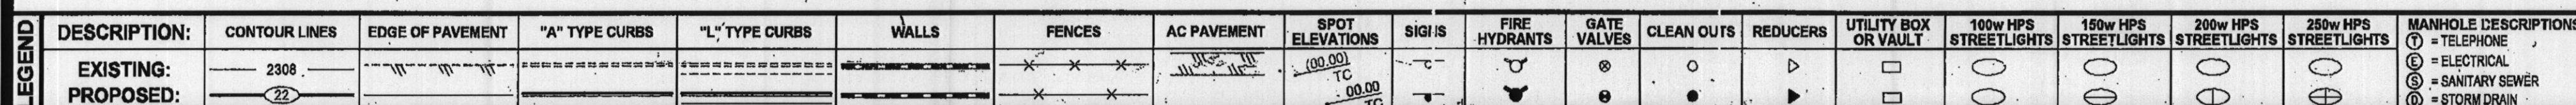

10

07-15

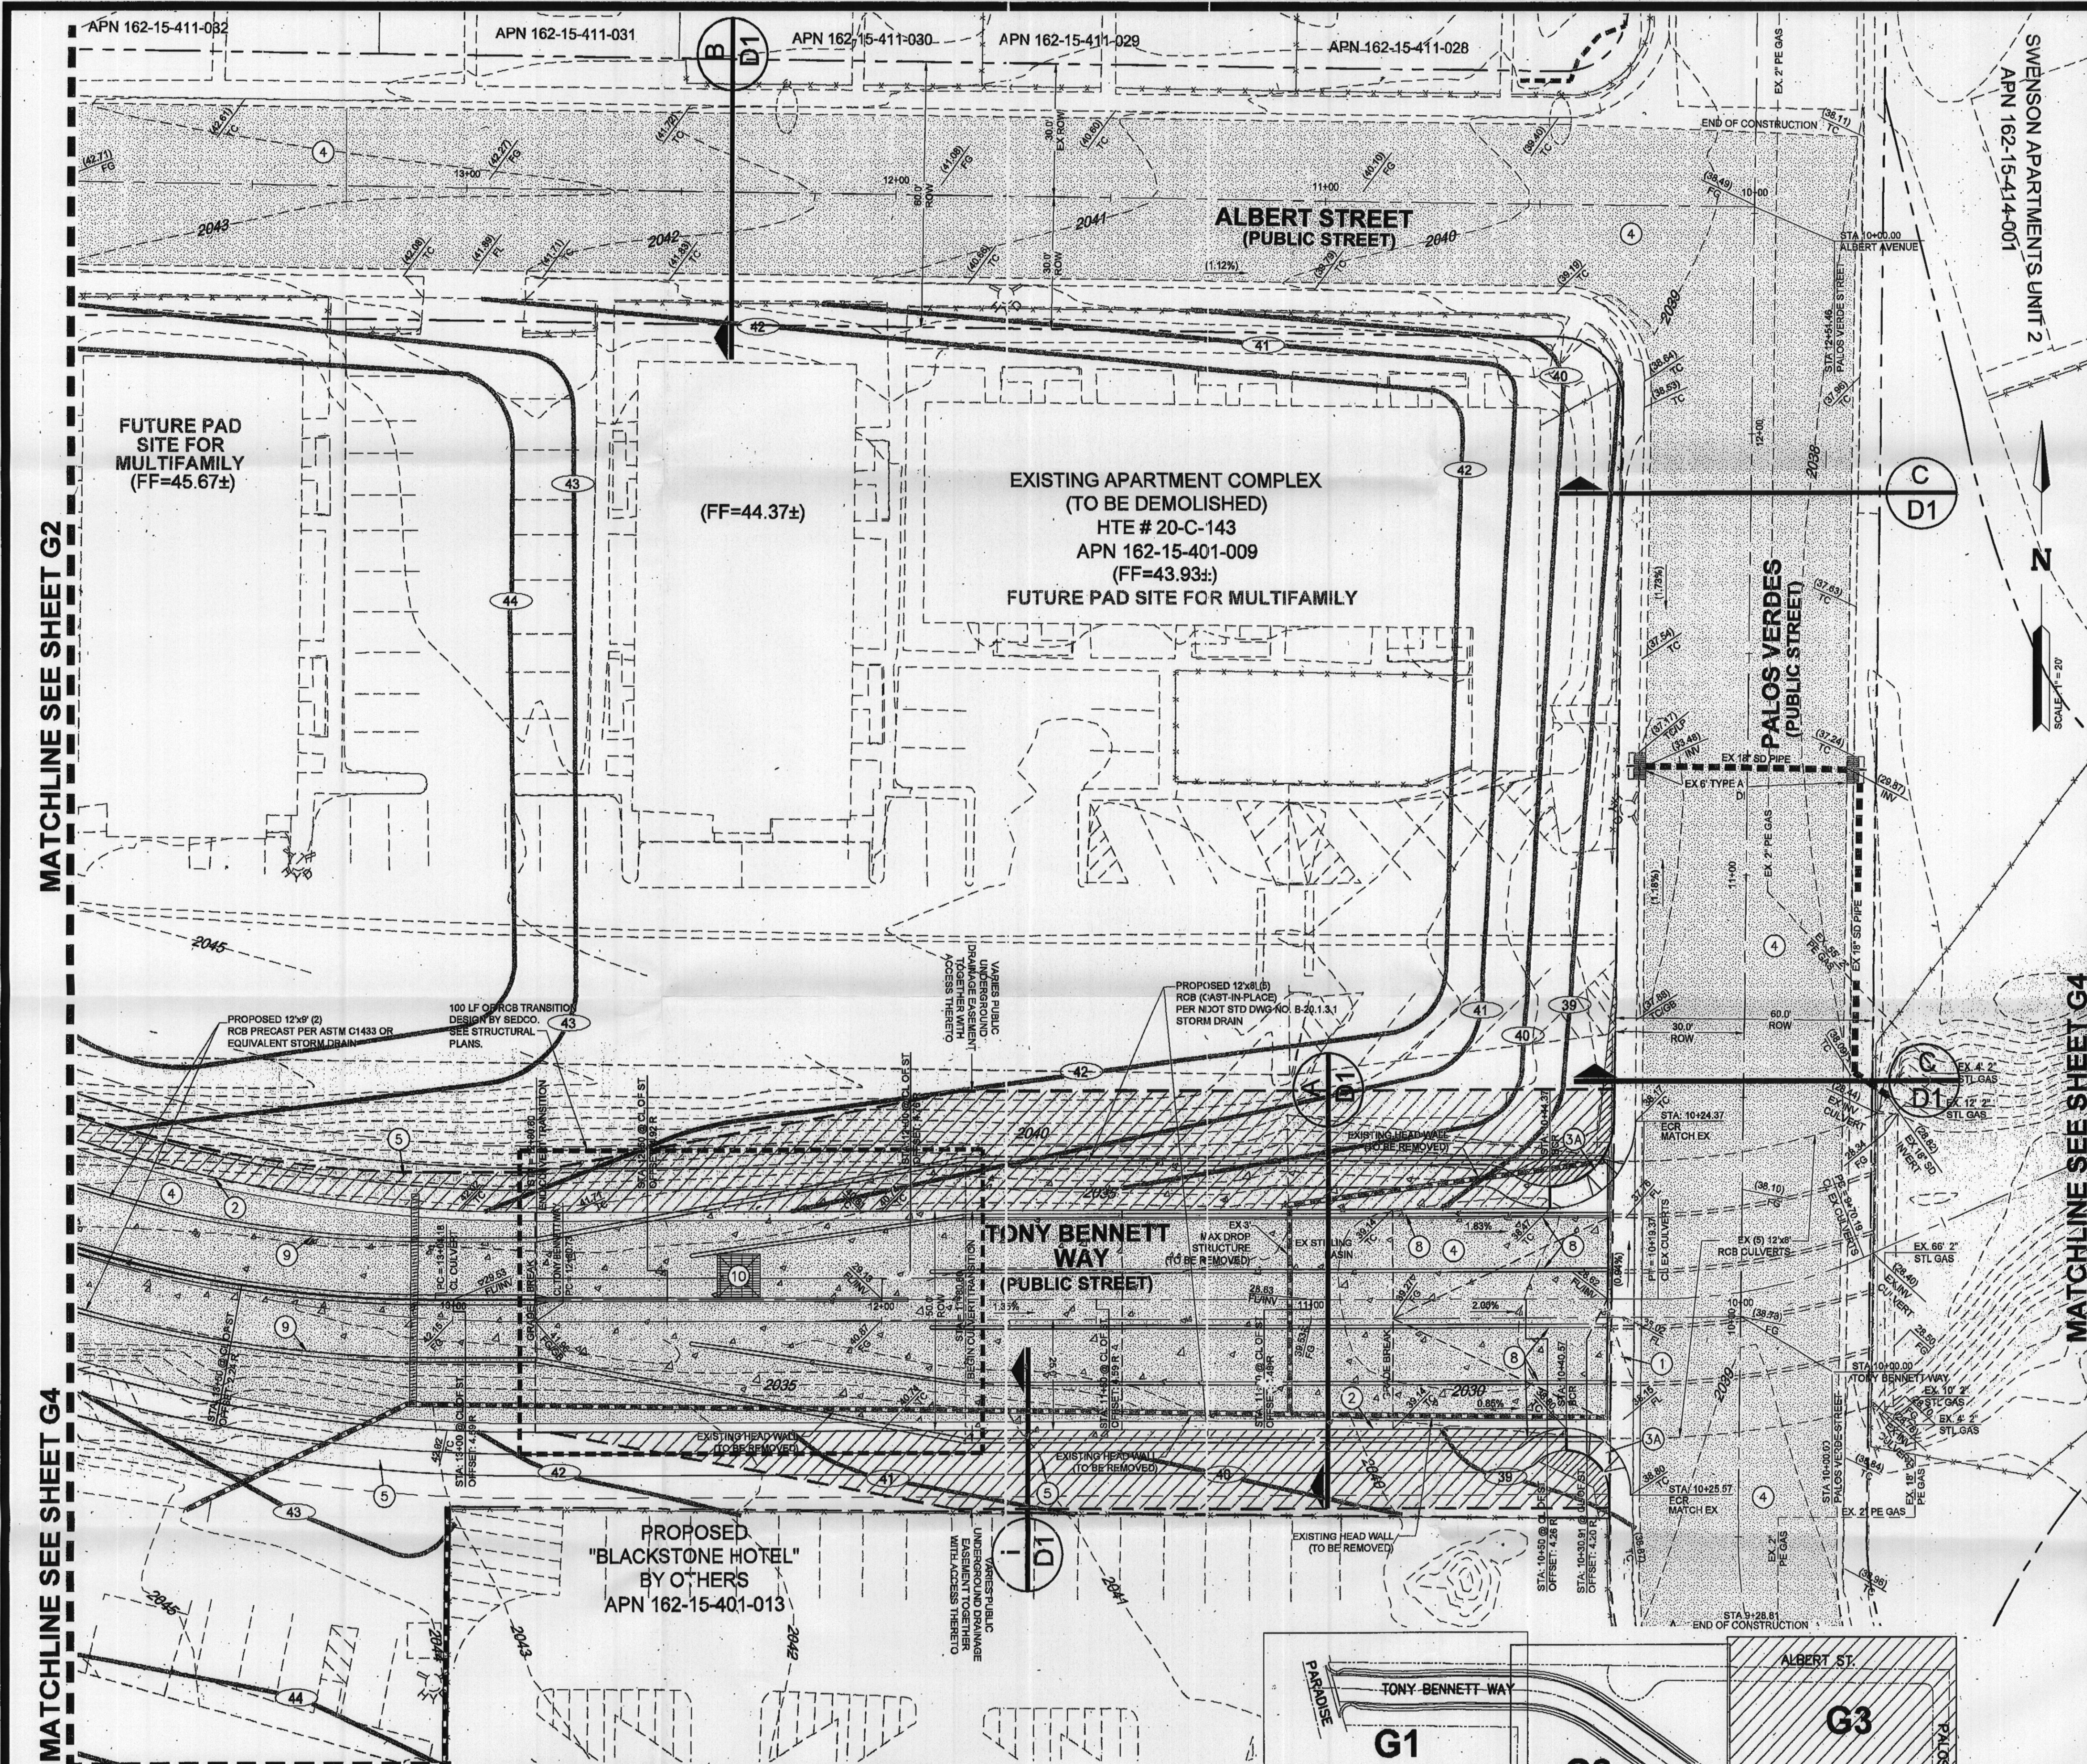


SVZ NOTE:
NO STRUCTURE, VEGETATION, OR OBJECT OF ANY KIND IS PERMITTED OVER TWENTY-FOUR (24) INCHES IN HEIGHT (MEASURED FROM THE TOP OF THE ADJACENT CURB IF CURB EXISTS) WITHIN THE SIGHT VISIBILITY ZONES.

BASIS OF BEARING:
THE BASIS OF BEARINGS FOR THIS SURVEY IS THE WEST LINE OF THE SOUTHWEST ONE-QUARTER OF SECTION 15, TOWNSHIP 21 SOUTH, RANGE 61 EAST, M.D.M. WHICH BEARS NORTH 00°04'12" EAST AS SHOWN IN THE OFFICE OF THE CLARK COUNTY, NEVADA RECORDER IN FILE 143 OF SURVEYS ON PAGE 22.

LEGAL DESCRIPTION:
THE SOUTH HALF (S 1/2) OF THE SOUTHWEST QUARTER (SW 1/4) OF SECTION 15, TOWNSHIP 21 SOUTH, RANGE 61 EAST, M.D.M. IN THE COUNTY OF CLARK, STATE OF NEVADA. APN NO. 162-15-401-005, 006, 007, 008 AND 009.

BENCHMARK:
CLARK COUNTY BENCHMARK NUMBER 6011 22NWS - RIVET AND SQUARE ALUMINUM PLATE IN TOP OF CURB, NORTHEAST CORNER OF PARADISE RD. AND FLAMINGO RD. NEAR THE PC OF PARADISE RD.
ELEVATION=624.806 METERS=2049.88 US SURVEY FEET (NAVD 88 DATUM)

- CONSTRUCTION NOTES:**
1. CONSTRUCT 8" WIDE CONCRETE VALLEY GUTTER PER C.C.A.U.S.D. NO. 228.
 2. CONSTRUCT 24" "L" TYPE CURB & GUTTER PER C.C.A.U.S.D. NO. 216.
 3. CONSTRUCT SIDEWALK RAMP USING ARMOR TILE TRUNCATED DOMES OR EQUIVALENT PER C.C.A.U.S.D. NO. 235, CASE 1.
 4. CONSTRUCT 3" AC PAVEMENT ON 4" TYPE II OVER 6" TYPE I AGGREGATE BASE.
 5. CONSTRUCT 6" CONCRETE SIDEWALK PER C.C.A.U.S.D. NO. 234.
 6. INSTALL SIDEWALK UNDERDRAIN PER CC STD DWG # 236.
 7. CONSTRUCT 2' 15" x 10' PRECAST MONOLITHIC, IN PLACE REINFORCE CONCRETE BOX PER RINKERS MATERIAL.
 8. CONSTRUCT 5' 12" x 8" CAST-IN-PLACE REINFORCE CONCRETE BOX (RCB) PER NDOT STD DWG NO. B-20.1.3.1 SEE DETAIL ON SHEET D2.
 9. INSTALL DUAL 12" x 9" PRECAST MONOLITHIC, IN PLACE REINFORCE CONCRETE BOX (RCB) PER ASTM C1433 OR EQUIVALENT. SEE DETAIL ON SHEET D2.
 10. INSTALL AN 10' x 10' STEEL LID TRAFFIC RATED STORM DRAIN MANHOLE WITH CONCRETE COLLARS PER ESP STRUCTURAL CALCULATIONS AND PLANS ON SHEET S1.2 AND S1.3. STEEL LID SHALL CONFORM WITH CLARK COUNTY TRAFFIC STANDARDS. DESIGN SHALL BE A PART OF THE SHOP DRAWINGS TO BE REVIEWED AND APPROVED PRIOR TO MANUFACTURING.

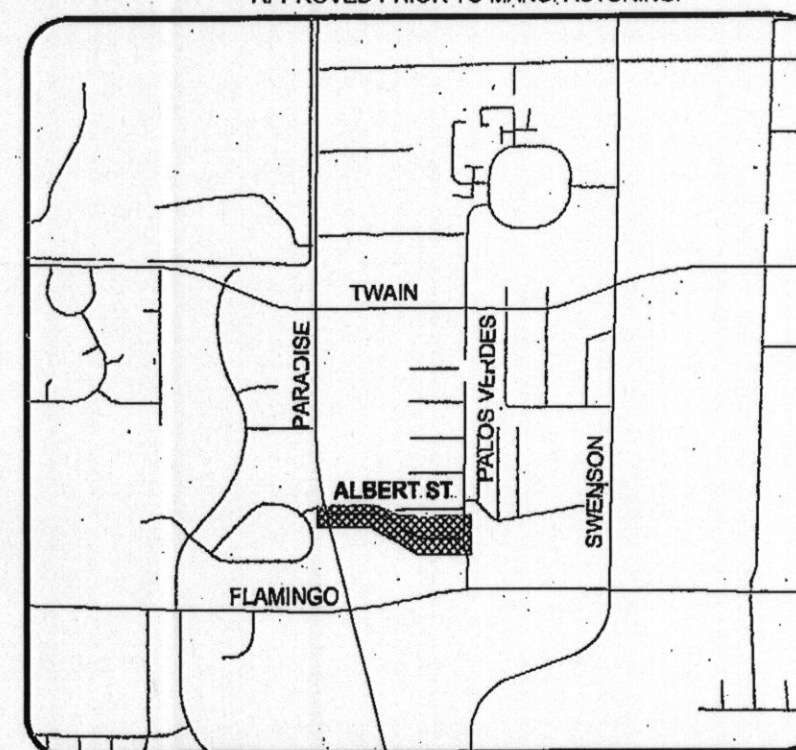

DRAINAGE COMPLIANCE:
THIS PLAN COMPLIES WITH THE APPROVED DRAINAGE STUDY, ON FILE WITH CLARK COUNTY DEPT. OF PUBLIC WORKS. HTE# 05-54297.

Barry C. Benge 8-18-07
DATE

APPROVALS:
CLARK COUNTY DEPARTMENT OF DEVELOPMENT SERVICES

ACCEPTANCE OF PLANS FOR FILING
BY *Mary Davis* 9-18-07
ACCEPTANCE OF PLANS FOR FILING SHALL NOT BE CONSTRUED TO BE A PERMIT FOR OR AN APPROVAL OF AN VIOLATION OF ANY OF THE PROVISIONS OF THE STATE OR COUNTY LAWS AND/OR SPECIFICATIONS. CLARK COUNTY SHALL BE HELD FREE FROM DAMAGES WHICH MAY RESULT FROM THE CONSTRUCTION OF THE IMPROVEMENTS FROM THE ENGINEERING DESIGN DEPICTED HEREIN.
NOTE: POWER POLES AND/OR OTHER EXISTING FACILITIES NOT IN PROPER LOCATION BASED ON PROPOSED IMPROVEMENTS SHOWN HEREON WILL BE RELOCATED AT NO EXPENSE TO CLARK COUNTY.

GEOTECHNICAL REPORT:
ALL GRADING SHALL CONFORM TO THE SOILS REPORT, GEOTECHNICAL EXPLORATION REPORT BY:
AMT ACCLAIM MATERIAL TESTING & INSPECTION LLP
FILE NO.: 05208, DATED 11-2-05.


NOTE: COMPLETION OF SECTION II OR III OF DRAINAGE COMPLIANCE REPORT REQUIRED.

DISCLAIMER NOTE:
UTILITY LOCATIONS SHOWN HEREON ARE APPROXIMATE ONLY. IT SHALL BE THE CONTRACTORS RESPONSIBILITY TO DETERMINE THE EXACT HORIZONTAL AND VERTICAL LOCATION OF ALL EXISTING UNDERGROUND OR OVERHEAD UTILITIES PRIOR TO COMMENCING CONSTRUCTION. NO REPRESENTATION IS MADE THAT ALL EXISTING UTILITIES ARE SHOWN HEREON. THE ENGINEER ASSUMES NO RESPONSIBILITY FOR UTILITIES NOT SHOWN OR UTILITIES NOT SHOWN IN THEIR PROPER LOCATION. CONTRACTOR TO NOTIFY ENGINEER OF ANY CHANGES OR DISCREPANCIES.

Call before you Overhead
1-702-227-2929
CLARK COUNTY DEPARTMENT OF DEVELOPMENT SERVICES

Call before you Dig
1-800-227-2800

Call before you UnderGround
DO UNDERGROUND
1-702-455-7511
CLARK COUNTY TRAFFIC OPERATIONS AND
1-702-432-5300
LAS VEGAS AREA COMPUTERIZED TRAFFIC SYSTEM

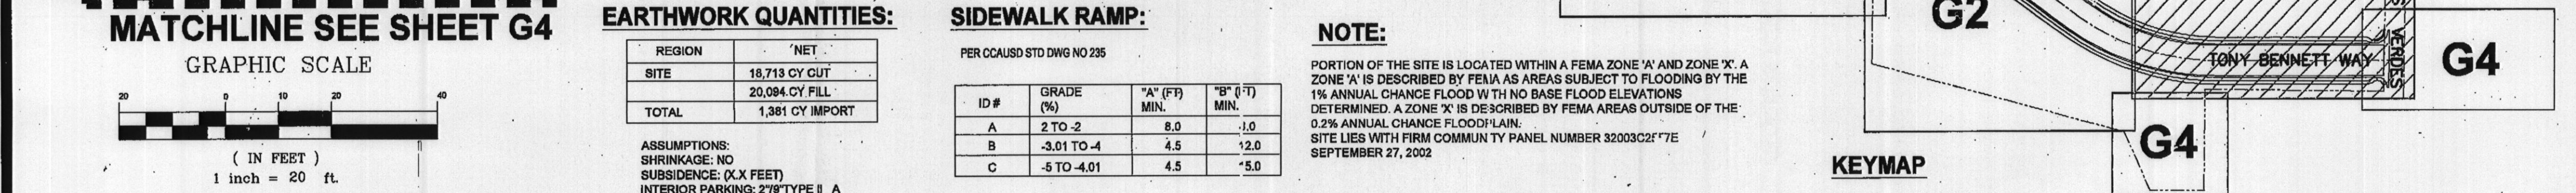

LEGEND	DESCRIPTION:	CONTOUR LINES	EDGE OF PAVEMENT	"A" TYPE CURBS	"L" TYPE CURBS	WALLS	FENCES	AC PAVEMENT	SPOT ELEVATIONS	SIG. IS	FIRE HYDRANTS	GATE VALVES	CLEAN OUTS	REDUCERS	UTILITY BOX OR VAULT	100w HPS STREETLIGHTS	150w HPS STREETLIGHTS	200w HPS STREETLIGHTS	250w HPS STREETLIGHTS	MANHOLE DESCRIPTIONS	ROW LINE	PROPERTY LINE	CL OR SURVEY LINE	SCARP LINE	SAWTOOTH LINE	EASEMENT LINE	CONCRETE PAVT.	SEWER AND WATER SERVICE W/ PRVS	BACKWATER VALVE	ELECTRICAL PEDESTAL	FULL BOX AS SHOWN	POWER POLE
EXISTING:	2308																															
PROPOSED:																																

LAPOUR PARTNERS
5525 SOUTH DECATUR BLVD., SUITE 101
LAS VEGAS, NV 89118
(702) 222-3022

ENGINEERING COMPANY
3321 N. Buffalo Drive, Suite 200
Las Vegas, Nevada 89129
Tel: (702) 877-1300 Fax: (702) 877-0300

ALPHA


PARADISE VILLAGE OFFSITE PLANS


GRADING PLAN
3 OF 4

SCALE:
1" = 20'

SHEET
G3

6 OF 29 SHEETS
DRAWING NO.
HTE# 07-15692

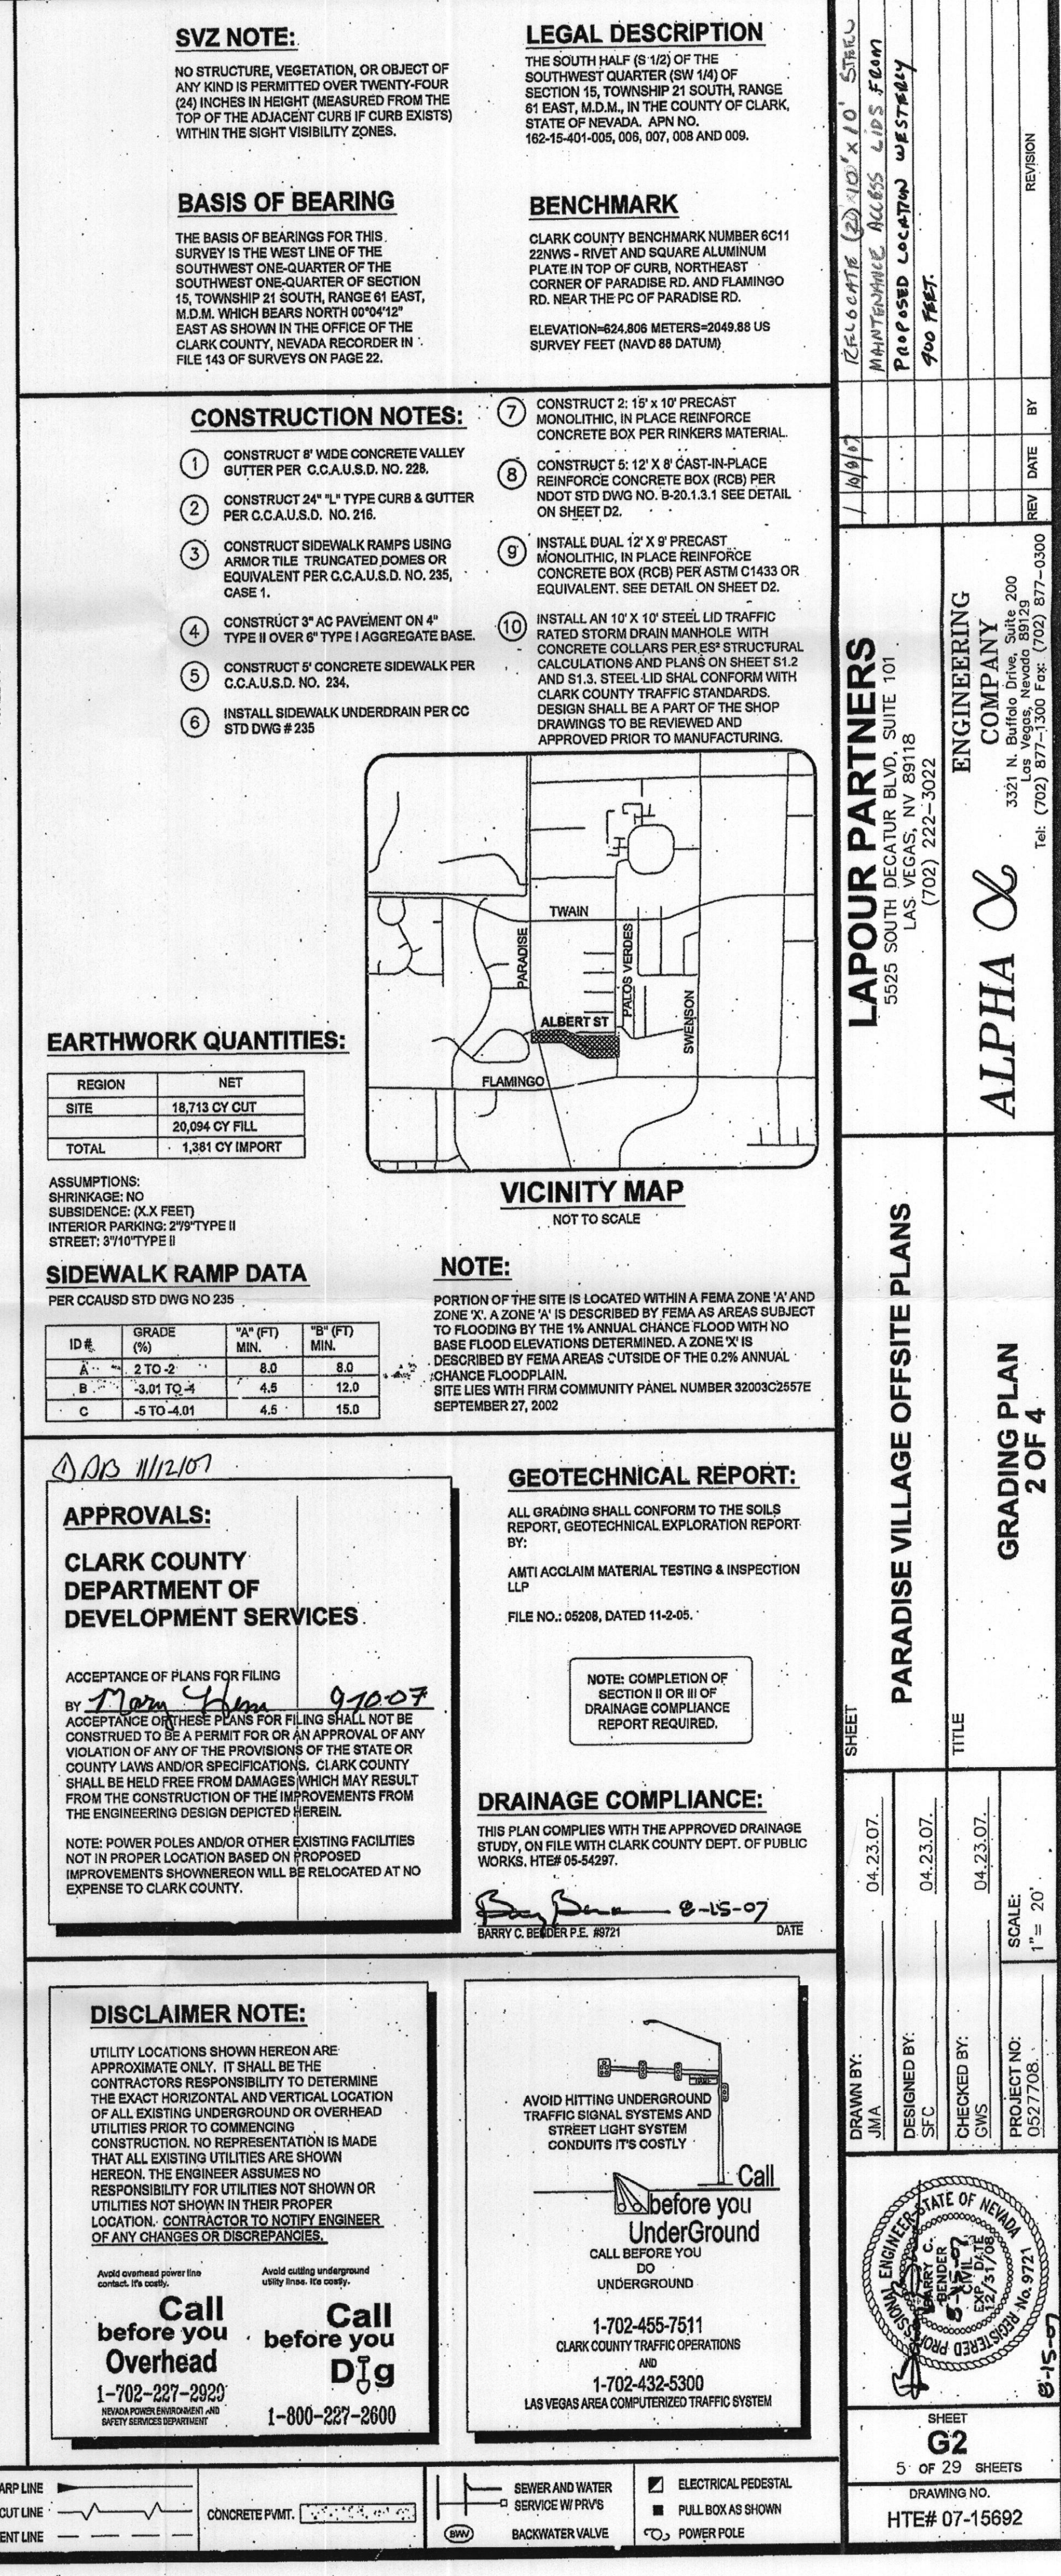

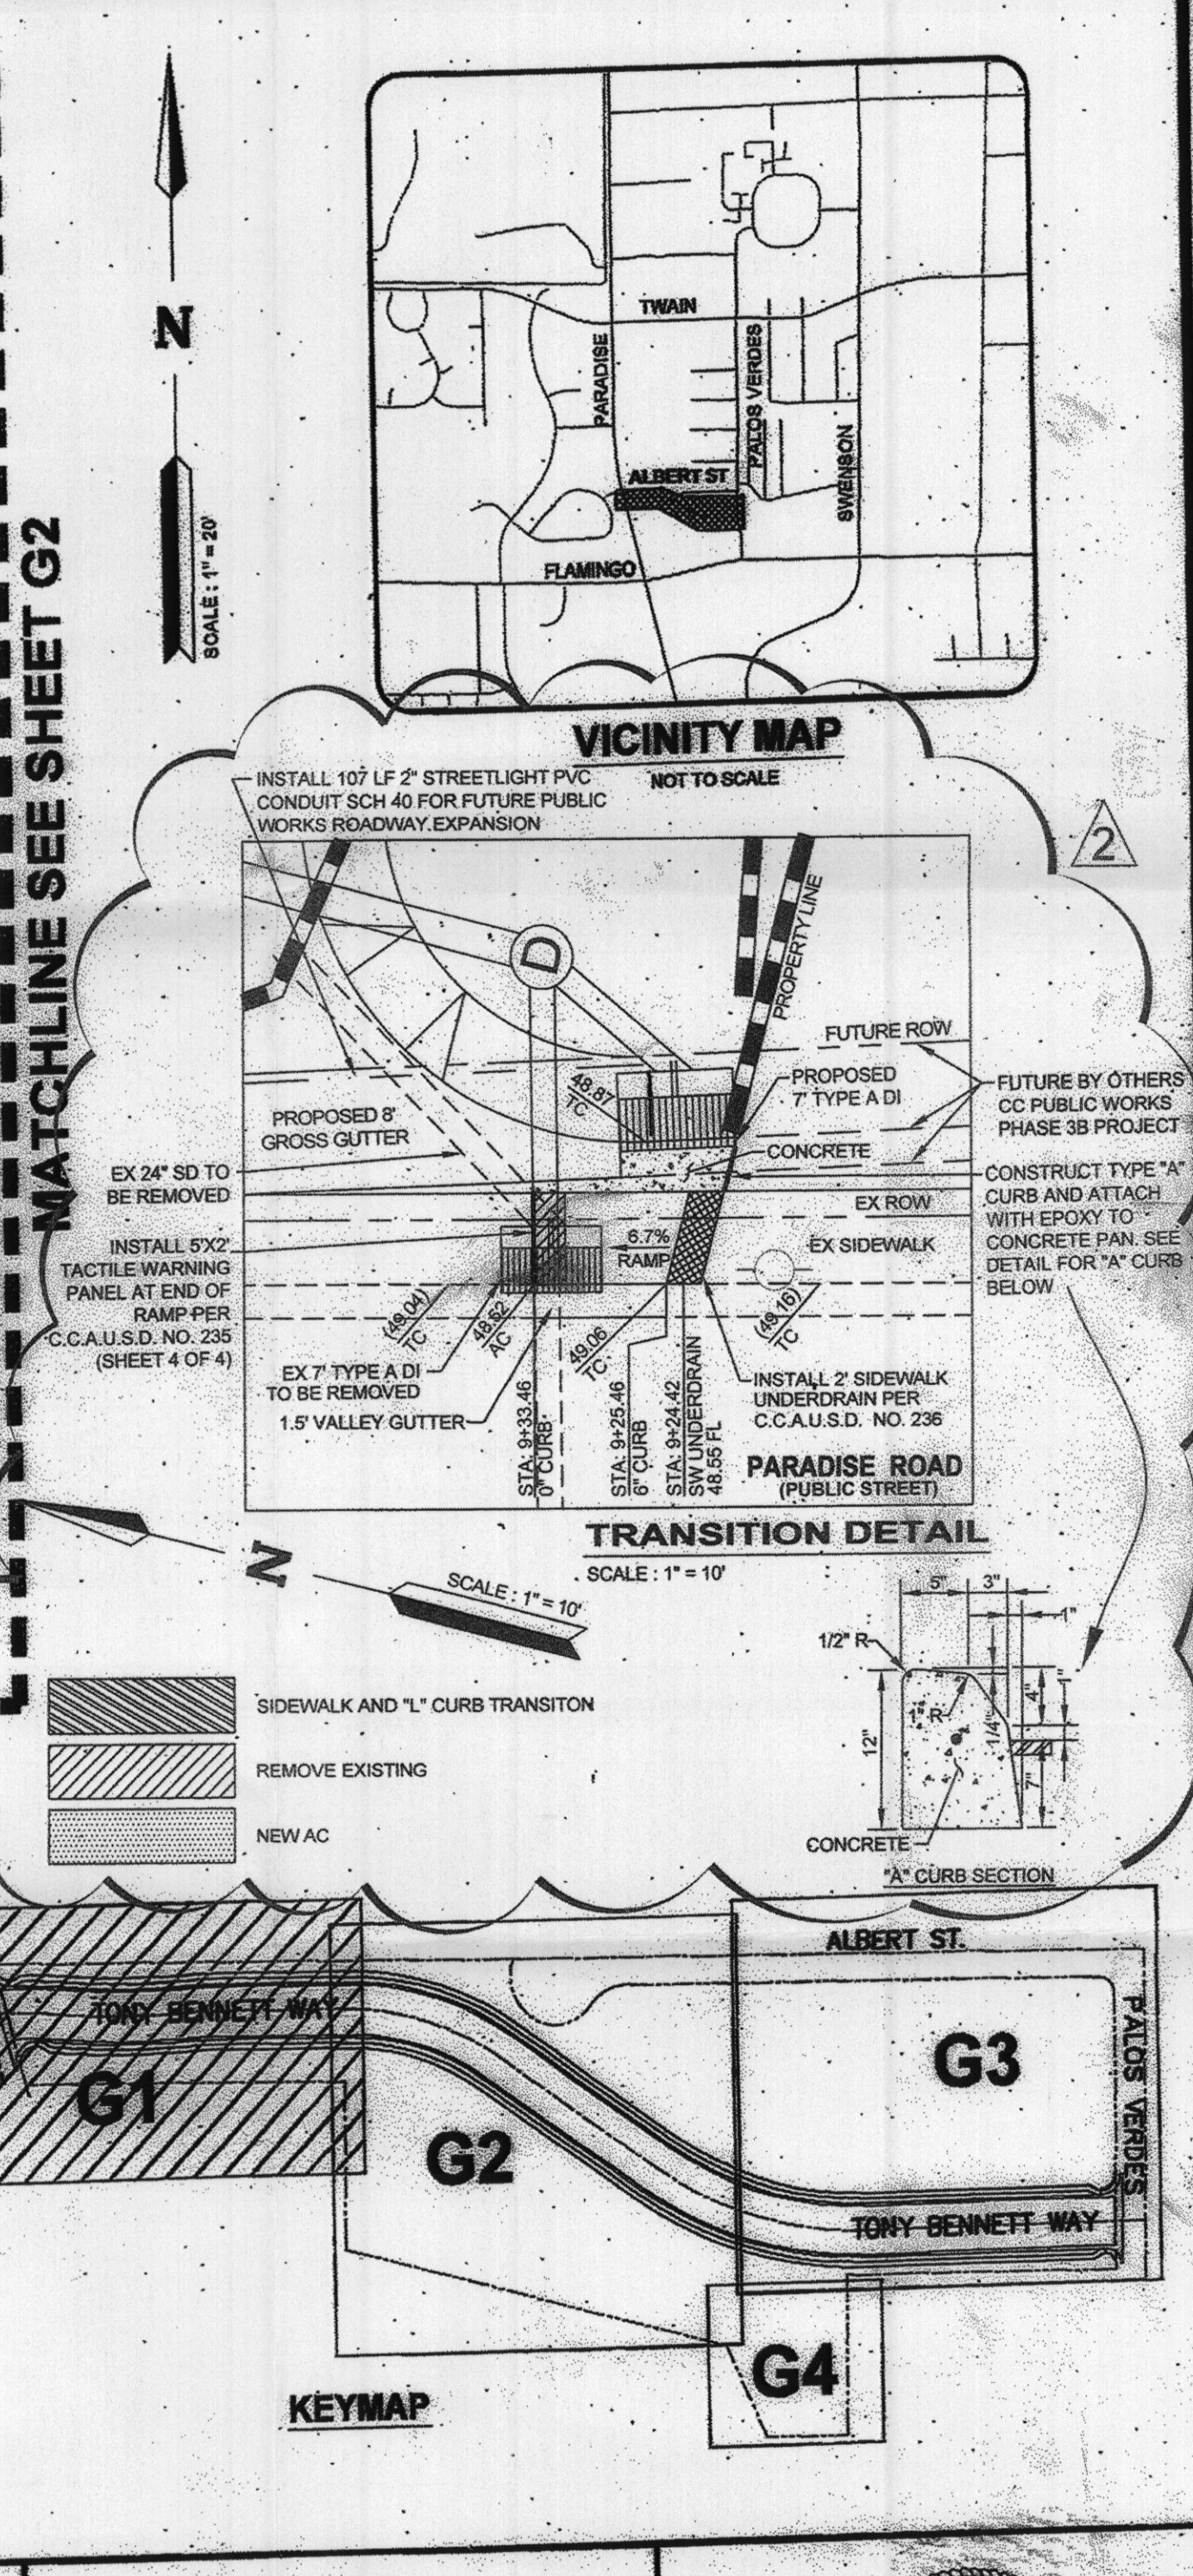

PROPOSED REDLINE REVISIONS

SVZ NOTE:

NO STRUCTURE, VEGETATION, OR OBJECT OF ANY KIND IS PERMITTED OVER TWENTY-FOUR (24) INCHES IN HEIGHT (MEASURED FROM THE TOP OF THE ADJACENT CURB IF CURB EXISTS) WITHIN THE SIGHT VISIBILITY ZONES.

LEGAL DESCRIPTION

THE SOUTH HALF, (S 1/2) OF THE SOUTHWEST QUARTER (SW 1/4) OF SECTION 15, TOWNSHIP 21 SOUTH, RANGE 81 EAST, M.D.M. IN THE COUNTY OF CLARK, STATE OF NEVADA. APN NO. 162-15-401-005, 006, 007, 008 AND 009.

BASIS OF BEARING

THE BASIS OF BEARINGS FOR THIS SURVEY IS THE WEST LINE OF THE SOUTHWEST ONE-QUARTER OF THE SOUTHWEST ONE-QUARTER OF SECTION 15, TOWNSHIP 21 SOUTH, RANGE 81 EAST, M.D.M. WHICH BEARS NORTH 09°41'2" EAST AS SHOWN IN THE OFFICE OF THE CLARK COUNTY, NEVADA RECORDER IN FILE #43 OF SURVEYS ON PAGE 22.

BENCHMARK

CLARK COUNTY BENCHMARK NUMBER 6C41 22NWS - RIVET AND SQUARE ALUMINUM PLATE IN TOP OF CURB, NORTHEAST CORNER OF PARADISE RD. AND FLAMINGO RD. NEAR THE PC OF PARADISE RD.

ELEVATION 424.805 METERS = 1393.88 US SURVEY FEET (NAVD 83 DATUM)

EARTHWORK QUANTITIES:

REGION	NET
SITE	18,753 CY CUT
TOTAL	20,004 CY FILL
	1,251 CY IMPORT

ASSUMPTIONS:
SHRINKAGE: NO
SURROUNDS: (P, X FEET)
INTERIOR PARKING: 27' TYPE II A
STREET: 37'10" TYPE II

CONSTRUCTION NOTES:

- CONSTRUCT 8" WIDE CONCRETE VALLEY GUTTER PER C.C.A.U.S.D. NO. 228.
- CONSTRUCT 2" 14" TYPE CURB & GUTTER PER C.C.A.U.S.D. NO. 218.
- CONSTRUCT SIDEWALK RAMPS USING ARMOR TILE TRUNCATED DORIES OR EQUIVALENT PER C.C.A.U.S.D. NO. 235, CASE 1.
- CONSTRUCT 3" AC PAVEMENT ON 4" TYPE II OVER 6" TYPE I AGGREGATE BASE.
- CONSTRUCT 5" CONCRETE SIDEWALK PER C.C.A.U.S.D. NO. 234.
- INSTALL SIDEWALK UNDERDRAIN PER CC STD DWG #236
- CONSTRUCT 2: 15' x 10' PRECAST MONOLITHIC, IN PLACE REINFORCE CONCRETE BOX PER PARADISE MATERIAL.
- CONSTRUCT 8: 12' x 8' CAST-IN-PLACE REINFORCE CONCRETE BOX (RQB) PER NDOT STD DWG NO. 5-201.3.1 SEE DETAIL ON SHEET D2.
- INSTALL DUAL 12" x 9" PRECAST MONOLITHIC, IN PLACE REINFORCE CONCRETE BOX (RQB) PER ASTM C493 OR EQUIVALENT. SEE DETAIL ON SHEET D2.
- INSTALL AN 10' x 10' STEEL LID TRAFFIC RATED STORM DRAIN MANHOLE WITH CONCRETE COLLARS PER ESP STRUCTURAL CALCULATIONS AND PLANS ON SHEET S1.2 AND S1.3. STEEL LID SHALL CONFORM WITH DESIGN SHALL BE A PART OF THE SHOP DRAWINGS TO BE REVIEWED AND APPROVED PRIOR TO MANUFACTURING.

NOTE:

PORTION OF THE SITE IS LOCATED WITHIN A FEMA ZONE "X" AND ZONE "A". A ZONE "X" IS DESCRIBED BY FEMA AS AREAS SUBJECT TO FLOODING BY THE 1% ANNUAL CHANCE FLOOD WITH NO BASE FLOOD ELEVATIONS DETERMINED. A ZONE "A" IS DESCRIBED BY FEMA AREAS OUTSIDE OF THE 0.2% ANNUAL CHANCE FLOODPLAIN. SITE USES WITH FIRM COMMUNITY PANEL NUMBER 32006C2557E SEPTEMBER 27, 2002.

DISCLAIMER NOTE:

UTILITY LOCATIONS SHOWN HEREON ARE APPROXIMATE ONLY. IT SHALL BE THE CONTRACTOR'S RESPONSIBILITY TO DETERMINE THE EXACT HORIZONTAL AND VERTICAL LOCATION OF ALL EXISTING UNDERGROUND OR OVERHEAD UTILITIES PRIOR TO COMMENCING CONSTRUCTION. NO REPRESENTATION IS MADE THAT ALL EXISTING UTILITIES ARE SHOWN HEREON. THE ENGINEER ASSUMES NO RESPONSIBILITY FOR UTILITIES NOT SHOWN OR UTILITIES NOT SHOWN IN THEIR PROPER LOCATION. CONTRACTOR TO NOTIFY ENGINEER OF ANY CHANGES OR DISCREPANCIES.

GRAPHIC SCALE

(IN FEET)
1 inch = 20 ft.

APPROVALS:

CLARK COUNTY DEPARTMENT OF DEVELOPMENT SERVICES

ACCEPTANCE OF PLANS FOR FILING BY *Mary Jane* 9-10-07

NOT IN PROPER LOCATION BASED ON PROPOSED IMPROVEMENTS SHOWN HEREON WILL BE RELOCATED AT NO EXPENSE TO CLARK COUNTY.

DISCLAIMER NOTE:

UTILITY LOCATIONS SHOWN HEREON ARE APPROXIMATE ONLY. IT SHALL BE THE CONTRACTOR'S RESPONSIBILITY TO DETERMINE THE EXACT HORIZONTAL AND VERTICAL LOCATION OF ALL EXISTING UNDERGROUND OR OVERHEAD UTILITIES PRIOR TO COMMENCING CONSTRUCTION. NO REPRESENTATION IS MADE THAT ALL EXISTING UTILITIES ARE SHOWN HEREON. THE ENGINEER ASSUMES NO RESPONSIBILITY FOR UTILITIES NOT SHOWN OR UTILITIES NOT SHOWN IN THEIR PROPER LOCATION. CONTRACTOR TO NOTIFY ENGINEER OF ANY CHANGES OR DISCREPANCIES.

APPROVALS:

CLARK COUNTY DEPARTMENT OF DEVELOPMENT SERVICES

ACCEPTANCE OF PLANS FOR FILING BY *Mary Jane* 9-10-07

NOT IN PROPER LOCATION BASED ON PROPOSED IMPROVEMENTS SHOWN HEREON WILL BE RELOCATED AT NO EXPENSE TO CLARK COUNTY.

DISCLAIMER NOTE:

UTILITY LOCATIONS SHOWN HEREON ARE APPROXIMATE ONLY. IT SHALL BE THE CONTRACTOR'S RESPONSIBILITY TO DETERMINE THE EXACT HORIZONTAL AND VERTICAL LOCATION OF ALL EXISTING UNDERGROUND OR OVERHEAD UTILITIES PRIOR TO COMMENCING CONSTRUCTION. NO REPRESENTATION IS MADE THAT ALL EXISTING UTILITIES ARE SHOWN HEREON. THE ENGINEER ASSUMES NO RESPONSIBILITY FOR UTILITIES NOT SHOWN OR UTILITIES NOT SHOWN IN THEIR PROPER LOCATION. CONTRACTOR TO NOTIFY ENGINEER OF ANY CHANGES OR DISCREPANCIES.

DISCLAIMER NOTE:


UTILITY LOCATIONS SHOWN HEREON ARE APPROXIMATE ONLY. IT SHALL BE THE CONTRACTOR'S RESPONSIBILITY TO DETERMINE THE EXACT HORIZONTAL AND VERTICAL LOCATION OF ALL EXISTING UNDERGROUND OR OVERHEAD UTILITIES PRIOR TO COMMENCING CONSTRUCTION. NO REPRESENTATION IS MADE THAT ALL EXISTING UTILITIES ARE SHOWN HEREON. THE ENGINEER ASSUMES NO RESPONSIBILITY FOR UTILITIES NOT SHOWN OR UTILITIES NOT SHOWN IN THEIR PROPER LOCATION. CONTRACTOR TO NOTIFY ENGINEER OF ANY CHANGES OR DISCREPANCIES.

APPROVALS:


CLARK COUNTY DEPARTMENT OF DEVELOPMENT SERVICES

ACCEPTANCE OF PLANS FOR FILING BY *Mary Jane* 9-10-07



NOT IN PROPER LOCATION BASED ON PROPOSED IMPROVEMENTS SHOWN HEREON WILL BE RELOCATED AT NO EXPENSE TO CL

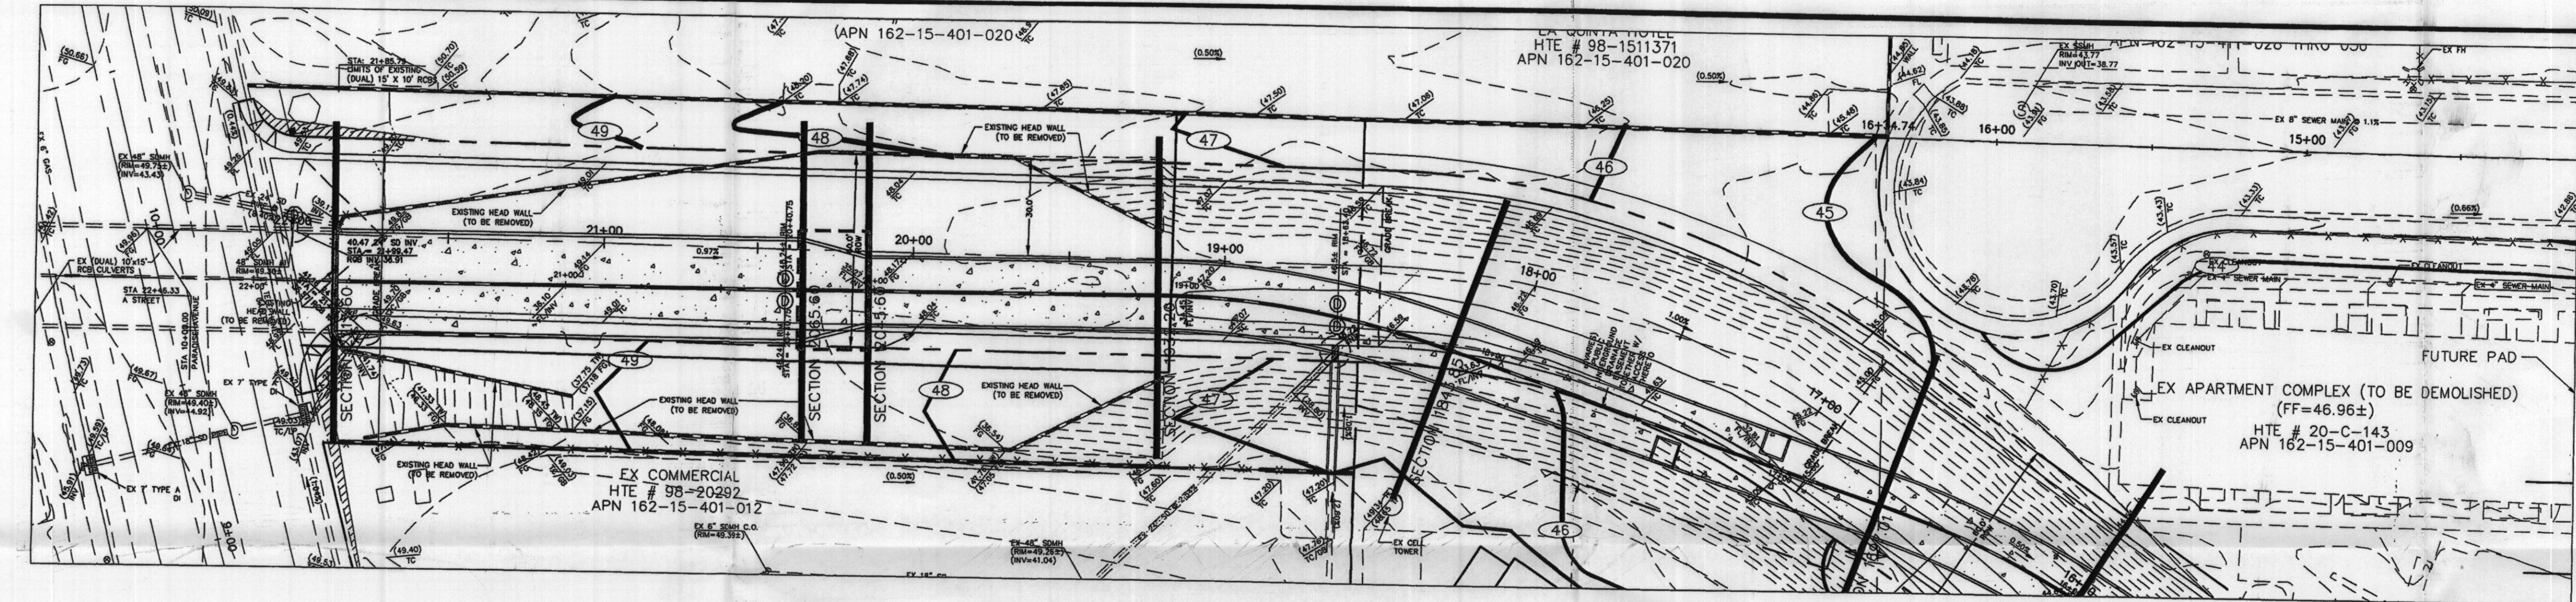

SEE BELOW LEFT

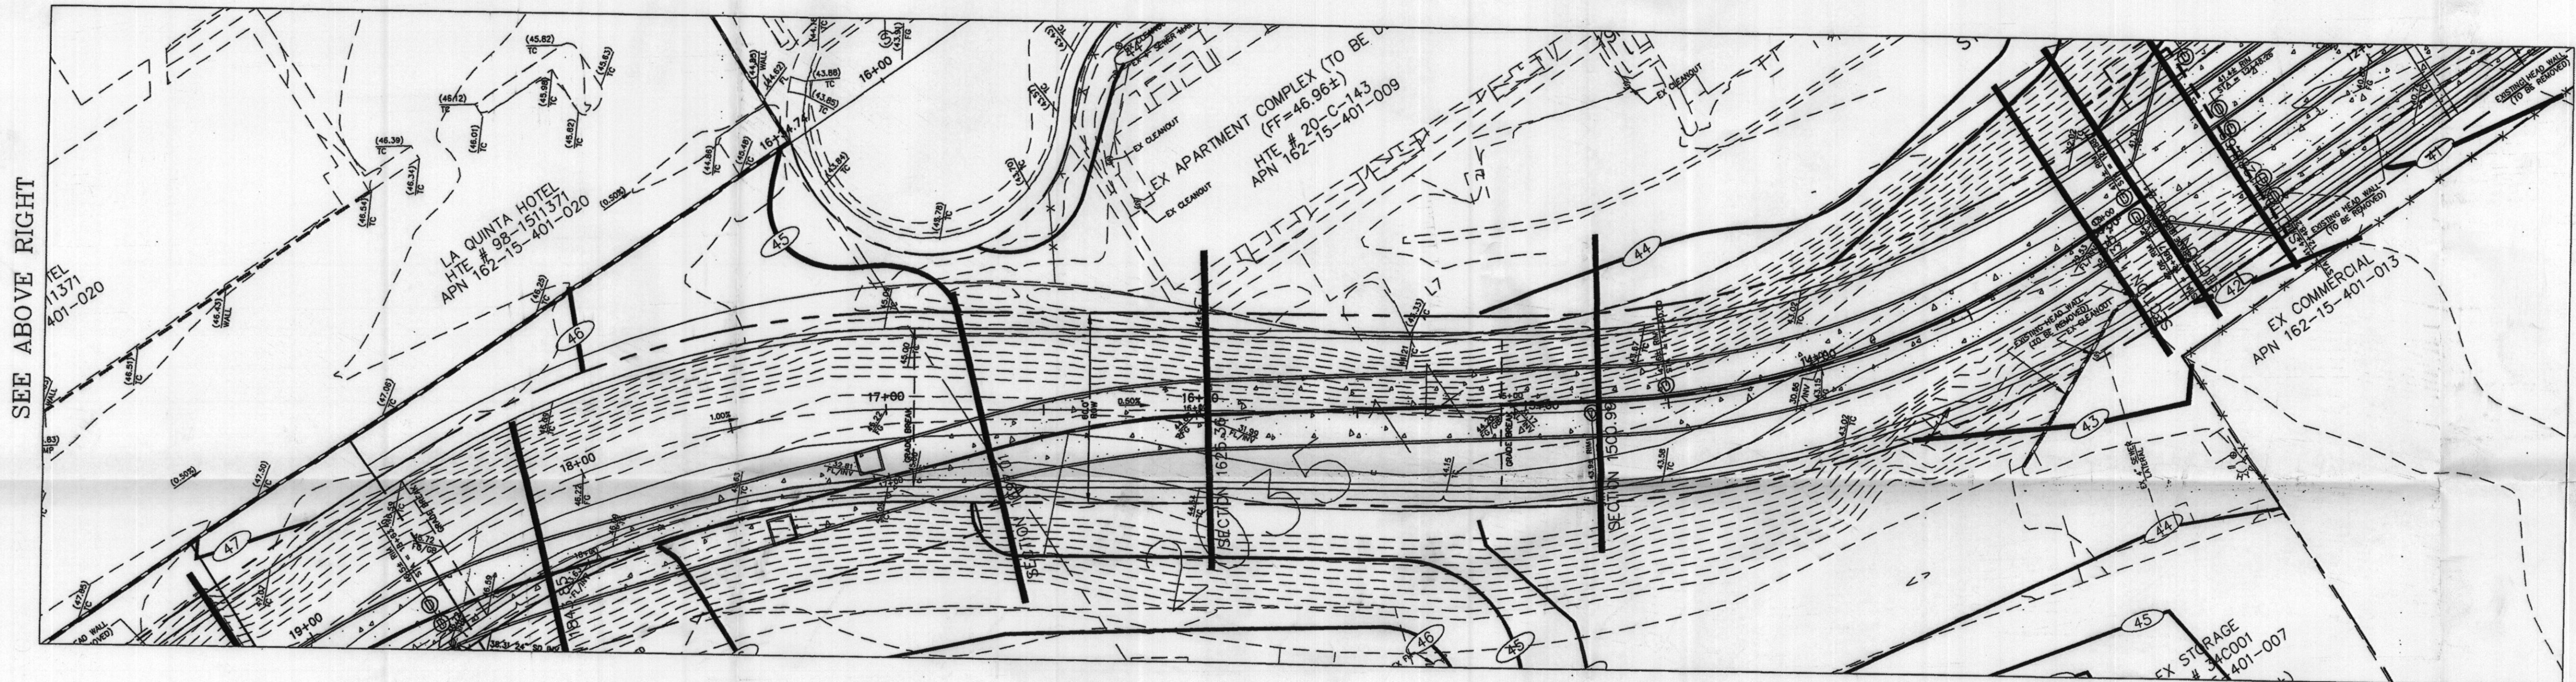

SEE BELOW LEFT

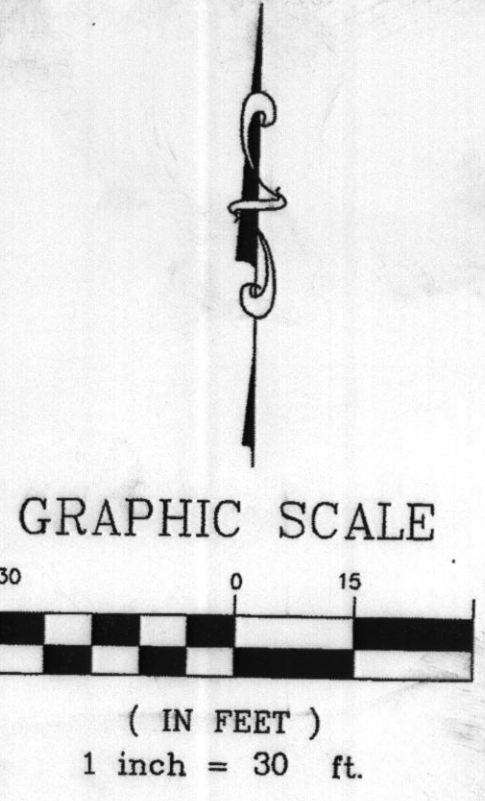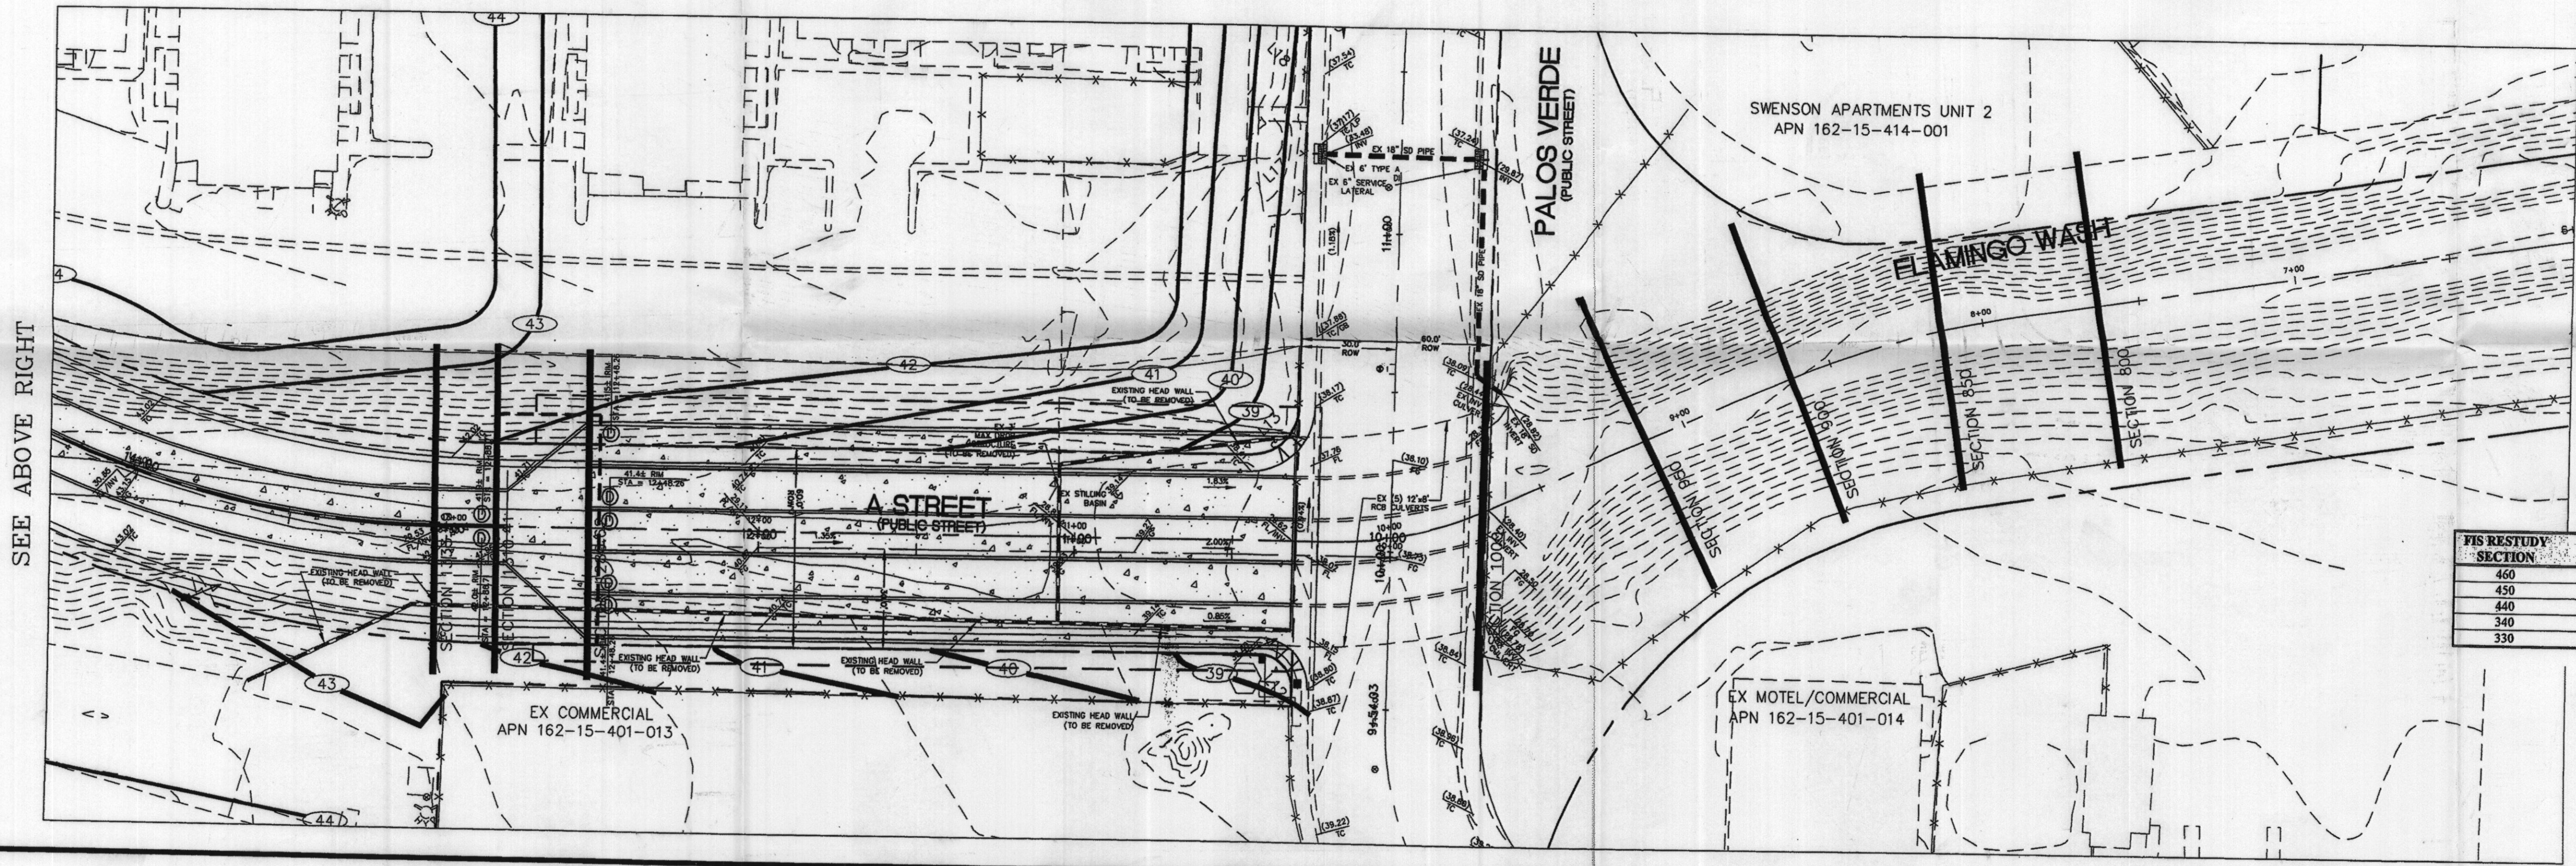

THIS MAP HAS BEEN
REFERENCED FROM
THE APPROVED COMR
CASE NO. 06-09-BC85R

FIS RESTUDY SECTION	EXISTING HEC-RAS SECTION	PROPOSED WSPG SECTION
460	39	4415.16
450	38	4013.55
440	37	3615.60
340	5	610
330	4	195

LAPOUR PARTNERS
3525 S. DECATUR BLVD., SUITE 101
LAS VEGAS, NEVADA 89118
(702) 222-3022

ALPHA 
ENGINEERING COMPANY
3301 N. BURNING DR. STE 200, LAS VEGAS, NV 89129
Telephone: (702) 877-1300

PARADISE VILLAGE

PROPOSED WSPG MODEL

DRAWN BY:	9	10	11
DESIGNED BY:	2		
CHECKED BY:	3		
PROJECT NO:	4	SCALE:	5

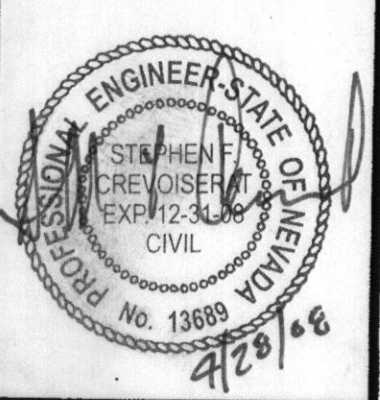


FIGURE
13
DRAWING NO.

05-54297 d/s



3350 W. Cheyenne Avenue, Suite 110
North Las Vegas • Nevada • 89032
Office: 791-3900 • Fax: 631-3909

April 30, 2008
Job No. 07030-03

FEMA
Attention: LOMR Depot
3601 Eisenhower Avenue, Suite 600
Alexandria, VA 22304-6425

Subject: Flamingo Storm Drain System Plan Conformity - Paradise Village Offsite Plans

To Whom It May Concern:

The proposed reinforced box culverts with transition structures for the above referenced project were built in substantial compliance with the approved plans for the Flamingo Wash. A site visit on April 14, 2008, confirmed that the 15' x 10' Reinforced Box Culvert (RCB), transition structure from a dual 15'x10' RCB to dual 12'x9', precast dual 12'x9' RCB, transition from dual 12'x9' RCB to a five (5): 12'x8' RCB (cast-in-place) were constructed per the approved plans of *Paradise Village Offsite Plans*, designed by Alpha Engineering. The upstream tie-in is an existing dual (2): 15' x 10' RCB culvert under Paradise Road crossing (Public Roadway), and the downstream tie-in is the existing five (5): 12'x8' RCB culverts under Palos Verde Road crossing (Public Road).


If you have any questions regarding this letter, please do not hesitate to call our office.

Sincerely,

ROME CONSULTING

A handwritten signature in black ink, appearing to read "James M. Aquino", written over a horizontal line.

James M. Aquino
Principal

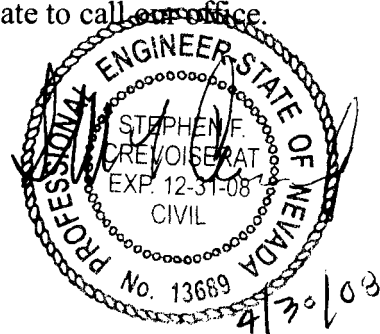

Stephen F. Crevoiserat, P.E.
President

Cc: sfc

APPENDIX I

Data CD